



CITY OF NEW BEDFORD

APPLICATION FOR CONNECTION TO  
PUBLIC SANITARY SEWER AND/OR STORM DRAIN

Application No. 22382

Date 10-13-95

The undersigned hereby requests permission to connect a building sanitary and/or storm sewer from the premises located at ACUSHNET AVE (E) NEC WITH NYES LN, Assessors' Plot 132 H.  
Lot 488, to the public sanitary/storm sewer(s) in ACUSHNET AVE Street;  
the same to be installed in accordance with the terms and conditions set forth herein, and the ordinances of the City of New Bedford.

Name of Property Owner: RAHIM AGHA Tel. 995-5188.  
Please Print

Owner's Mailing Address: 3388 ACUSHNET AVE NB MA 02745

If application is being submitted by other than actual property owner, indicate that person's  
Name: WILLIAM COSTA Tel. 993-8824.  
Mailing Address: 25 MERRYMOUNT DR NO DARTMOUTH MA 02747  
and attach Letter of Authorization from Property Owner hereto.

BONDED CONTRACTOR OR DRAIN LAYER MAKING INSTALLATION

Name: SMITH & Son Tel. 9951449.  
Address: 58 RIDGEWOOD RD NB

JOINT MAINTENANCE AGREEMENT REQUIRED

If this connection is to be part of a private service shared jointly with other building owners, attach copy of Recorded Joint Maintenance Agreement hereto.

PERMITS TO INDUSTRIAL AND/OR COMMERCIAL APPLICANTS

Permits can be issued to Industrial and/or Commercial Applicants only upon receipt and approval by the Commissioner of Public Works of such supplemental information, including drawings, composition and quantity data, and other pertinent information as he may require.

In addition, a valid Industrial User Discharge Permit issued by the City, and a valid Permit for Sewer System Extension or Connection issued by the Commonwealth of Massachusetts, Division of Water Pollution Control, shall be required for applicants wishing to discharge industrial wastes to the City's sewer system.

Industrial User Discharge Permit No. Date

Comm. Mass. Sewer Conn./Ext. Permit No. Date

TERMS

- a) Type of Pipe Required: PVC SDR 35
- b) Separate Sanitary and Storm connections are required where a 2 - pipe system exists in the street.
- c) All work must be inspected and approved by a D.P.W. Inspector, both in the street and on private property, before backfilling.
- d) A Filing and Inspection Fee of \$ 150.00, plus an Entrance Fee of \$ 165.00 where applicable, must accompany this application.
- e) Other requirements: INSP. ONLY SMITH & Son TO DO ALL WORK 220 GPD

Applicant agrees to abide by the above terms, as well as all pertinent ordinances of the City of New Bedford, and such other special rules as the Commissioner of Public Works may deem necessary.

Lawrence D. Dora  
Commissioner of Public Works

Signature of Property Owner

By:

By:

William Costa  
Signature of Owner's Representative

*Sassaquin Medical Associates, Inc.*

*Rahim Aghai, M.D.*

3388 ACUSHNET AVENUE


NEW BEDFORD, MASSACHUSETTS 02745

TELEPHONE (508) 995-5188

October 12, 1995

To Whom It May Concern:

Please be advised that Mr. William Costa has been granted authority to act as my agent in obtaining the necessary permits and contracts involved in providing sewer connections for 3388 Acushnet Avenue, New Bedford, MA 02745.

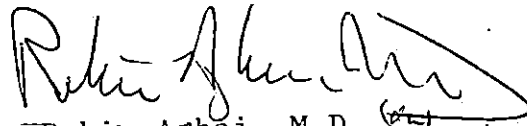


Rahim Aghai, M.D.

DRAIN NO. 22382

OWNER RAHIM AGHA!

- ① MEASURE FRONT OF HOUSE, DISTANCE TO LOT LINE.
- ② MEASURE FROM COR. OF HOUSE TO DRAIN, DISTANCE WHERE DRAIN CROSSES PROPERTY LINE, ENTERS SEWER
- ③ LENGTH OF DRAIN FROM FRONT PROP. LINE TO HOUSE
- ④ SHOW NORTH ARROW.
- ⑤ MEASURE FROM DRAIN TO NEAREST INTERSECTION

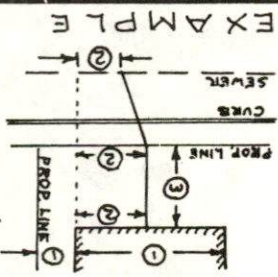

N

#3388

ACUSHNET AVE.

DOOR

DR. RAHIM AGHA!

33' 6" PVC  
\$165  
5.5' DEEP

CURB LINE (IF ANY)

PROP. LINE

103'

SEWER