



CITY OF NEW BEDFORD

APPLICATION FOR CONNECTION TO
PUBLIC SANITARY SEWER AND/OR STORM DRAIN

Application No. 22390

Date 10-23-95

The undersigned hereby requests permission to connect a building sanitary and/or storm sewer from the premises located at ACUSHNET AVE (WS) 120 1/2 S/ FORBES ST., Assessors' Plot 132-1 Lot 36, to the public sanitary/storm sewer(s) in ACUSHNET AVE - Street; the same to be installed in accordance with the terms and conditions set forth herein, and the ordinances of the City of New Bedford.

Name of Property Owner: JOHN F. ALVES Tel. 995-3700
Please Print

Owner's Mailing Address: 3243 ACUSHNET AVE NB MA 02745

If application is being submitted by other than actual property owner, indicate that person's Name: Mailing Address: and attach Letter of Authorization from Property Owner hereto.

-BONDED CONTRACTOR OR DRAIN LAYER MAKING INSTALLATION

Name: FRANCIS DAY Tel. 995-3179
Address: 3244 ACUSHNET AVE NB 02745

JOINT MAINTENANCE AGREEMENT REQUIRED

If this connection is to be part of a private service shared jointly with other building owners, attach copy of Recorded Joint Maintenance Agreement hereto.

PERMITS TO INDUSTRIAL AND/OR COMMERCIAL APPLICANTS

Permits can be issued to Industrial and/or Commercial Applicants only upon receipt and approval by the Commissioner of Public Works of such supplemental information, including drawings, composition and quantity data, and other pertinent information as he may require.

In addition, a valid Industrial User Discharge Permit issued by the City, and a valid Permit for Sewer System Extension or Connection issued by the Commonwealth of Massachusetts, Division of Water Pollution Control, shall be required for applicants wishing to discharge industrial wastes to the City's sewer system.

Industrial User Discharge Permit No. Date
Comm. Mass. Sewer Conn./Ext. Permit No. Date

TERMS

- a) Type of Pipe Required: PVC - SDR 35
b) Separate Sanitary and Storm connections are required where a 2 - pipe system exists in the street.
c) All work must be inspected and approved by a D.P.W. Inspector, both in the street and on private property, before backfilling.
d) A Filing and Inspection Fee of \$ 150.00, plus an Entrance Fee of \$ 130.00 where applicable, must accompany this application.
e) Other requirements: INSPECTION ONLY - FRANCIS DAY TO DO ALL WORK - TO BE CONNECTED TO STUB AT PROPERTY LINE - 220 GPD

Applicant agrees to abide by the above terms, as well as all pertinent ordinances of the City of New Bedford, and such other special rules as the Commissioner of Public Works may deem necessary.

Commissioner of Public Works


Signature of Property Owner

By: [Signature]

By: [Signature]
Signature of Owner's Representative

DRAIN NO. 22390OWNER JOHN ALVES

- ① MEASURE FRONT OF HOUSE, DISTANCE TO LOT LINE.
- ② MEASURE FROM COR. OF HOUSE TO DRAIN, DISTANCE WHERE DRAIN CROSSES PROPERTY LINE, ENTERS SEWER.
- ③ LENGTH OF DRAIN FROM FRONT PROP. LINE TO HOUSE
- ④ SHOW NORTH ARROW.
- ⑤ MEASURE FROM DRAIN TO NEAREST INTERSECTION

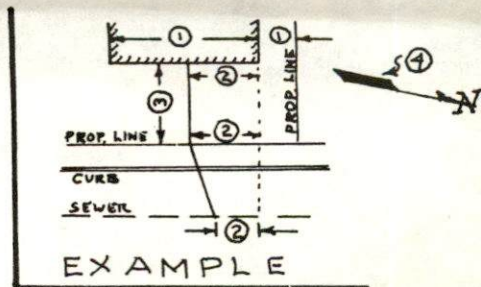

26' 6" PVC
\$130
8' DEEP

JOHN F. ALVES

#3243
ACUSHNET
AVE.

PORCH

32'

45'

PROP. LINE

CURB LINE (IF ANY)

92'

SEWER