



PERMIT NO.
23055

CITY OF NEW BEDFORD

DATE 3/15/2001

SEWER AND/OR STORM DRAIN PERMIT

This certifies that permission is granted to

Arthur Silva 1151 SAWYER ST. NEW BEDFORD, MA 01905
Property Owner Address Tel.

to connect a sewer and/or storm drain located at 1151 SAWYER ST.
Assessor's Plot 87, Lot 27, to the sewer and/or storm drain in SAWYER ST. Street

to be laid in accordance with the conditions in this application and the City of New Bedford ordinances.

TYPE OF USE: ☒ RESIDENTIAL ☐ COMMERCIAL ☐ INDUSTRIAL ☐ OTHER

If applicant other than actual property owner, attach Letter of Authorization from Property Owner

Name: Tel: 220 GPD
AUG - 8 2001

Mailing Address:

The Bonded Contractor/Drain Layer authorized to perform this work is:
August Backhoe Service 324 Bridge St. Fairhaven, MA 01934

Name Address Tel.

Type of Pipe Required: PVC SDR-35
PERMIT EXPIRES ONE YEAR AFTER DATE OF ISSUE

- * Requires separate connections for sewage and storm drain where applicable. Storm water cannot be discharged to a sanitary sewer.
- * All work must be inspected and approved by a D.P.W. inspector before backfilling.
- * If this connection is to be part of a private service shared jointly with other building owners, attach copy of Recorded Joint Maintenance Agreement.
- * Permits can be issued to Industrial and/or Commercial Applicants only upon receipt and approval by the Commissioner of Public Works of required plans and supplemental information.
- * In addition, a City-issued Industrial User Discharge Permit and/or a Sewer Extension/Connection Permit issued by the Commonwealth of Massachusetts D.E.P. shall be required by the City for Industrial Discharge into the sewer system.

Industrial User Discharge Permit No. Date

Comm. Mass. Sewer Conn./Ext. Permit No. Date

A Filing and Inspection Fee of \$150.00, plus an Entrance Fee of \$382.20, where applicable, must accompany this application.

Bank # Compass Back Check # 1972 Date: 3/15/01 Receipt # 3945

Other requirements: Insp. Only - Stub at Prop. Line - Sawyer St.

Rowe St. Proj. - Stub Cost 241 x 14.70 L.F. = 3522.20 + \$150.00 Insp. Fee Total 532.20

Connection made to ☒ Sewer ☐ Storm Drain
Part of jointly-shared private line ☐ Yes ☒ No

Applicant agrees to abide by the above terms, as well as all pertinent ordinances of the City of New Bedford, and such other special rules as the Commissioner of Public Works may deem necessary

Laurence D. Warden, Jr.
Commissioner of Public Works

Signature of Property Owner or Representative

INSPECTED BY: Peter Sureski


DATE: 4/24/01

COMMENTS: [Cdr inspected from main to Prop. Line - Rowe St. Sewer project.]

APPROVED ☐ DISAPPROVED

SIGNATURE: [Signature]

ROWE ST.
SKETCH PLAN

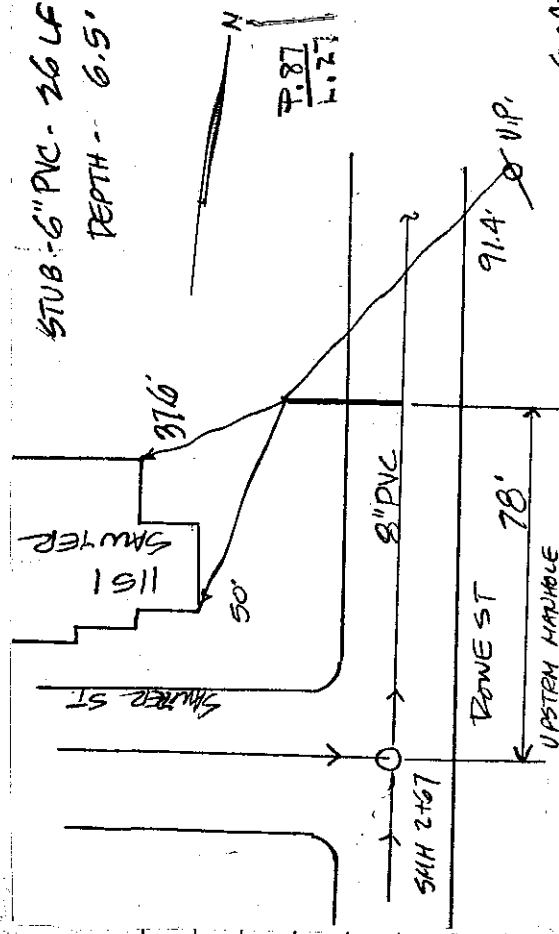



PERMIT NO.
23055

CITY OF NEW BEDFORD
SEWER AND/OR STORM DRAIN PERMIT

DATE 3/15/2001

This certifies that permission is granted to

Arthur Silva 1151 SAWYER ST. NEW BEDFORD, MA 01905
Property Owner Address Tel.

to connect a sewer and/or storm drain located at 1151 SAWYER ST. Street
Assessor's Plot 87, Lot 27, to the sewer and/or storm drain in SAWYER ST.

to be laid in accordance with the conditions in this application and the City of New Bedford ordinances.

TYPE OF USE: ☒ RESIDENTIAL ☐ COMMERCIAL ☐ INDUSTRIAL ☐ OTHER

If applicant other than actual property owner, attach Letter of Authorization from Property Owner.

220 GPD
RECEIVED

Name: Tel. AUG - R 7001

Mailing Address: DEPT. OF PUBLIC WORKS
NEW BEDFORD, MASS

The Bonded Contractor/Drain Layer authorized to perform this work is:

August Backhoe Service 324 Bridge St. Fairhaven, MA 01934
Name Address Tel. 996-3599

Type of Pipe Required: PVC SDR-35
PERMIT EXPIRES ONE YEAR AFTER DATE OF ISSUE

- * Requires separate connections for sewage and storm drain where applicable. Storm water cannot be discharged to a sanitary sewer.
- * All work must be inspected and approved by a D.P.W. inspector before backfilling.
- * If this connection is to be part of a private service shared jointly with other building owners, attach copy of Recorded Joint Maintenance Agreement.
- * Permits can be issued to Industrial and/or Commercial Applicants only upon receipt and approval by the Commissioner of Public Works of required plans and supplemental information.
- * In addition, a City-issued Industrial User Discharge Permit and/or a Sewer Extension/Connection Permit issued by the Commonwealth of Massachusetts D.E.P. shall be required by the City for Industrial Discharge into the sewer system.

Industrial User Discharge Permit No. Date.

Comm. Mass. Sewer Conn./Ext. Permit No. Date.

A Filing and Inspection Fee of \$150.00, plus an Entrance Fee of \$382.20, where applicable, must accompany this application.

Bank # Compass Bank Check # 1972 Date: 3/15/01 Receipt # 3945

Other requirements: Insp. Only - Stub at Prop. Line - Sawyer St.

Rowe St. Proj. - Stub Cost: 241 x \$4.70 L.F. = \$1132.80 + \$150.00 Insp. Fee Total 532.80

☒ Sewer

Connection made to

☐ Storm Drain

Part of jointly-shared private line ☐ Yes ☒ No

FOR INSPECTION ONLY, A 24 HOUR
NOTICE IS REQUIRED AND THE
CONTRACTOR/APPLICANT IS
REQUIRED TO NOTIFY THE
WASTEWATER DIVISION AT 991-6158

Applicant agrees to abide by the above terms, as well as all pertinent ordinances of the City of New Bedford, and such other special rules as the Commissioner of Public Works may deem necessary

Lawrence P. Warden, Jr.
Commissioner of Public Works

Signature of Property Owner or Representative

INSPECTED BY: Peter Sorensen

DATE: 4/24/01

COMMENTS: [Copy inspection from


Main to Rowe Line - Rowe St.

Sewer project.]

☒ APPROVED ☐ DISAPPROVED

Signature: [Signature]

SIGNATURE

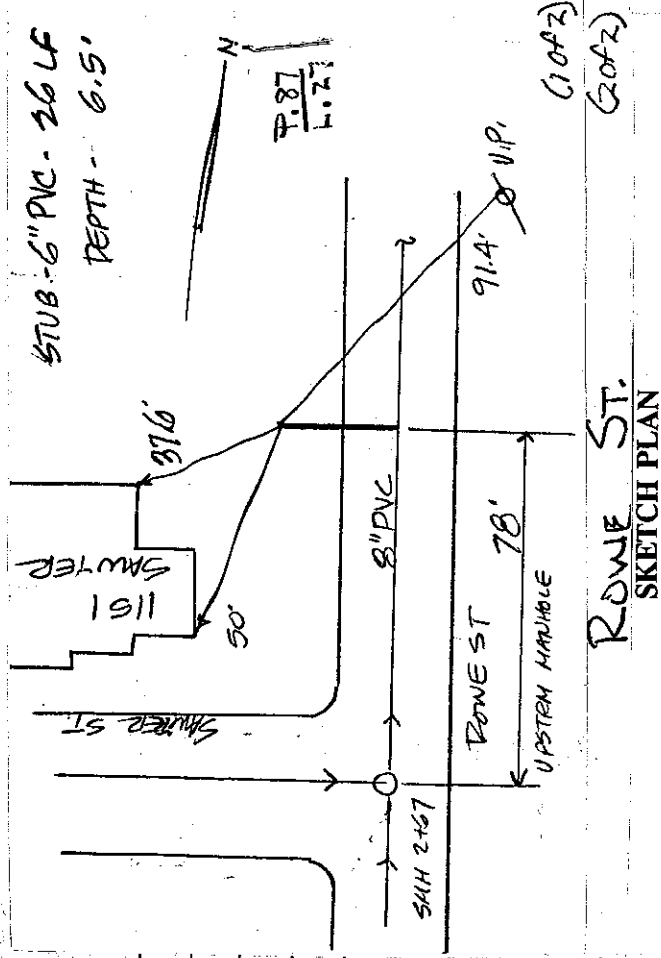



PERMIT NO.
23055

CITY OF NEW BEDFORD

DATE 3/15/2001

SEWER AND/OR STORM DRAIN PERMIT

This certifies that permission is granted to

Arthur Silva 1151 SAWYER ST. NEW BEDFORD MA 01904-6085
Property Owner Address Tel.

to connect a sewer and/or storm drain located at SAWYER ST.
Assessor's Plot 87, Lot 27, to the sewer and/or storm drain in SAWYER ST. Street

to be laid in accordance with the conditions in this application and the City of New Bedford ordinances.

TYPE OF USE: ☒ RESIDENTIAL ☐ COMMERCIAL ☐ INDUSTRIAL ☐ OTHER 220 GPD

If applicant other than actual property owner, attach Letter of Authorization from Property Owner.

Name Tel.

Mailing Address

The Bonded Contractor/Drain Layer authorized to perform this work is:

August Backbee Service 324 Bridge St. Fairhaven MA 01934-3599
Name Address Tel.

Type of Pipe Required: PVC SDR-35
PERMIT EXPIRES ONE YEAR AFTER DATE OF ISSUE

* Requires separate connections for sewage and storm drain where applicable. Storm water cannot be discharged to a sanitary sewer.

* All work must be inspected and approved by a D.P.W. inspector before backfilling.

* If this connection is to be part of a private service shared jointly with other building owners, attach copy of Recorded Joint Maintenance Agreement.

* Permits can be issued to Industrial and/or Commercial Applicants only upon receipt and approval by the Commissioner of Public Works of required plans and supplemental information.

* In addition, a City-issued Industrial User Discharge Permit and/or a Sewer Extension/Connection Permit issued by the Commonwealth of Massachusetts D.E.P. shall be required by the City for Industrial Discharge into the sewer system.

Industrial User Discharge Permit No. Date

Comm. Mass. Sewer Conn./Ext. Permit No. Date

A Filing and Inspection Fee of \$150.00, plus an Entrance Fee of \$352.20, where applicable, must accompany this application.

Bank # Compass Bank Check # 1972 Date 3/15/01 Receipt # 3945

Other requirements: Insp. Only - Sub. at Prop. Line - Sawyer St.

Recess St. Proj. - Sub. Cost 241 x 14.70 LF = 3522.20 + 150.00 Insp. Fee Total 532.20

Connection made to ☒ Sewer ☐ Storm Drain Part of jointly-shared private line ☐ Yes ☒ No

FOR INSPECTION ONLY, A 24 HOUR NOTICE IS REQUIRED AND THE CONTRACTOR/APPLICANT IS REQUIRED TO NOTIFY THE WASTEWATER DIVISION AT 991-6158

Applicant agrees to abide by the above terms, as well as all pertinent ordinances of the City of New Bedford, and such other special rules as the Commissioner of Public Works may deem necessary

Lawrence D. Warden, Jr.
Commissioner of Public Works

Signature of Property Owner or Representative

INSPECTOR'S REPORT

INSPECTED BY:

DATE:


COMMENTS:

☐ APPROVED ☐ DISAPPROVED

SIGNATURE

31-746

SKETCH PLAN

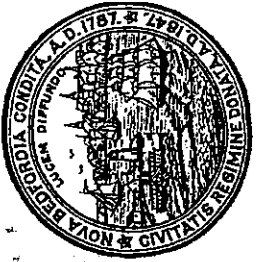

**CITY OF NEW BEDFORD
MASSACHUSETTS**

ENGINEERING DEPARTMENT
133 WILLIAM STREET, ROOM 303
NEW BEDFORD, MA 02740
Tel: 508-979-1527
Fax: 508-961-3043

Date: 5/12/04

To Whom it May Concern:

This is to notify the _____ Department that a sewer connection
permit has been issued for the following address:

Permit No. 23055
Owner(s) Name: Arthur Silva
Location: 1151 Sawyer St.
Plot/Lot: P. 87 / L. 27
Date: 3/15/2001
Completion Date: 4/24/2001

If you should have any further questions or concerns, please feel free to contact me at 508-979-1528.

Sincerely,

Duarte M. Andrade

Duarte M. Andrade
Acting City Engineer