



PERMIT NO. 23056

**CITY OF NEW BEDFORD**  
**SEWER AND/OR STORM DRAIN PERMIT**

DATE..... 3/6/03

**This certifies that permission is granted to**

Property Owner.

Address ~~44~~ 269

Tel.

to connect a sewer and/or storm drain located at.

Assessor's Plot: 30 Lot: 17 to the sewer and/or storm drain in: 111111

Street

to be laid in accordance with the conditions in this application and the City of New Bedford ordinances.

TYPE OF USE: ☒ RESIDENTIAL ☐ COMMERCIAL ☐ INDUSTRIAL ☐ OTHER

If applicant other than actual property owner, attach Letter of Authorization from Property Owner.

Name..... Tel.....

**Mailing Address:**

MAILING ADDRESS.....  
 Brooklyn, N.Y.

The Bonded Contractor/Drain Layer authorized to perform this work is:

DEPT. OF PUBLIC WORKS  
NEW BEDFORD, MASS

Name

## Address

Tel. 333-1111

Type of Pipe Required:

**PERMIT EXPIRES ONE YEAR AFTER DATE OF ISSUE**

- \* Requires separate connections for sewage and storm drain where applicable. Storm water cannot be discharged to a sanitary sewer.
- \* All work must be inspected and approved by a D.P.W. inspector before backfilling.
- \* If this connection is to be part of a private service shared jointly with other building owners, attach copy of Recorded Joint Maintenance Agreement.
- \* Permits can be issued to Industrial and/or Commercial Applicants only upon receipt and approval by the Commissioner of Public Works of required plans and supplemental information.
- \* In addition, a City-issued Industrial User Discharge Permit and/or a Sewer Extension/Connection Permit issued by the Commonwealth of Massachusetts D.E.P. shall be required by the City for Industrial Discharge into the sewer system.

Industrial User Discharge Permit No. .... Date. ....

Comm. Mass. Sewer Conn./Ext. Permit No. .... Date.....

A Filing and Inspection Fee of \$600....., plus an Entrance Fee of \$400....., where applicable, must accompany this application.

[illegible]

Other requirements: DR. RICHARD M. GILLES



**Sewer**

Connection made to

## Storm Drain

Part of jointly-shared private line ☐ Yes ☒ No

**Applicant agrees to abide by the above terms, as well as all pertinent ordinances of other special rules as the Commissioner of Public Works may deem necessary.**

# Commissioner of Public Works

**Signature of Property Owner or Representative**

INSPECTED BY:

DATE: 4/3/61

COMMENTS: This installed as per of House St. Sewer project and inspected by Cdm. Peter Davis. inspected from R to house. when connected to Sewer.

☒ APPROVED ☐ DISAPPROVED

**SIGNATURE**

WILBUR ST.  
SKETCH PLAN

(10-12)

 $(z, f(z))$ 

31-746



PERMIT NO.  
23056

CITY OF NEW BEDFORD  
SEWER AND/OR STORM DRAIN PERMIT

DATE 3/21/01  
EXP. 3/21/02

This certifies that permission is granted to

Michael F. & Leona M. Rockwell 769 Wilbur St. New Bedford MA 02740  
Property Owner Address # 269 Tel. (508) 460-2732  
to connect a sewer and/or storm drain located at Wilbur St. (N.S.) 460 W. Rockdale Ave.  
Assessor's Plot 80, Lot 17, to the sewer and/or storm drain in Wilbur Street

to be laid in accordance with the conditions in this application and the City of New Bedford ordinances.

TYPE OF USE: ☒ RESIDENTIAL ☐ COMMERCIAL ☐ INDUSTRIAL ☐ OTHER 440 CPD

If applicant other than actual property owner, attach Letter of Authorization from Property Owner.

Name NA/A Tel. ....

Mailing Address .....

The Bonded Contractor/Drain Layer authorized to perform this work is:

W.C. Smith & Sons, Inc. 58 Kedge Road Rd. New Bedford MA 02745  
Name Address Tel. 993-1449

Type of Pipe Required: PVC SDR 35  
PERMIT EXPIRES ONE YEAR AFTER DATE OF ISSUE .....

\* Requires separate connections for sewage and storm drain where applicable. Storm water cannot be discharged to a sanitary sewer.

\* All work must be inspected and approved by a D.P.W. inspector before backfilling.

\* If this connection is to be part of a private service shared jointly with other building owners, attach copy of Recorded Joint Maintenance Agreement.

\* Permits can be issued to Industrial and/or Commercial Applicants only upon receipt and approval by the Commissioner of Public Works of required plans and supplemental information.

\* In addition, a City-issued Industrial User Discharge Permit and/or a Sewer Extension/Connection Permit issued by the Commonwealth of Massachusetts D.E.P. shall be required by the City for Industrial Discharge into the sewer system.

Industrial User Discharge Permit No. .... Date .....

Comm. Mass. Sewer Conn./Ext. Permit No. .... Date .....

A Filing and Inspection Fee of \$ 150 ....., plus an Entrance Fee of \$ 352.80 ....., where applicable, must accompany this application.

Bank # Rel. Workers Credit Union Check # 3142 Date: 3/21/01 Receipt # 3949

Other requirements: Inspection Only - Sub at R. - New St. Sewer Proj. - Sub (lost)  
24' x 14.70 ft = \$352.80 + \$150.00 Sewer Permit = \$502.80 Total  
Must verify Health Dept. re: Septic System abandonment

Connection made to

☐ Storm Drain

Part of jointly-shared private line ☐ Yes ☒ No

FOR INSPECTION ONLY, A 24 HOUR  
NOTICE IS REQUIRED AND THE  
CONTRACTOR/APPLICANT IS  
REQUIRED TO NOTIFY THE  
WASTEWATER DIVISION AT 991-6151

Applicant agrees to abide by the above terms, as well as all pertinent ordinances of the City of New Bedford and other special rules as the Commissioner of Public Works may deem necessary

Lawrence D. Warden (M)  
Commissioner of Public Works

A. Michael  
Signature of Property Owner or Representative

INSPECTOR'S REPORT

INSPECTED BY: \_\_\_\_\_

DATE: \_\_\_\_\_

COMMENTS: \_\_\_\_\_

\_\_\_\_\_  
\_\_\_\_\_  
\_\_\_\_\_  
\_\_\_\_\_

☐ APPROVED ☐ DISAPPROVED

SIGNATURE

DRAIN

Permit

No. ....

Enters

Drain Plot No. ....

From Property of .....


WILBUR ST (#269) NORTH SIDE


WILBUR ST

STUB 6" PVC - 24'  
DEPTH - 7'

P80  
LIT

269  
WILBUR

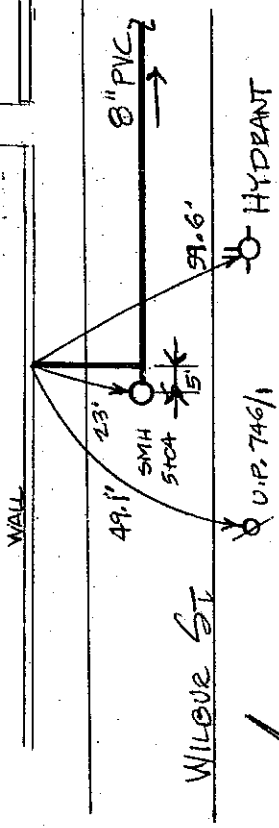

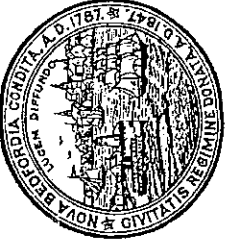

## MASSACHUSETTS

DEPARTMENT OF PUBLIC WORKS  
ENGINEERING DIVISION  
133 WILLIAM STREET, ROOM 303  
NEW BEDFORD, MA 02740  
Tel: (508) 979-1527  
Fax: (508) 961-3043

LAWRENCE D. WORDEN  
COMMISSIONER

December 27, 2000

Attn: Michael F. & Leona M. Pacheco  
269 Wilbur St.  
New Bedford, MA 02740

Re: Rowc Street Sewer Project Area--Properties Located Within Isolated Portions of the Sewer System Which Have Been Approved and Are Presently Operational

This letter serves as notification to you that the following property may now connect to the sewer system:


|                                |                                |
|--------------------------------|--------------------------------|
| Owner(s):                      | Pacheco, Michael F. & Leona M. |
| Location:                      | 269 Wilbur St.                 |
| Plot/Lot:                      | 80/17                          |
| Service Pipe Length Installed: | 24                             |
| Total Cost of Service Line:    | \$352.80                       |

In addition to the cost of the service line provided for the property, which the property owner must reimburse the City for when ready to connect to the sewer system, there is also a "Sewer Permit" fee of \$150.00. Once ready to connect to the sewer system, the property owner must come to City Hall, D.P.W. Engineering office, Room 303, to obtain said permit, at which time both of these amounts are due to the City. If someone other than the property owner is going to obtain the permit, this person must have a signed permission slip from the property owner allowing the entity to sign on behalf of the property owner. Also, if the property owner is abandoning a septic system, they must make arrangements with the Health Department at (508) 991-6273.

The City has brought the sewer service pipe to your property line. The property owner is responsible for making the provisions for any work required and costs incurred on their property. Property owners should make sure that the contractor they hire knows that, although they are working on private property, the D.P.W. Waste Water Division, and possibly other City officials, must inspect all work done before the sewer trench is backfilled.

Should you have any questions or need additional information, please feel free to contact Ana Rosa or Mario Gomes in the Engineering Department at (508) 979-1527.

Sincerely,

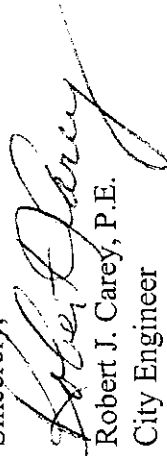  
Robert J. Carey, P.E.  
City Engineer

RJC/asr