



PERMIT NO.
23057

CITY OF NEW BEDFORD
SEWER AND/OR STORM DRAIN PERMIT

DATE 3/21/01
EXP 3/21/02

This certifies that permission is granted to

Property Owner Henry V. Satterman Address 1311 Rockdale Ave. New Bedford, MA 02740
to connect a sewer and/or storm drain located at Rockdale Ave. (A.B.I.) (U.S.) 115' S. Harding St.
Assessor's Plot 20, Lot 38, to the sewer and/or storm drain in Rockdale Ave. Street

to be laid in accordance with the conditions in this application and the City of New Bedford ordinances.

TYPE OF USE: ☒ RESIDENTIAL ☐ COMMERCIAL ☐ INDUSTRIAL ☐ OTHER

If applicant other than actual property owner, attach Letter of Authorization from Property Owner

RECEIVED

Name ALLA Tel. 9933206 (H)

Mailing Address

AUG 14 2001

The Bonded Contractor/Drain Layer authorized to perform this work is:

DEPT. OF PUBLIC WORKS

NEW BEDFORD, MASS

J.P.P. Plumbing & John A. May 790 W. W. Adams 998-8871
Name Address Tel.

Type of Pipe Required: PVC 30" SD 35
PERMIT EXPIRES ONE YEAR AFTER DATE OF ISSUE

- * Requires separate connections for sewage and storm drain where applicable. Storm water cannot be discharged to a sanitary sewer.
- * All work must be inspected and approved by a D.P.W. inspector before backfilling.
- * If this connection is to be part of a private service shared jointly with other building owners, attach copy of Recorded Joint Maintenance Agreement.
- * Permits can be issued to Industrial and/or Commercial Applicants only upon receipt and approval by the Commissioner of Public Works of required plans and supplemental information.
- * In addition, a City-issued Industrial User Discharge Permit and/or a Sewer Extension/Connection Permit issued by the Commonwealth of Massachusetts D.E.P. shall be required by the City for Industrial Discharge into the sewer system.

Industrial User Discharge Permit No. Date

Comm. Mass. Sewer Conn./Ext. Permit No. Date

A Filing and Inspection Fee of \$570.00, plus an Entrance Fee of \$308.70 where applicable, must accompany this application.

Bank # Fleet Check # 1391 Date 3/21/01 Receipt # 5851

Other requirements: Inspection Only - Stub at R. N. D. Sewer 190' S. Harding St. 54' 6" →

21' X \$14.70/LF = \$308.70 + Sewer Permit = \$150.00

Total: \$458.70 Owner must attach Health Dept. Sewer vs. Septic System Connection Form

Connection made to ☐ Storm Drain ☒ Part of jointly-shared private line ☐ Yes ☒ No

FOR INSPECTION ONLY, A 24 HOUR NOTICE IS REQUIRED AND THE CONTRACTOR/APPLICANT IS REQUIRED TO NOTIFY THE WASTEWATER DIVISION AT 991-6158

Applicant agrees to abide by the above terms, as well as all pertinent ordinances of the City of New Bedford, and such other special rules as the Commissioner of Public Works may deem necessary

Lawrence D. Worden MA

Commissioner of Public Works

Henry V. Satterman
Signature of Property Owner or Representative

INSPECTED BY: JOSEPH MARTIN

DATE: 5/29/01

COMMENTS: [Inspected by CDM

from main to prop. line - from

St. Sewer project.]


☒ APPROVED ☐ DISAPPROVED

Joseph Martin
SIGNATURE

(1 of 2)

ROCKDALE AVE.
SKETCH PLAN

(2 of 2)

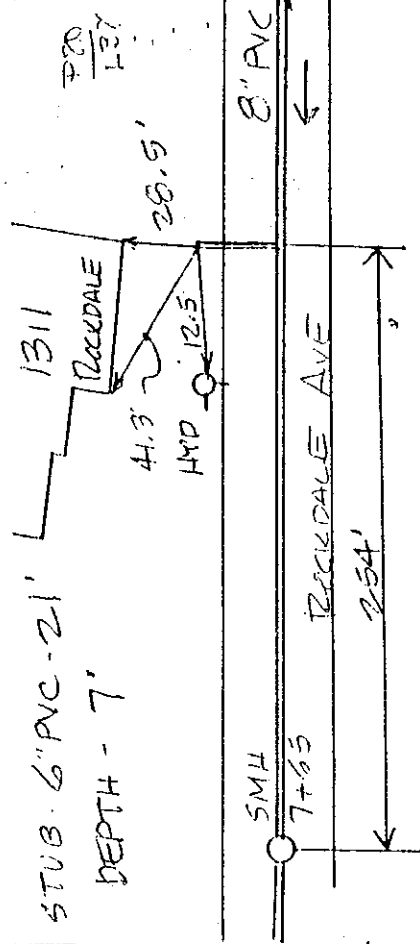



PERMIT NO.
23057

CITY OF NEW BEDFORD
SEWER AND/OR STORM DRAIN PERMIT

DATE 3/21/01
EXP 3/21/02

This certifies that permission is granted to

Property Owner Herry V. Sattzman Address 1311 Rockdale Ave. New Bedford, MA 02740
to connect a sewer and/or storm drain located at Rockdale Ave. (#1311) (U.S.) 145' S. Gardner St.
Assessor's Plot 80, Lot 38, to the sewer and/or storm drain in Rockdale Ave. Street

to be laid in accordance with the conditions in this application and the City of New Bedford ordinances.

TYPE OF USE: ☒ RESIDENTIAL ☐ COMMERCIAL ☐ INDUSTRIAL ☐ OTHER

If applicant other than actual property owner, attach Letter of Authorization from Property Owner.

Name MVA Tel. 9933206 (H-)

Mailing Address 330 GPD

The Bonded Contractor/Drain Layer authorized to perform this work is:

T & R Plumbing & John Ashby 7 Negro Way N. Dart. 998-8871
Name JWC SDR 35 Address MA 02747 Tel.

Type of Pipe Required PVC SDR 35
PERMIT EXPIRES ONE YEAR AFTER DATE OF ISSUE

* Requires separate connections for sewage and storm drain where applicable. Storm water cannot be discharged to a sanitary sewer.

* All work must be inspected and approved by a D.P.W. inspector before backfilling.

* If this connection is to be part of a private service shared jointly with other building owners, attach copy of Recorded Joint Maintenance Agreement.

* Permits can be issued to Industrial and/or Commercial Applicants only upon receipt and approval by the Commissioner of Public Works of required plans and supplemental information.

* In addition, a City-issued Industrial User Discharge Permit and/or a Sewer Extension/Connection Permit issued by the Commonwealth of Massachusetts D.E.P. shall be required by the City for Industrial Discharge into the sewer system.

Industrial User Discharge Permit No. --- Date ---

Comm. Mass. Sewer Conn./Ext. Permit No. --- Date ---

A Filing and Inspection Fee of \$150.00., plus an Entrance Fee of \$308.70 where applicable, must accompany this application.

Bank # Fleet Check # 1391 Date 3/21/01 Receipt # 3951

Other requirements: Inspection Only - Stub at R. ~ Rock St. Sewer Proj. : Stub ->

2' X \$14.70/H = \$308.70 + Sewer Permit: -> \$150.00
Total: -> \$458.70 Owner must attach Health Dept.

Connection made to ☒ Sewer re: Synthetic. SDR 35 standard Part of jointly-shared private line ☐ Yes ☒ No

☐ Storm Drain

FOR INSPECTION ONLY, A 24 HOUR
NOTICE IS REQUIRED AND THE
CONTRACTOR/APPLICANT IS
REQUIRED TO NOTIFY THE
WASTEWATER DIVISION AT 991-6158

Applicant agrees to abide by the above terms, as well as all pertinent ordinances of the City of New Bedford, and such other special rules as the Commissioner of Public Works may deem necessary

Lawrence D. Warden MA
Commissioner of Public Works


Henry V. Sattzman
Signature of Property Owner or Representative

INSPECTOR'S REPORT

INSPECTED BY: _____
DATE: _____
COMMENTS: _____

☐ APPROVED ☐ DISAPPROVED

SIGNATURE
31-746

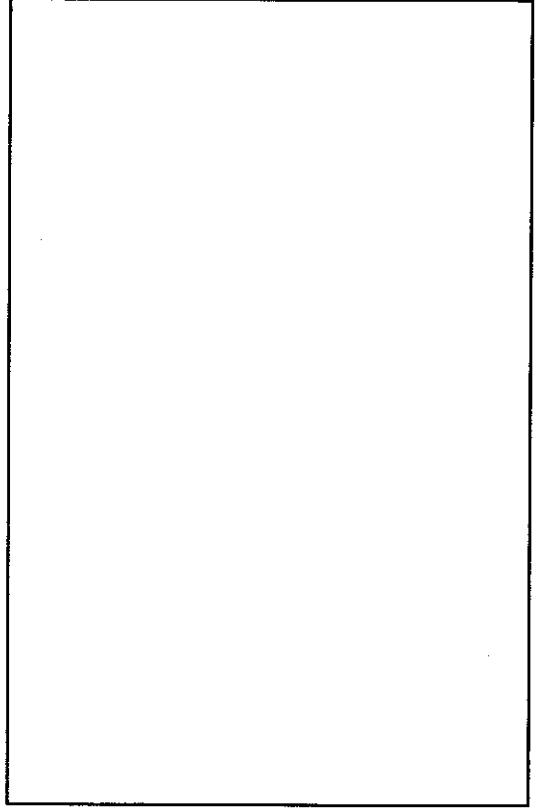

SKETCH PLAN

DRAIN

6

Permit

No.

Enters

Drain Plot No.

From Property of

ROCKDALE AVE (#1311) WEST SIDE

ROCKDALE AVE

STUB 6" PVC - 21'

DEPTH - 7'

1311

ROCKDALE

41.3'

HYD

12.5'

28.5'

$\frac{720}{137}$

SMH

7+63

8" PVC

ROCKDALE AVE

254'

N



CITY OF NEW BEDFORD MASSACHUSETTS

DEPARTMENT OF PUBLIC WORKS
ENGINEERING DIVISION
133 WILLIAM STREET, ROOM 303
NEW BEDFORD, MA 02740

Tel: (508) 979-1527
Fax: (508) 961-3043

LAWRENCE D. WORDEN
COMMISSIONER

December 27, 2000

Attn: Henry V. Saltzman
1311 Rockdale Ave.
New Bedford, MA 02740

Re: Rowe Street Sewer Project Area--Properties Located Within Isolated Portions of the Sewer
System Which Have Been Approved and Are Presently Operational

This letter serves as notification to you that the following property may now connect to the sewer system:


Owner(s):	Saltzman, Henry V.
Location:	1311 Rockdale Ave.
Plot/Lot:	80/38
Service Pipe Length Installed:	21
Total Cost of Service Line:	\$308.70

In addition to the cost of the service line provided for the property, which the property owner must reimburse the City for when ready to connect to the sewer system, there is also a "Sewer Permit" fee of \$150.00. Once ready to connect to the sewer system, the property owner must come to City Hall, D.P.W. Engineering office, Room 303, to obtain said permit, at which time both of these amounts are due to the City. If someone other than the property owner is going to obtain the permit, this person must have a signed permission slip from the property owner allowing the entity to sign on behalf of the property owner. Also, if the property owner is abandoning a septic system, they must make arrangements with the Health Department at (508) 991-6273.

The City has brought the sewer service pipe to your property line. The property owner is responsible for making the provisions for any work required and costs incurred on their property. Property owners should make sure that the contractor they hire knows that, although they ~~are~~ are working on private property, the D.P.W. Waste Water Division, and possibly other City officials, must inspect all work done before the sewer trench is backfilled.

Should you have any questions or need additional information, please feel free to contact Ana Rosa or Mario Gomes in the Engineering Department at (508) 979-1527.

Sincerely,

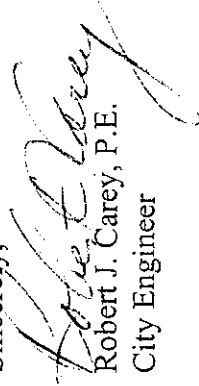
Robert J. Carey, P.E.
City Engineer

RJC/asr