

PERMIT NO.
23058



CITY OF NEW BEDFORD

DATE 3-26-01

SEWER AND/OR STORM DRAIN PERMIT

This certifies that permission is granted to

ANTONIO CARBALLO 24 RESERVATION RD. ACUSNET, MA 02743
Property Owner Address #8/ Tel. 985-9683,

to connect a sewer and/or storm drain located at ROUNSEVILLE ST. (NS.) 110 1/2 E. / BARTLETT ST.
Assessor's Plot 134.1 Lot 130., to the sewer and/or storm drain in ROUNSEVILLE ST. Street

to be laid in accordance with the conditions in this application and the City of New Bedford ordinances.

TYPE OF USE: ☒ RESIDENTIAL ☐ COMMERCIAL ☐ INDUSTRIAL ☐ OTHER

If applicant other than actual property owner, attach Letter of Authorization from Property Owner.

Name Tel. 4406D

Mailing Address

The Bonded Contractor/Drain Layer authorized to perform this work is:

R. J. CANESSA 993-9508.
Name Address Tel.

Type of Pipe Required: PVC-SAR-35
PERMIT EXPIRES ONE YEAR AFTER DATE OF ISSUE

- * Requires separate connections for sewage and storm drain where applicable. Storm water cannot be discharged to a sanitary sewer.
- * All work must be inspected and approved by a D.P.W. inspector before backfilling.
- * If this connection is to be part of a private service shared jointly with other building owners, attach copy of Recorded Joint Maintenance Agreement.
- * Permits can be issued to Industrial and/or Commercial Applicants only upon receipt and approval by the Commissioner of Public Works of required plans and supplemental information.
- * In addition, a City-issued Industrial User Discharge Permit and/or a Sewer Extension/Connection Permit issued by the Commonwealth of Massachusetts D.E.P. shall be required by the City for Industrial Discharge into the sewer system.

Industrial User-Discharge Permit-No. Date

Comm. Mass. Sewer Conn./Ext. Permit No. Date

A Filing and Inspection Fee of \$150.00, plus an Entrance Fee of \$ where applicable, must accompany this application.

Bank # BANK OF FALL RIVER Check # 0373 Date: 3-26-01 Receipt # 3953.

Other requirements: 10.5" ONLY - TO BE CONNECTED TO

AN 8" Sewer 12" S.W.F.D. 4406D RECEIVED

☒ Sewer

MAY - 3 2001

Connection made to Part of jointly-shared private line ☐ Yes ☒ No

☒ Storm Drain

DEPT. OF PUBLIC WORKS
NEW BEDFORD, MASS

Applicant agrees to abide by the above terms, as well as all pertinent ordinances of the City of New Bedford, and such other special rules as the Commissioner of Public Works may deem necessary

Lawrence J. Warden
Commissioner of Public Works
Signature of Property Owner or Representative

INSPECTOR'S REPORT

INSPECTED BY: JOSEPH MARTIN

DATE: 4/10/01



COMMENTS:

☒ APPROVED ☐ DISAPPROVED

Signature of Inspector

SIGNATURE

31-746

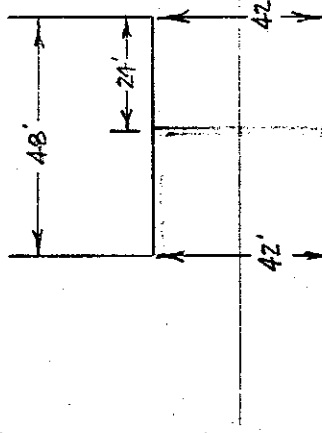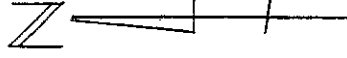

PAVE.

ROUNSEVILLE ST.
SKETCH PLAN



PERMIT NO.
23058

CITY OF NEW BEDFORD
SEWER AND/OR STORM DRAIN PERMIT

DATE 3-26-01

This certifies that permission is granted to

ANTONIO CARBALLO 24 RESERVATION RD. ACUSHNET, MA 02743
Property Owner Address #81 Tel. 985-9683.

to connect a sewer and/or storm drain located at ROUNDSEVILLE ST. (N.S.) 110th E/BARTULETT ST.
Assessor's Plot 132.7, Lot 130, to the sewer and/or storm drain in ROUNDSEVILLE ST. Street

to be laid in accordance with the conditions in this application and the City of New Bedford ordinances.

TYPE OF USE: ☒ RESIDENTIAL ☐ COMMERCIAL ☐ INDUSTRIAL ☐ OTHER

If applicant other than actual property owner, attach Letter of Authorization from Property Owner.

Name..... Tel.....

Mailing Address.....

The Bonded Contractor/Drain Layer authorized to perform this work is:

R. J. CANESEA - PUC - SAR 35- 993-9508.
Name Address Tel.

Type of Pipe Required.....
PERMIT EXPIRES ONE YEAR AFTER DATE OF ISSUE

- * Requires separate connections for sewage and storm drain where applicable. Storm water cannot be discharged to a sanitary sewer.
- * All work must be inspected and approved by a D.P.W. inspector before backfilling.
- * If this connection is to be part of a private service shared jointly with other building owners, attach copy of Recorded Joint Maintenance Agreement.
- * Permits can be issued to Industrial and/or Commercial Applicants only upon receipt and approval by the Commissioner of Public Works of required plans and supplemental information.
- * In addition, a City-issued Industrial User Discharge Permit and/or a Sewer Extension/Connection Permit issued by the Commonwealth of Massachusetts D.E.P. shall be required by the City for Industrial Discharge into the sewer system.

Industrial User Discharge Permit No..... Date.....

Comm. Mass. Sewer Conn./Ext. Permit No..... Date.....

A Filing and Inspection Fee of \$150.00, plus an Entrance Fee of \$..... where applicable, must accompany this application.

Bank # BANK OF FAIR HAVEN Check # 0373 Date 3-26-01 Receipt # 3953.

Other requirements: 1. NO STORM DRAIN ONLY - TO BE CONNECTED TO.....

AN 8" Sewer in 12" Sewer Dr. 440 G.P.D.

☒ Sewer

Connection made to

Part of jointly-shared private line ☐ Yes ☒ No

☒ Storm Drain

FOR INSPECTION ONLY, A 24 HOUR
NOTICE IS REQUIRED AND THE
CONTRACTOR/APPLICANT IS
REQUIRED TO NOTIFY THE
WASTEWATER DIVISION AT 991-6158

Applicant agrees to abide by the above terms, as well as all pertinent ordinances of the City of New Bedford, and such other special rules as the Commissioner of Public Works may deem necessary

Lawrence J. Warden
Commissioner of Public Works
M. J. Jones

Signature of Property Owner or Representative

INSPECTOR'S REPORT

INSPECTED BY: _____

DATE: _____

COMMENTS: _____

☐ APPROVED ☐ DISAPPROVED

Signature

SIGNATURE