

PERMIT NO.
23059



CITY OF NEW BEDFORD

DATE 3/27/2001

SEWER AND/OR STORM DRAIN PERMIT

This certifies that permission is granted to

John Sousa 19 Welcome St. New Bedford, MA 996-2973
Property Owner Address Tel.
to connect a sewer and/or storm drain located at Fitzgerald Dr. (W.S.) 140'± S. Phillips Rd.
Assessor's Plot 130D, Lot 367, to the sewer and/or storm drain in Fitzgerald Dr. Street
to be laid in accordance with the conditions in this application and the City of New Bedford ordinances.

TYPE OF USE: ☒ RESIDENTIAL ☐ COMMERCIAL ☐ INDUSTRIAL ☐ OTHER

RECEIVED

If applicant other than actual property owner, attach Letter of Authorization from Property Owner.

APR 02 2001

Name..... Tel..... DEPT. OF PUBLIC WORKS...
NEW BEDFORD, MASS

Mailing Address.....

The Bonded Contractor/Drain Layer authorized to perform this work is:

Braga Robert Services 3 E. Wardell St. So. Dartmouth 994-7968
Name Address Tel.

Type of Pipe Required: PVC - SDR-35

PERMIT EXPIRES ONE YEAR AFTER DATE OF ISSUE

- * Requires separate connections for sewage and storm drain where applicable. Storm water cannot be discharged to a sanitary sewer.
- * All work must be inspected and approved by a D.P.W. inspector before backfilling.
- * If this connection is to be part of a private service shared jointly with other building owners, attach copy of Recorded Joint Maintenance Agreement.
- * Permits can be issued to Industrial and/or Commercial Applicants only upon receipt and approval by the Commissioner of Public Works of required plans and supplemental information.
- * In addition, a City-issued Industrial User Discharge Permit and/or a Sewer Extension/Connection Permit issued by the Commonwealth of Massachusetts D.E.P. shall be required by the City for Industrial Discharge into the sewer system.

Industrial User Discharge Permit No..... Date.....

Comm. Mass. Sewer Conn./Ext. Permit No..... Date.....

A Filing and Inspection Fee of \$ 150.00, plus an Entrance Fee of \$..... where applicable, must accompany this application.

Bank # St. Anne's Credit Union Check # 106 Date: 3/27/01 Receipt # 3954

Other requirements: Insp. Only - To be connected
into 8" Sewer 330 G.P.D.

FOR INSPECTION ONLY, A 24 HOUR
NOTICE IS REQUIRED AND THE
CONTRACTOR/APPLICANT IS
REQUIRED TO NOTIFY THE
WASTEWATER DIVISION AT 991-6158

Connection made to ☒ Sewer ☐ Storm Drain
Part of jointly-shared private line ☐ Yes ☒ No

Applicant agrees to abide by the above terms, as well as all pertinent ordinances of the City of New Bedford, and such other special rules as the Commissioner of Public Works may deem necessary

Laurence D. Worden (Em) Commissioner of Public Works

Signature of Property Owner or Representative

INSPECTOR'S REPORT


INSPECTED BY: JOSEPH MARTIN

DATE: 3/29/01

COMMENTS:

☒ APPROVED ☐ DISAPPROVED

SIGNATURE

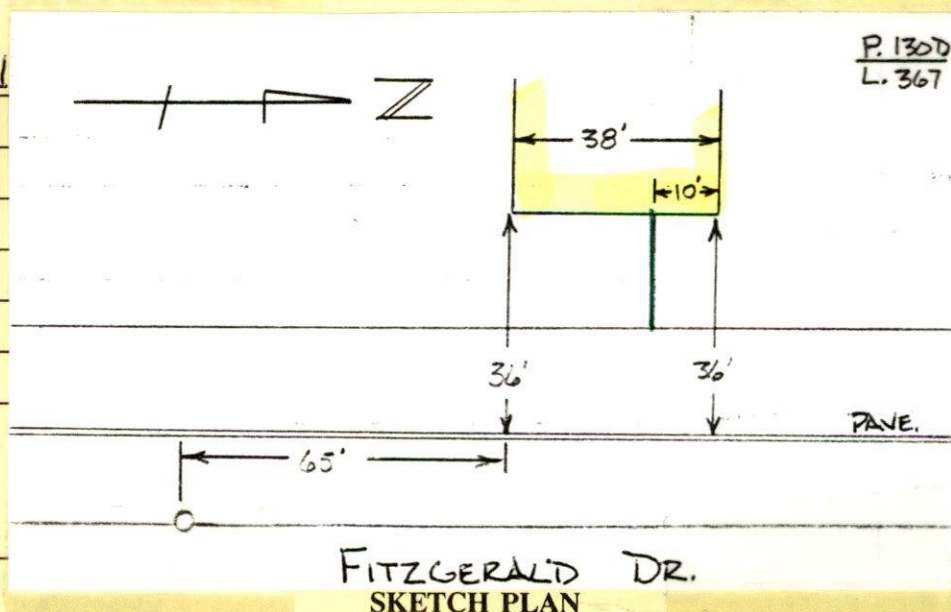

PERMIT NO.
23059



CITY OF NEW BEDFORD

DATE 3/27/2001

SEWER AND/OR STORM DRAIN PERMIT

This certifies that permission is granted to

John Sousa 19 Welcome St. New Bedford, MA 996-2973
Property Owner Address Tel.

to connect a sewer and/or storm drain located at Fitzgerald Dr. (W.S.) 140'± S. Phillips Rd.
Assessor's Plot 130D, Lot 367, to the sewer and/or storm drain in Fitzgerald Dr. Street
to be laid in accordance with the conditions in this application and the City of New Bedford ordinances.

TYPE OF USE: ☒ RESIDENTIAL ☐ COMMERCIAL ☐ INDUSTRIAL ☐ OTHER

If applicant other than actual property owner, attach Letter of Authorization from Property Owner.

Name.....Tel.....

Mailing Address.....

The Bonded Contractor/Drain Layer authorized to perform this work is:

Braga Robert Services 3 E. Wardell St. So. Dartmouth 994-7968
Name Address Tel.

Type of Pipe Required: PVC - SDR-35

PERMIT EXPIRES ONE YEAR AFTER DATE OF ISSUE

- * Requires separate connections for sewage and storm drain where applicable. Storm water cannot be discharged to a sanitary sewer.
- * All work must be inspected and approved by a D.P.W. inspector before backfilling.
- * If this connection is to be part of a private service shared jointly with other building owners, attach copy of Recorded Joint Maintenance Agreement.
- * Permits can be issued to Industrial and/or Commercial Applicants only upon receipt and approval by the Commissioner of Public Works of required plans and supplemental information.
- * In addition, a City-issued Industrial User Discharge Permit and/or a Sewer Extension/Connection Permit issued by the Commonwealth of Massachusetts D.E.P. shall be required by the City for Industrial Discharge into the sewer system.

Industrial User Discharge Permit No.....Date.....

Comm. Mass. Sewer Conn./Ext. Permit No.....Date.....

A Filing and Inspection Fee of \$ 150.00, plus an Entrance Fee of \$..... where applicable, must accompany this application.

Bank # ~~St. Anne's~~ Credit Union Check # 106 Date: 3/27/01 Receipt # 3954

Other requirements: Insp. Only - To be connected
into 8" Sewer 330 G.P.D.

FOR INSPECTION ONLY, A 24 HOUR
NOTICE IS REQUIRED AND THE
CONTRACTOR/APPLICANT IS
REQUIRED TO NOTIFY THE
WASTEWATER DIVISION AT 991-6158

☒ Sewer
Connection made to Part of jointly-shared private line ☐ Yes ☒ No
☐ Storm Drain

Applicant agrees to abide by the above terms, as well as all pertinent ordinances of the City of New Bedford, and such other special rules as the Commissioner of Public Works may deem necessary

Lawrence D. Worden
Commissioner of Public Works

[Signature]
Signature of Property Owner or Representative

INSPECTOR'S REPORT

INSPECTED BY: _____

DATE: _____

COMMENTS: _____

☐ APPROVED ☐ DISAPPROVED

SIGNATURE

SKETCH PLAN