

23075



DATE.....

SEWER AND/OR STORM DRAIN PERMIT

This certifies that permission is granted to

This certifies that permission is granted to JOHN & JOAN ROBINSON 195 WILBUR ST. NB.
 Property Owner Address #195 Tel. 508-996-1403
 to connect a sewer and/or storm drain located at WILBUR ST.-(NS) W/ROCKDALE AVE.
 Assessor's Plot 87, Lot 55, to the sewer and/or storm drain in WILBUR ST. Street
 to be laid in accordance with the conditions in this application and the City of New Bedford ordinances.

TYPE OF USE: ☒ RESIDENTIAL ☐ COMMERICAL ☐ INDUSTRIAL ☐ OTHER

If applicant other than actual property owner, attach Letter of Authorization from Property Owner.

Name..... Tel..... NEW BEDFORD, MASS.

Mailing Address.....

The Bonded Contractor/Drain Layer authorized to perform this work is:

Name	Address	Tel.
ACUSHNET TRENCHING	JOHN GOLDA	508-995-9819

Type of Pipe Required: IVE, SDR 3.5

PERMIT EXPIRES ONE YEAR AFTER DATE OF ISSUE

* Requires separate connections for sewage and storm drain where applicable. Storm water cannot be discharged to a sanitary sewer.

* All work must be inspected and approved by a D.P.W. inspector before backfilling.

* If this connection is to be part of a private service shared jointly with other building owners, attach copy of Recorded Joint Maintenance Agreement.

* Permits can be issued to Industrial and/or Commercial Applicants only upon receipt and approval by the Commissioner of Public Works of required plans and supplemental information.

* In addition, a City-issued Industrial User Discharge Permit and/or a Sewer Extension/Connection Permit issued by the Commonwealth of Massachusetts D.E.P. shall be required by the City for Industrial Discharge into the sewer system.

Industrial User Discharge Permit No. Date

Comm. Mass. Sewer Conn./Ext. Permit No. _____ Date _____

A Filing and Inspection Fee of \$150.00, plus an Entrance Fee of \$294.00 where applicable, must accompany this application.

Bank # COMPASS Check # 4150 Date: 4-26-01 Receipt # 4011

Other requirements: INST. ONLY - TO BE CONNECTED TO A STUB 330 GPD

② Proportive Line

☒ Sewer

Connection made to _____ Part of jointly-shared private line ☐ Yes ☒ No

☐ Storm Drain

Applicant agrees to abide by the above terms, as well as all pertinent ordinances of the City of New Bedford, and such other special rules as the Commissioner of Public Works may deem necessary

Commissioner of Public Works

Signature of Property Owner or Representative

INSPECTED BY: JOSEPH MARTIN

DATE: 6/14/01

COMMENTS: [CDM inspected from main in street to prop. line - R0 St. Sewer Project].

STUB- 6" PVC- 20 LF
DEPTH- 6'

88'

HYD. 54'

SMH. 8" PVC

4+30.3

WILBUR ST.

32' 72'

195
WILBUR

WILBUR ST.



(1 of 2)
(2 of 2)

☒ APPROVED

☐ DISAPPROVED

SIGNATURE

SKETCH PLAN

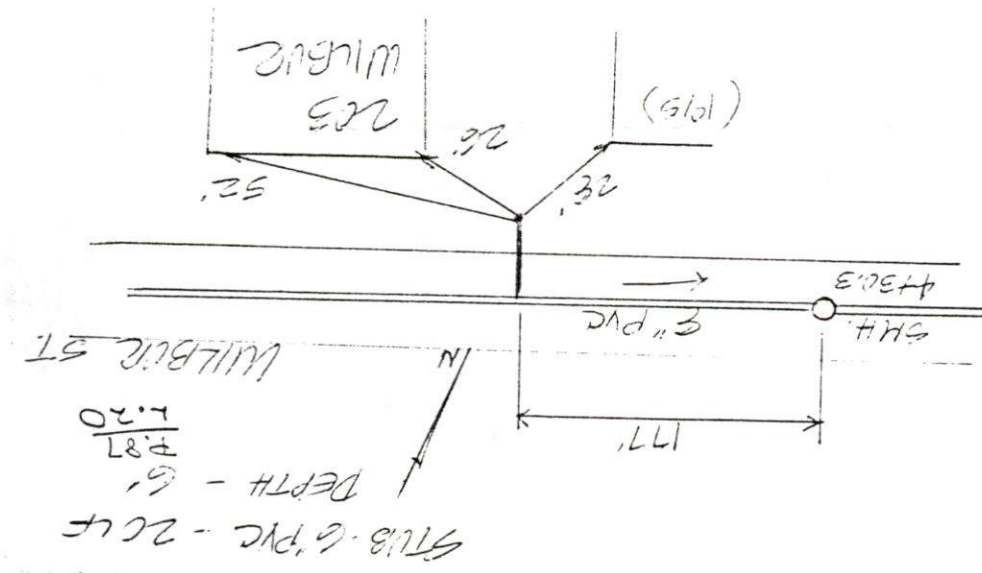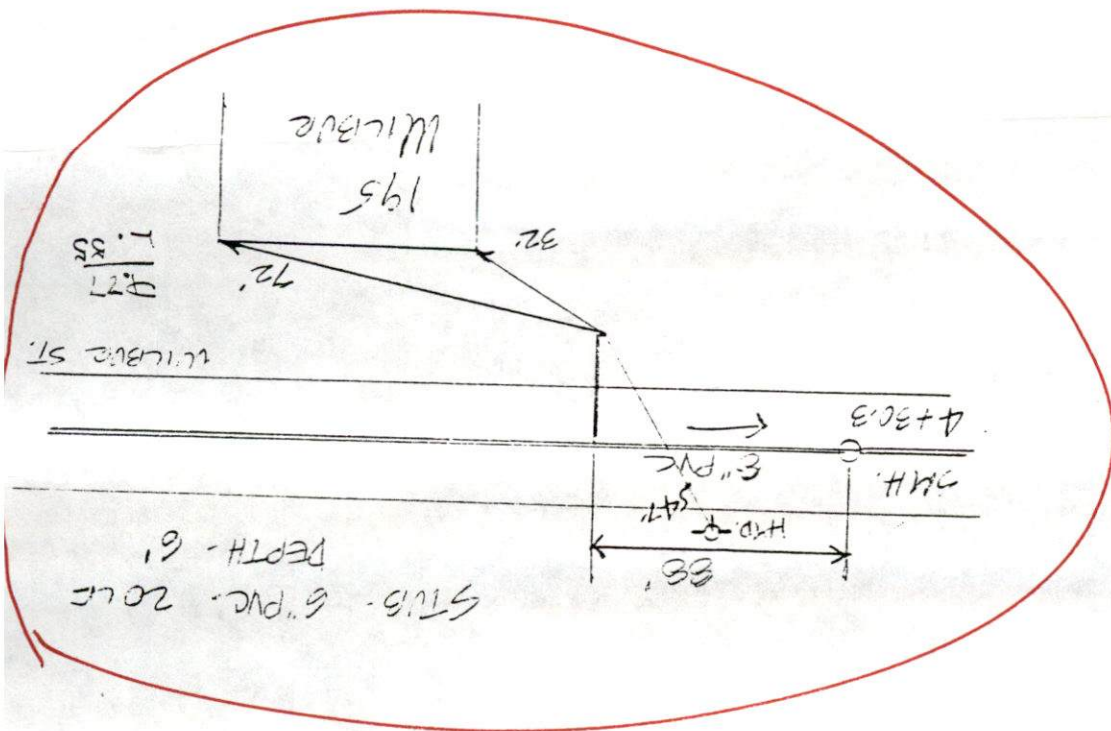

PERMIT NO.
23075



CITY OF NEW BEDFORD

DATE.....4-27-01

SEWER AND/OR STORM DRAIN PERMIT

This certifies that permission is granted to

JOHN & JOAN ROBINSON - 195 WILBUR ST. NB.
Property Owner Address #195- Tel. 508-996-1403

to connect a sewer and/or storm drain located at WILBUR ST. (NS) W/ ROCKDALE AVE -
Assessor's Plot...87..., Lot...55..., to the sewer and/or storm drain in WILBUR ST. Street
to be laid in accordance with the conditions in this application and the City of New Bedford ordinances.

TYPE OF USE: ☒ RESIDENTIAL ☐ COMMERICAL ☐ INDUSTRIAL ☐ OTHER

If applicant other than actual property owner, attach Letter of Authorization from Property Owner.

Name..... Tel.....

Mailing Address.....

The Bonded Contractor/Drain Layer authorized to perform this work is:

ACHSHNET TRENCHING JOHN GOLDA - 508-995-9819
Name Address Tel.

Type of Pipe Required: PVC SDR 35

PERMIT EXPIRES ONE YEAR AFTER DATE OF ISSUE

- * Requires separate connections for sewage and storm drain where applicable. Storm water cannot be discharged to a sanitary sewer.
- * All work must be inspected and approved by a D.P.W. inspector before backfilling.
- * If this connection is to be part of a private service shared jointly with other building owners, attach copy of Recorded Joint Maintenance Agreement.
- * Permits can be issued to Industrial and/or Commercial Applicants only upon receipt and approval by the Commissioner of Public Works of required plans and supplemental information.
- * In addition, a City-issued Industrial User Discharge Permit and/or a Sewer Extension/Connection Permit issued by the Commonwealth of Massachusetts D.E.P. shall be required by the City for Industrial Discharge into the sewer system.

Industrial User Discharge Permit No..... Date.....

Comm. Mass. Sewer Conn./Ext. Permit No..... Date.....

A Filing and Inspection Fee of \$150.00, plus an Entrance Fee of \$294.00 where applicable, must accompany this application.

Bank # COMPASS Check # 4150 Date: 4-26-01 Receipt # 4011

Other requirements: INST. ONLY - TO BE CONNECTED TO A SUB. 330 GPD

@ Proletic Line

☒ Sewer

Connection made to

☐ Storm Drain

Part of jointly-shared private line ☐ Yes ☒ No

FOR INSPECTION ONLY, A 24 HOUR
NOTICE IS REQUIRED AND THE
CONTRACTOR/APPLICANT IS
REQUIRED TO NOTIFY THE
WASTEWATER DIVISION AT 991-6151

Applicant agrees to abide by the above terms, as well as all pertinent ordinances of the City of New Bedford, and such other special rules as the Commissioner of Public Works may deem necessary

Commissioner of Public Works

Signature of Property Owner or Representative

INSPECTOR'S REPORT

INSPECTED BY: _____

DATE: _____

COMMENTS: _____

☐ APPROVED

☐ DISAPPROVED

SIGNATURE

SKETCH PLAN