

PERMIT NO.
23078



CITY OF NEW BEDFORD

DATE... 5-3-01

SEWER AND/OR STORM DRAIN PERMIT

This certifies that permission is granted to

JOSE DE SOUSA 59 WILLIAM ST. SO. DARTMOUTH MA. 02748
Property Owner Address #268 Tel. 508-971-9224

to connect a sewer and/or storm drain located at... FITZGERALD DR (WS) 175'± SO/PHILLIPS RD. Extension
Assessor's Plot... 130D, Lot... 368... to the sewer and/or storm drain in... FITZGERALD DR Street

to be laid in accordance with the conditions in this application and the City of New Bedford ordinances.

TYPE OF USE: ☒ RESIDENTIAL ☐ COMMERICAL ☐ INDUSTRIAL ☐ OTHER

If applicant other than actual property owner, attach Letter of Authorization from Property Owner. RECEIVED

Name... Tel... AUG - 7 2001

Mailing Address... DEPT. OF PUBLIC WORKS
NEW BEDFORD, MASS

The Bonded Contractor/Drain Layer authorized to perform this work is:

JO BRAGA BOBCAT. 508-9947968
Name Address Tel.

Type of Pipe Required: PVC - SDR 35

PERMIT EXPIRES ONE YEAR AFTER DATE OF ISSUE

- * Requires separate connections for sewage and storm drain where applicable. Storm water cannot be discharged to a sanitary sewer.
- * All work must be inspected and approved by a D.P.W. inspector before backfilling.
- * If this connection is to be part of a private service shared jointly with other building owners, attach copy of Recorded Joint Maintenance Agreement.
- * Permits can be issued to Industrial and/or Commercial Applicants only upon receipt and approval by the Commissioner of Public Works of required plans and supplemental information.
- * In addition, a City-issued Industrial User Discharge Permit and/or a Sewer Extension/Connection Permit issued by the Commonwealth of Massachusetts D.E.P. shall be required by the City for Industrial Discharge into the sewer system.

Industrial User Discharge Permit No. Date

Comm. Mass. Sewer Conn./Ext. Permit No. Date

A Filing and Inspection Fee of \$150.00, plus an Entrance Fee of \$... where applicable, must accompany this application.

Bank # LUZO. Check # 106. Date: 5-3-01 Receipt # 4014.

Other requirements: INSP. ONLY - TO BE CONNECTED TO 330 SPD.

A STUB AT PROP. LINE

☒ Sewer
Connection made to Part of jointly-shared private line ☐ Yes ☒ No
☐ Storm Drain

Applicant agrees to abide by the above terms, as well as all pertinent ordinances of the City of New Bedford, and such other special rules as the Commissioner of Public Works may deem necessary

Laurence S. Worden mg.
Commissioner of Public Works Signature of Property Owner or Representative


Mano S. James

INSPECTED BY: JOSEPH MARTIN
DATE: 5/10/01
COMMENTS: [Stub was put in due White Meadows subdivision.]

☒ APPROVED ☐ DISAPPROVED

Joseph Martin
SIGNATURE

INSPECTOR'S REPORT

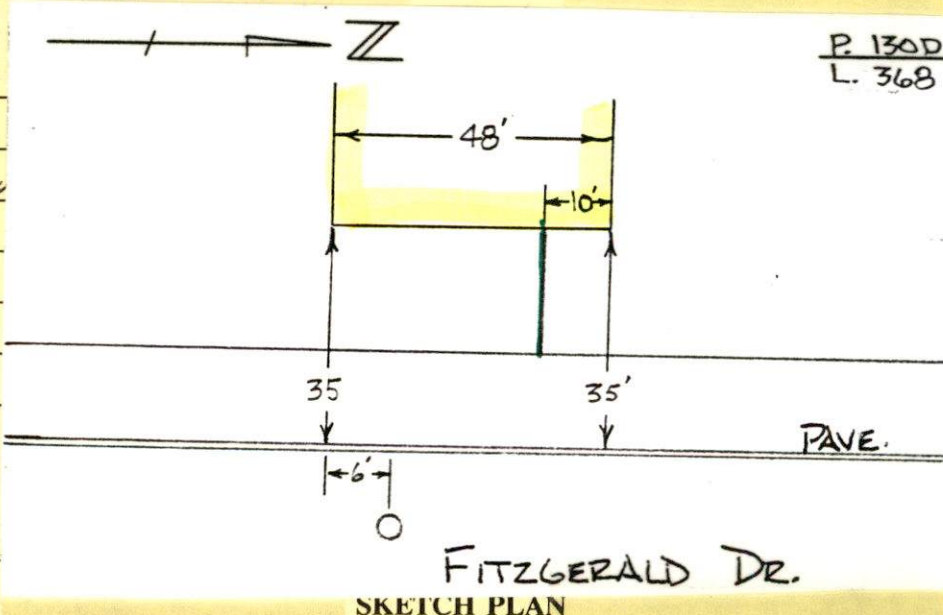

PERMIT NO.
23078



CITY OF NEW BEDFORD

DATE 5-3-01

SEWER AND/OR STORM DRAIN PERMIT

This certifies that permission is granted to

JOSE DESOUSA 59 WILLIAM ST. SO. DARTMOUTH MA. 02746
Property Owner Address Tel. 508-971-9224

to connect a sewer and/or storm drain located at FITZGERALD DR. (WS) 175'± SO. PHILLIPS RD. Extension
Assessor's Plot 1300, Lot 368, to the sewer and/or storm drain in FITZGERALD DR. Street

to be laid in accordance with the conditions in this application and the City of New Bedford ordinances.

TYPE OF USE: ☒ RESIDENTIAL ☐ COMMERICAL ☐ INDUSTRIAL ☐ OTHER

If applicant other than actual property owner, attach Letter of Authorization from Property Owner.

Name _____ Tel. _____

Mailing Address _____

The Bonded Contractor/Drain Layer authorized to perform this work is:

JO BRAGA BOBCAT 508-9947968
Name Address Tel.

Type of Pipe Required: PVC-SDR 35

PERMIT EXPIRES ONE YEAR AFTER DATE OF ISSUE

- * Requires separate connections for sewage and storm drain where applicable. Storm water cannot be discharged to a sanitary sewer.
- * All work must be inspected and approved by a D.P.W. inspector before backfilling.
- * If this connection is to be part of a private service shared jointly with other building owners, attach copy of Recorded Joint Maintenance Agreement.
- * Permits can be issued to Industrial and/or Commercial Applicants only upon receipt and approval by the Commissioner of Public Works of required plans and supplemental information.
- * In addition, a City-issued Industrial User Discharge Permit and/or a Sewer Extension/Connection Permit issued by the Commonwealth of Massachusetts D.E.P. shall be required by the City for Industrial Discharge into the sewer system.

Industrial User Discharge Permit No. _____ Date _____

Comm. Mass. Sewer Conn./Ext. Permit No. _____ Date _____

A Filing and Inspection Fee of \$150.00, plus an Entrance Fee of \$_____, where applicable, must accompany this application.

Bank # LUZO Check # 106 Date: 5-3-01 Receipt # 4014

Other requirements: INSP. ONLY - TO BE CONNECTED TO 330.6 PD.
A STUB AT PROP. LINE.

Connection made to ☒ Sewer ☐ Storm Drain Part of jointly-shared private line ☐ Yes ☒ No

FOR INSPECTION ONLY, A 24 HOUR NOTICE IS REQUIRED AND THE CONTRACTOR/APPLICANT IS REQUIRED TO NOTIFY THE WASTEWATER DIVISION AT 991-6158

Applicant agrees to abide by the above terms, as well as all pertinent ordinances of the City of New Bedford, and such other special rules as the Commissioner of Public Works may deem necessary

Laurence S. Worden mg.
Commissioner of Public Works

Signature of Property Owner or Representative

INSPECTOR'S REPORT

INSPECTED BY: _____

DATE: _____

COMMENTS: _____

☐ APPROVED ☐ DISAPPROVED

SIGNATURE

SKETCH PLAN