

DATE.....5/4/01
EXP 5/4/02

Fried R.

~~Eric R.~~ ~~Briley~~ 670 Hathaway Rd. NK MA 02740

Tel. 508-794-2621

to be laid in accordance with the conditions in this application and the City of New Bedford ordinances.

110 GPD

RECEIVED

AUG - 7 2001

DEPT. OF PUBLIC WORKS
NEW BEDFORD, MASS

Tel.

PVC 5DK 35

PERMIT EXPIRES ONE YEAR AFTER DATE OF ISSUE

- * Requires separate connections for sewage and storm drain where applicable. Storm water cannot be discharged to a sanitary sewer.
- * All work must be inspected and approved by a D.P.W. inspector before backfilling.
- * If this connection is to be part of a private service shared jointly with other building owners, attach copy of Recorded Joint Maintenance Agreement.
- * Permits can be issued to Industrial and/or Commercial Applicants only upon receipt and approval by the Commissioner of Public Works of required plans and supplemental information.
- * In addition, a City-issued Industrial User Discharge Permit and/or a Sewer Extension/Connection Permit issued by the Commonwealth of Massachusetts D.E.P. shall be required by the City for Industrial Discharge into the sewer system.

N/A

117

ction Fee of \$ 150.00

Compass Book

Inspection July 5-186 at R-R House St Junior Pri. Cost of Stock =

27' x \$14.70/ft = \$396.90; Sewer Permit Cost = \$150.00.

Connection made to ☒ Sewer ☐ Storm Drain

Part of jointly-shared private line ☐ Yes ☒ No

FOR INSPECTION ONLY, A 24 HOUR NOTICE IS REQUIRED AND THE CONTRACTOR/APPLICANT IS REQUIRED TO NOTIFY THE WASTEWATER DIVISION AT 991-6153

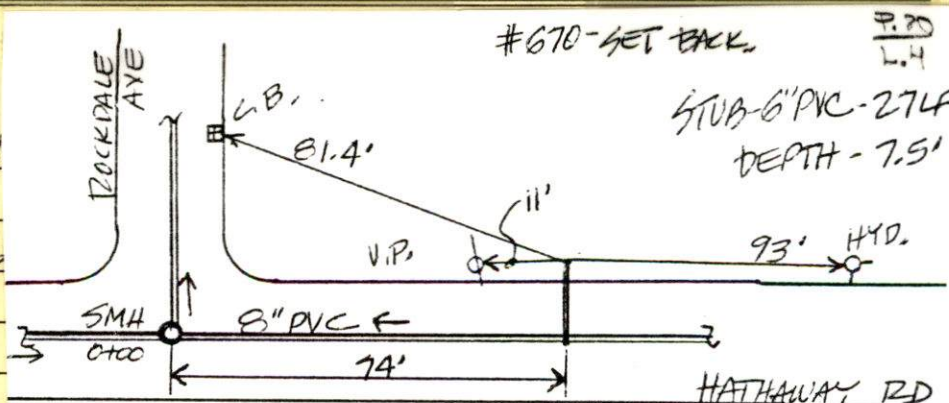
Applicant agrees to abide by the above terms, as well as all pertinent ordinances of the City of New Bedford, and such other special rules as the Commissioner of Public Works may deem necessary

Signature of Property Owner or Representative

JOSEPH MARTIN

7/9/01

COMMENTS: [CDM inspected from
main in street to prop. line.-
Rowe St. Sewer Project.]

☐ DISAPPROVED

31-746

HATHAWAY RD.

SKETCH PLAN

(of 2)

(2 of 2)

PERMIT NO.
23079



CITY OF NEW BEDFORD

DATE 5/4/01
EXP 5/4/02

SEWER AND/OR STORM DRAIN PERMIT

This certifies that permission is granted to Eric R. Sailing 670 Hathaway Rd. N. MA 02740
Robert George Morris 203 Chestnut St. New Bedford MA 02740
Property Owner Address Tel. 508-994-2621

to connect a sewer and/or storm drain located at Hathaway Rd. # 670 (S.S.) W. Rockdale Ave.
Assessor's Plot 80, Lot 4, to the sewer and/or storm drain in Hathaway Rd. Street

to be laid in accordance with the conditions in this application and the City of New Bedford ordinances.

TYPE OF USE: ☒ RESIDENTIAL ☐ COMMERICAL ☐ INDUSTRIAL ☐ OTHER

110 GPD

If applicant other than actual property owner, attach Letter of Authorization from Property Owner.

Name N/A Tel. _____

Mailing Address _____

The Bonded Contractor/Drain Layer authorized to perform this work is: Stub at R.
Kris Asphalt, Inc. 476 Hixville Rd. N. Dartmouth MA 02747 508-996-0733
Name Address Tel.

Type of Pipe Required: PVC SDK 35

PERMIT EXPIRES ONE YEAR AFTER DATE OF ISSUE

- * Requires separate connections for sewage and storm drain where applicable. Storm water cannot be discharged to a sanitary sewer.
- * All work must be inspected and approved by a D.P.W. inspector before backfilling.
- * If this connection is to be part of a private service shared jointly with other building owners, attach copy of Recorded Joint Maintenance Agreement.
- * Permits can be issued to Industrial and/or Commercial Applicants only upon receipt and approval by the Commissioner of Public Works of required plans and supplemental information.
- * In addition, a City-issued Industrial User Discharge Permit and/or a Sewer Extension/Connection Permit issued by the Commonwealth of Massachusetts D.E.P. shall be required by the City for Industrial Discharge into the sewer system.

Industrial User Discharge Permit No. N/A Date _____

Comm. Mass. Sewer Conn./Ext. Permit No. N/A Date _____

A Filing and Inspection Fee of \$ 150.00, plus an Entrance Fee of \$ 396.90 where applicable, must accompany this application.

Bank # Compass Bank Check # 101 Date: 5/4/01 Receipt # 4015

Other requirements: Inspection Only - Stub at R - Rowe St Sewer Proj. Cost of Stub =

27' x \$14.70/ft = \$396.90; Sewer Permit Cost = \$150.00;

Total = \$546.90

Connection made to ☒ Sewer Part of jointly-shared private line ☐ Yes ☒ No

☐ Storm Drain

Owner must call Health Dept. re: Septic System Abandonment.

Applicant agrees to abide by the above terms, as well as all pertinent ordinances of the City of New Bedford, and such other special rules as the Commissioner of Public Works may deem necessary

Lawrence D. Wondew
Commissioner of Public Works

[Signature]
Signature of Property Owner or Representative

FOR INSPECTION ONLY, A 24 HOUR NOTICE IS REQUIRED AND THE CONTRACTOR/APPLICANT IS REQUIRED TO NOTIFY THE WASTEWATER DIVISION AT 991-6158

INSPECTOR'S REPORT

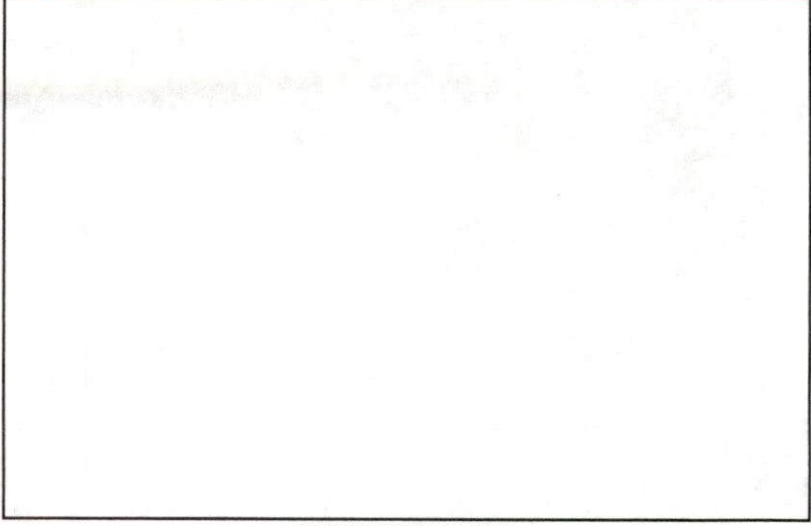
INSPECTED BY: _____

DATE: _____

COMMENTS: _____

☐ APPROVED ☐ DISAPPROVED

SIGNATURE



SKETCH PLAN



CITY OF NEW BEDFORD MASSACHUSETTS

DEPARTMENT OF PUBLIC WORKS
ENGINEERING DIVISION
133 WILLIAM STREET, ROOM 303
NEW BEDFORD, MA 02740

Tel: (508) 979-1527

Fax: (508) 961-3043

LAWRENCE D. WORDEN
COMMISSIONER

January 2, 2001

Attn: Walden Land Co., L.L.C.
15 Hamilton St.
New Bedford, MA 02740

Re: Rowe Street Sewer Project Area--Properties Located Within Isolated Portions of the Sewer System Which Have Been Approved and Are Presently Operational

This letter serves as notification to you that the following property may now connect to the sewer system:

Owner(s):	Walden Land Co., L.L.C.
Location:	670 Hathaway Rd.
Plot/Lot:	80/4
Service Pipe Length Installed:	27
Total Cost of Service Line:	\$396.90

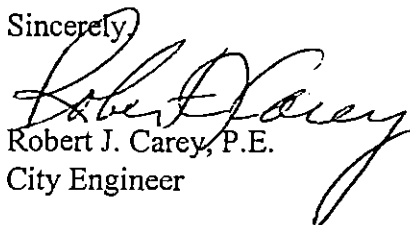
396.90
150.00
<hr/>
546.90

In addition to the cost of the service line provided for the property, which the property owner must reimburse the City for when ready to connect to the sewer system, there is also a "Sewer Permit" fee of \$150.00. Once ready to connect to the sewer system, the property owner must come to City Hall, D.P.W. Engineering office, Room 303, to obtain said permit, at which time both of these amounts are due to the City. If someone other than the property owner is going to obtain the permit, this person must have a signed permission slip from the property owner allowing the entity to sign on behalf of the property owner. Also, if the property owner is abandoning a septic system, they must make arrangements with the Health Department at (508) 991-6273.

The City has brought the sewer service pipe to your property line. The property owner is responsible for making the provisions for any work required and costs incurred on their property. Property owners should make sure that the contractor they hire knows that, although they are working on private property, the D.P.W. Waste Water Division, and possibly other City officials, must inspect all work done before the sewer trench is backfilled.

Should you have any questions or need additional information, please feel free to contact Ana Rosa or Mario Gomes in the Engineering Department at (508) 979-1527.

Sincerely,


Robert J. Carey, P.E.
City Engineer

RJC/asr

DRAIN

HATHAWAY RD (#670) EAST SIDE

Permit

No.

Enters

HATHAWAY RD

Drain Plot No.

From Property of

