

PERMIT NO.
23082



CITY OF NEW BEDFORD
SEWER AND/OR STORM DRAIN PERMIT

DATE.....5/11/01
EXP 5/11/02

This certifies that permission is granted to
JOHN CZABAN 1148 ROCKDALE AVE N.B. 508-994-9002
Property Owner Address Tel.

to connect a sewer and/or storm drain located at DURFEE STREET ROCKDALE AVE #1148
Assessor's Plot 75, Lot 242, to the sewer and/or storm drain in DURFEE ST Street

to be laid in accordance with the conditions in this application and the City of New Bedford ordinances.

TYPE OF USE: ☒ RESIDENTIAL ☐ COMMERCIAL ☐ INDUSTRIAL ☐ OTHER

3306PD

If applicant other than actual property owner, attach Letter of Authorization from Property Owner.

Name Dimis Noonan Tel. 508-563-7789
Mailing Address P.O. Box 178 N. Falmouth MA 02556

The Bonded Contractor/Drain Layer authorized to perform this work is: Stub at 12 **RECEIVED**
Same as applicant Name Address Tel. **AUG - 7 2001**

Type of Pipe Required: PVC SDR 35
PERMIT EXPIRES ONE YEAR AFTER DATE OF ISSUE

- * Requires separate connections for sewage and storm drain where applicable. Storm water cannot be discharged to a sanitary sewer.
- * All work must be inspected and approved by a D.P.W. inspector before backfilling.
- * If this connection is to be part of a private service shared jointly with other building owners, attach copy of Recorded Joint Maintenance Agreement.
- * Permits can be issued to Industrial and/or Commercial Applicants only upon receipt and approval by the Commissioner of Public Works of required plans and supplemental information.
- * In addition, a City-issued Industrial User Discharge Permit and/or a Sewer Extension/Connection Permit issued by the Commonwealth of Massachusetts D.E.P. shall be required by the City for Industrial Discharge into the sewer system.

Industrial User Discharge Permit No. Date
Comm. Mass. Sewer Conn./Ext. Permit No. Date

A Filing and Inspection Fee of \$ 150.00, plus an Entrance Fee of \$ 308.70 where applicable, must accompany this application.

Bank # Cash (Paid at Treasury) Check # Date: 5/14/01 Receipt # 106
Other requirements: Inspection Only - Rowe St. Proj. - Stub: \$14.70/ft x 21' = \$308.70; Sewer Permit: \$150.00 ∴ Total = \$458.70

☒ Sewer
Connection made to Part of jointly-shared private line ☐ Yes ☒ No
☐ Storm Drain

Owner must call Health Dept. re: septic system abandonment.

Applicant agrees to abide by the above terms, as well as all pertinent ordinances of the City of New Bedford, and such other special rules as the Commissioner of Public Works may deem necessary

LAURENCE D. WARDEN
Commissioner of Public Works

Dimis Noonan
Signature of Property Owner or Representative

INSPECTOR'S REPORT


FOR INSPECTION ONLY. A 24 HOUR

INSPECTED BY: JOSEPH MARTIN
DATE: 5/23/01

COMMENTS: USED SCH 40 TO STUB
ECOM inspected from main in
street to prop. line - Rowe St
Sewer Project.]

☒ APPROVED ☐ DISAPPROVED

Joseph Martin
SIGNATURE

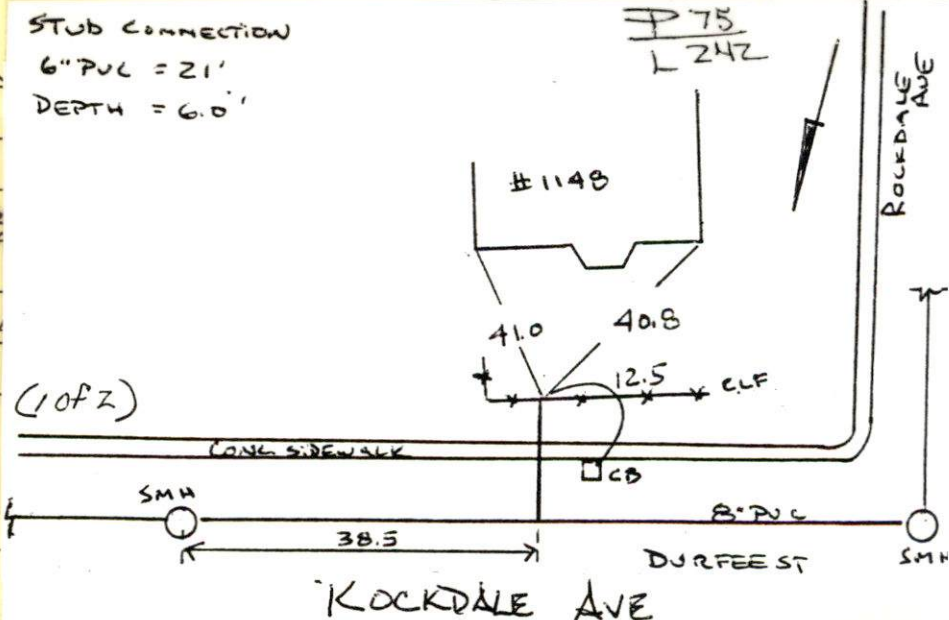

PERMIT NO.
23082



CITY OF NEW BEDFORD
SEWER AND/OR STORM DRAIN PERMIT

DATE 5/14/01
EXP 5/14/02

This certifies that permission is granted to
JOHN CZABAN 1148 ROCKDALE AVE N.B. 508-994-9002
Property Owner Address Tel.
to connect a sewer and/or storm drain located at DURFEE STREET ROCKDALE AVE. #1148
Assessor's Plot 75, Lot 242, to the sewer and/or storm drain in DURFEE ST. Street
to be laid in accordance with the conditions in this application and the City of New Bedford ordinances.
TYPE OF USE: ☒ RESIDENTIAL ☐ COMMERCIAL ☐ INDUSTRIAL ☐ OTHER 330 GPD
If applicant other than actual property owner, attach Letter of Authorization from Property Owner.
Name Dennis Noonan Tel. 508-563-7789
Mailing Address P.O. Box 178 N. Falmouth MA 02556
The Bonded Contractor/Drain Layer authorized to perform this work is: Stub at R.
Same as applicant.
Name Address Tel.
Type of Pipe Required: PVC SDR 35
PERMIT EXPIRES ONE YEAR AFTER DATE OF ISSUE

- * Requires separate connections for sewage and storm drain where applicable. Storm water cannot be discharged to a sanitary sewer.
- * All work must be inspected and approved by a D.P.W. inspector before backfilling.
- * If this connection is to be part of a private service shared jointly with other building owners, attach copy of Recorded Joint Maintenance Agreement.
- * Permits can be issued to Industrial and/or Commercial Applicants only upon receipt and approval by the Commissioner of Public Works of required plans and supplemental information.
- * In addition, a City-issued Industrial User Discharge Permit and/or a Sewer Extension/Connection Permit issued by the Commonwealth of Massachusetts D.E.P. shall be required by the City for Industrial Discharge into the sewer system.

Industrial User Discharge Permit No. — Date —
Comm. Mass. Sewer Conn./Ext. Permit No. — Date —

A Filing and Inspection Fee of \$ 150.00, plus an Entrance Fee of \$ 308.70 where applicable, must accompany this application.

Bank # Cash (Paid at Treasurers) Check # — Date: 5/14/01 Receipt # 106

Other requirements: Inspection Only - Rowe St. Proj. - Stub: #14.70/ft x 21' =
\$308.70; Sewer Permit: \$150.00; Total = \$458.70

☒ Sewer

Connection made to Part of jointly-shared private line ☐ Yes ☒ No

☐ Storm Drain

Owner must call Health Dept. re: septic system abandonment.

Applicant agrees to abide by the above terms, as well as all pertinent ordinances of the City of New Bedford, and such other special rules as the Commissioner of Public Works may deem necessary

LAURENCE D. WOODEN
Commissioner of Public Works

[Signature]
Signature of Property Owner or Representative

INSPECTOR'S REPORT

INSPECTED BY: _____

DATE: _____

COMMENTS: _____

☐ APPROVED

☐ DISAPPROVED

SIGNATURE

SKETCH PLAN

FOR INSPECTION ONLY, A 24 HOUR
NOTICE IS REQUIRED AND THE
CONTRACTOR/APPLICANT IS
REQUIRED TO NOTIFY THE
WASTEWATER DIVISION AT 591 6158



MASSACHUSETTS

DEPT. OF PUBLIC WORKS

133 WILLIAM STREET

LAWRENCE D. WORDEN
COMMISSIONER

To Whom It May Concern:

I, John Czaban, being
(Name) Print Mailing Address

owner of property located at 1148 Rockdale Ave

Plot 75, Lot 242 hereby agree to allow Dennis Noonan
Name

Box 178 No. Fel. Mass to act on my behalf, including affixing my signature,
Mailing Address
in securing permits for:

☒ Sewer/Drain Service Permits
☐ Water Service Permits
☐ Driveway Installation Permits
☐ Sidewalk Installation Permits

I further agree to conform to, and abide by, all City rules and ask regulations applicable to the permit (s) being applied for.

Name John Czaban
(signature)


1148 Rockdale Ave.
(Address)

5-7-01 (508) 994-9002
(Date) (Telephone Number)


2x1/2 couplings
 2 1/2 T
 1 Y
 2 1/2 x 2 T
 2" 2.5 45
 1 E.G. 2
 4" 1-22
 9" 2-45
 6x4 Donut

2/28/11
 Bob Work
 905-4600
 9949202

2001 190 3617 Dig Safe #

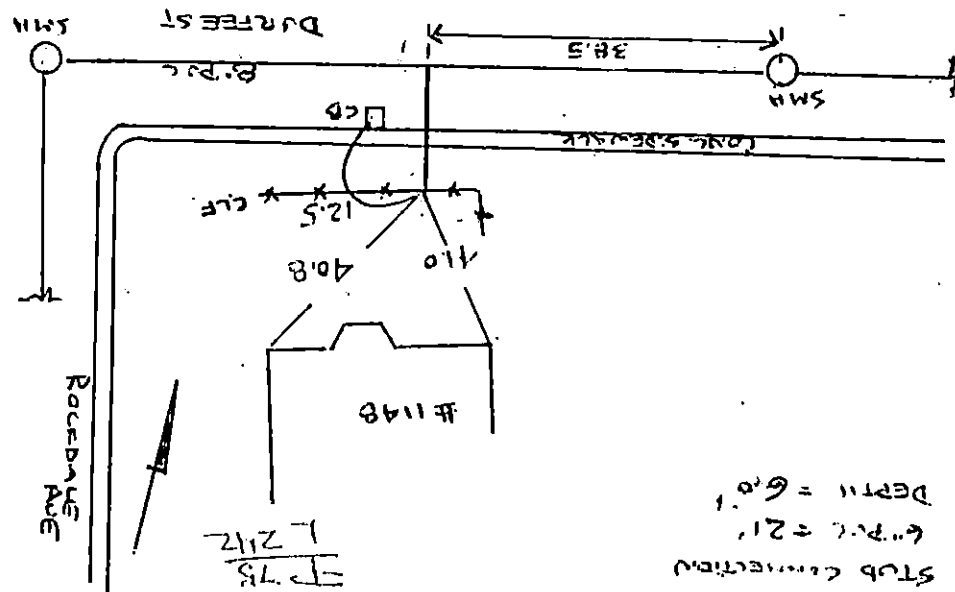

STUB CONNECTION
 6" P.C. = 21'
 DEPTH = 6.0'

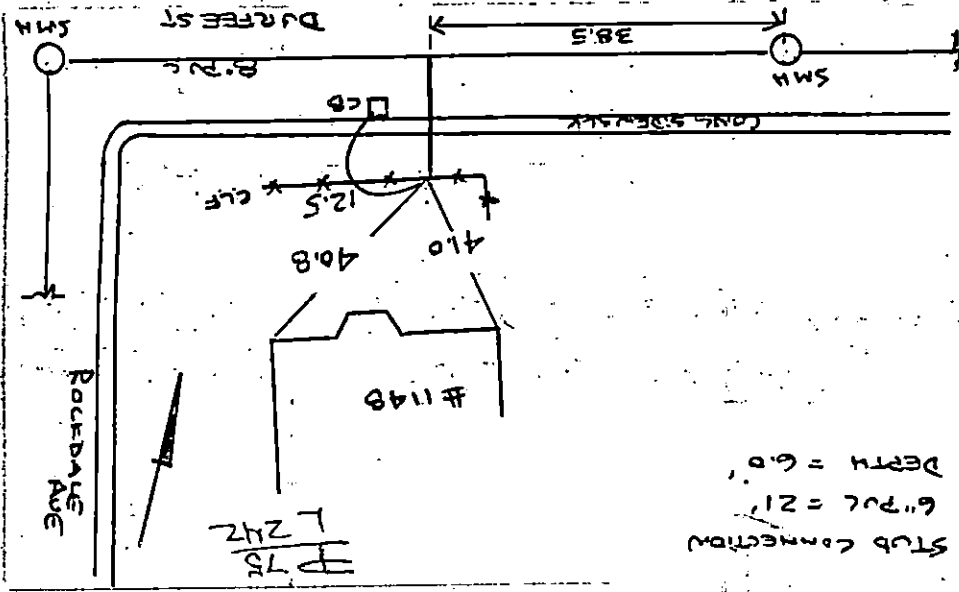

DRAIN	
Permit No. 23082-01	
Enters DURFEE ST	
Drain Plot No.	
From Property of	
Rockdale Ave #1148 (EAST SIDE)	