



PERMIT NO.
23093

CITY OF NEW BEDFORD

DATE 6/27/01

SEWER AND/OR STORM DRAIN PERMIT

This certifies that permission is granted to

Joe Vaz, 332 Conduit St., New Bedford, 508-995-818
Property Owner Address #21 Tel.

to connect a sewer and/or storm drain located at Central Ave (NS) 160' ± W x Conduit St.
Assessor's Plot 111, Lot 165, to the sewer and/or storm drain in Central Ave. Street

RECEIVED

TYPE OF USE: ☐ RESIDENTIAL ☐ COMMERCIAL ☐ INDUSTRIAL ☐ OTHER

SEP 27 2001

If applicant other than actual property owner, attach Letter of Authorization from Property Owner.

DEPT. OF PUBLIC WORKS
NEW BEDFORD, MASS.

Name Tel.

Mailing Address

The Bonded Contractor/Drain Layer authorized to perform this work is:

Diversified Construction, 383 Hixville Rd., 508-997-3910
Name Address Tel.

Type of Pipe Required: PVC - SDR - 35
PERMIT EXPIRES ONE YEAR AFTER DATE OF ISSUE

* Requires separate connections for sewage and storm drain where applicable. Storm water cannot be discharged to a sanitary sewer.

* All work must be inspected and approved by a D.P.W. inspector before backfilling.

* If this connection is to be part of a private service shared jointly with other building owners, attach copy of Recorded Joint Maintenance Agreement.

* Permits can be issued to Industrial and/or Commercial Applicants only upon receipt and approval by the Commissioner of Public Works of required plans and supplemental information.

* In addition, a City-issued Industrial User Discharge Permit and/or a Sewer Extension/Connection Permit issued by the Commonwealth of Massachusetts D.E.P. shall be required by the City for Industrial Discharge into the sewer system.

Industrial User Discharge Permit No. Date

Comm. Mass. Sewer Conn./Ext. Permit No. Date

A Filing and Inspection Fee of \$150, plus an Entrance Fee of \$, where applicable, must accompany this application.

Bank # Check # Date: 6/27/01 Receipt # 4053

Other requirements: Insp. Only - Connected

to 10" Sewer

FOR INSPECTION ONLY, A 24 HOUR
NOTICE IS REQUIRED AND THE
CONTRACTOR/APPLICANT IS
REQUIRED TO NOTIFY THE
WASTEWATER DIVISION AT 991-6158

☒ Sewer

Connection made to

Part of jointly-shared private line ☐ Yes ☒ No

☐ Storm Drain

Applicant agrees to abide by the above terms, as well as all pertinent ordinances of the City of New Bedford, and such other special rules as the Commissioner of Public Works may deem necessary

Lawrence D. Worsley, Commissioner of Public Works

Signature of Property Owner or Representative

INSPECTOR'S REPORT

INSPECTED BY: JOSEPH MARTIN

DATE: 8/30/01

COMMENTS:



☒ APPROVED ☐ DISAPPROVED

Signature of Inspector

SIGNATURE

31-746

P. 111
L. 165

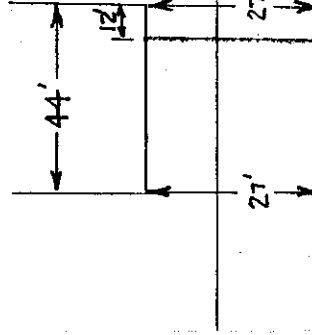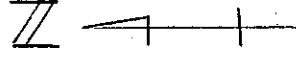

CENTRAL AVE.
SKETCH PLAN



PERMIT NO.

23093

CITY OF NEW BEDFORD

**CITY OF NEW BEDFORD
SEWER AND/OR STORM DRAIN PERMIT**

DATE 6/27/01.....

This certifies that permission is granted to

Joe Vaz 332 Conduit St. New Bedford 508-995-6818
Property Owner Address Tel.

Property Owner Address

to connect a sewer and/or storm drain located at Central Ave (N/S) 160' ± W x Condit St.
Assessor's Plot 111..., Lot 165..., to the sewer and/or storm drain in Central Ave..... Street
to be laid in accordance with the conditions in this application and the City of New Bedford ordinances.

TYPE OF USE: ☒ RESIDENTIAL ☐ COMMERCIAL ☐ INDUSTRIAL ☐ OTHER

If applicant other than actual property owner, attach Letter of Authorization from Property Owner.

Name.....Tel.....

Mailing Address.....

The Bonded Contractor/Drain Layer authorized to perform this work is:

D BAT- SANESSA	383 HOOKE RD	508-993-9608
Name	Address	Tel.

Name

Address

Tel.

Type of Pipe Required: PVC - SDR - 35
PERMIT EXPIRES ONE YEAR AFTER DATE OF ISSUE

- * Requires separate connections for sewage and storm drain where applicable. Storm water cannot be discharged to a sanitary sewer.
- * All work must be inspected and approved by a D.P.W. inspector before backfilling.
- * If this connection is to be part of a private service shared jointly with other building owners, attach copy of Recorded Joint Maintenance Agreement.
- * Permits can be issued to Industrial and/or Commercial Applicants only upon receipt and approval by the Commissioner of Public Works of required plans and supplemental information.
- * In addition, a City-issued Industrial User Discharge Permit and/or a Sewer Extension/Connection Permit issued by the Commonwealth of Massachusetts D.E.P. shall be required by the City for Industrial Discharge into the sewer system.

Industrial User Discharge Permit No.....Date.....

Comm. Mass. Sewer Conn./Ext. Permit No.....Date.....

A Filing and Inspection Fee of \$ 150.00, plus an Entrance Fee of \$ 0.00 where applicable, must accompany this application.

Bank # _____ Check # _____ Date: 6/27/01 Receipt # 4053

Other requirements: *Insp. Only ~ Connect*.....

to 10" Sewer 330 GPD

330 GPD
FOR INSPECTION ONLY, A 24 HOUR

☒ Sewer

Connection made to

Part of jointly-shared private line ☐ Yes ☒ No

☐ Storm Drain

**REQUIRED TO NOTIFY THE
WASTEWATER DIVISION AT 991-6158**

Applicant agrees to abide by the above terms, as well as all pertinent ordinances of the City of New Bedford, and such other special rules as the Commissioner of Public Works may deem necessary

Lawrence D. Warden (S)

Commissioner of Public Works

.....
Signature of Property Owner or Representative

INSPECTOR'S REPORT

INSPECTED BY:

DATE:

COMMENTS:

☐ APPROVED

☐ DISAPPROVED

SIGNATURE

SKETCH PLAN