

PERMIT NO.  
23097



CITY OF NEW BEDFORD

DATE 7-3-01

SEWER AND/OR STORM DRAIN PERMIT

This certifies that permission is granted to

02745  
CODERRE W. ADRIEN & BLANCHE 4275 ACUSHNET AVE. NB. MA.

Property Owner

Address #4275

to connect a sewer and/or storm drain located at ACUSHNET AVE (WS) 50' (H-) S. Tel. 508-995-5741-  
Assessor's Plot 136A, Lot 40, to the sewer and/or storm drain in ACUSHNET AVE - Street

to be laid in accordance with the conditions in this application and the City of New Bedford ordinances.

TYPE OF USE: ☒ RESIDENTIAL ☐ COMMERCIAL ☐ INDUSTRIAL ☐ OTHER

RECEIVED  
SEP 17 2002

If applicant other than actual property owner, attach Letter of Authorization from Property Owner. DEPT. OF PUBLIC WORKS  
NEW BEDFORD, MASS

Name..... Tel.....

Mailing Address.....

The Bonded Contractor/Drain Layer authorized to perform this work is:

JOHN GOLDA ACUSHNET TRENCHING 508 995-9819  
Name Address Tel.

Type of Pipe Required: PVC SDR 35 -

PERMIT EXPIRES ONE YEAR AFTER DATE OF ISSUE

- \* Requires separate connections for sewage and storm drain where applicable. Storm water cannot be discharged to a sanitary sewer.
- \* All work must be inspected and approved by a D.P.W. inspector before backfilling.
- \* If this connection is to be part of a private service shared jointly with other building owners, attach copy of Recorded Joint Maintenance Agreement.
- \* Permits can be issued to Industrial and/or Commercial Applicants only upon receipt and approval by the Commissioner of Public Works of required plans and supplemental information.
- \* In addition, a City-issued Industrial User Discharge Permit and/or a Sewer Extension/Connection Permit issued by the Commonwealth of Massachusetts D.E.P. shall be required by the City for Industrial Discharge into the sewer system.

Industrial User Discharge Permit No..... Date.....

Comm. Mass. Sewer Conn./Ext. Permit No..... Date.....

A Filing and Inspection Fee of \$150.00, plus an Entrance Fee of \$290.00 where applicable, must accompany this application.

Bank # COMPASS Check # 3202 Date: 7-3-01 Receipt # 4062

Other requirements: INSP ONLY TO BE CONNECTED TO # 330 GPB

STUB @ PRO LINE 29 FT @ 10" = \$290. + \$150. Sewer Permit  
TOTAL \$440.00

☒ Sewer

Connection made to Part of jointly-shared private line ☐ Yes ☒ No

☐ Storm Drain

Applicant agrees to abide by the above terms, as well as all pertinent ordinances of the City of New Bedford, and such other special rules as the Commissioner of Public Works may deem necessary

Commissioner of Public Works

Signature of Property Owner or Representative

INSPECTOR'S REPORT

INSPECTED BY: KEVIN CORNELL

DATE: 7/9/02

COMMENTS: Kevin Cornell inspected

7/9/02 from property line to house.

Stub from main to property line

installed during Sassaquin Ave. su

system project and inspected

by C.N.B.


☒ APPROVED

☐ DISAPPROVED

Kevin J Cornell

SIGNATURE

ACUSHNET AVE.

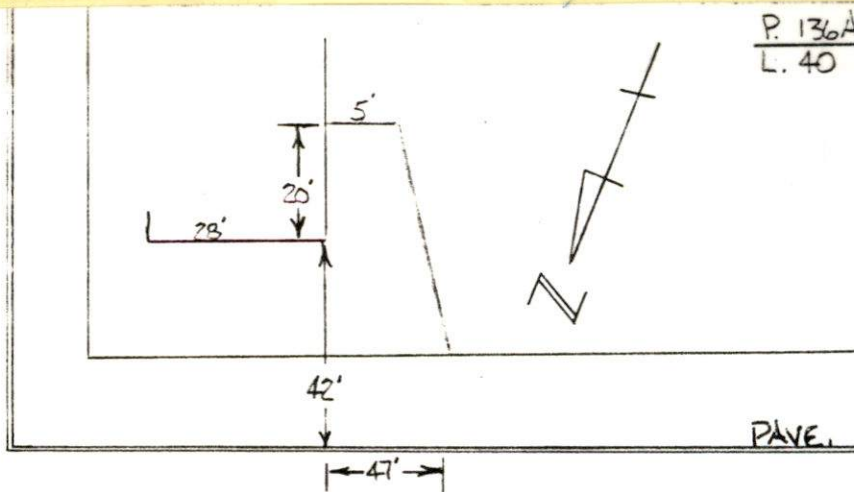

TOBEY ST.  
SKETCH PLAN



PERMIT NO.  
23097



CITY OF NEW BEDFORD

DATE 7-3-01

SEWER AND/OR STORM DRAIN PERMIT

This certifies that permission is granted to  
CODERRE W ADRIEN & BLANCHE 4275 ACUSHNET AVE. NB. MA. 02745.  
Property Owner Address Tel. 508-995-5741-  
to connect a sewer and/or storm drain located at ACUSHNET AVE (WS.) SW C / ACUSHNET & TORREY,  
Assessor's Plot. 136A, Lot. 40, to the sewer and/or storm drain in ACUSHNET AVE - Street

to be laid in accordance with the conditions in this application and the City of New Bedford ordinances.

TYPE OF USE: ☒ RESIDENTIAL ☐ COMMERICAL ☐ INDUSTRIAL ☐ OTHER

If applicant other than actual property owner, attach Letter of Authorization from Property Owner.

Name..... Tel.....

Mailing Address.....

The Bonded Contractor/Drain Layer authorized to perform this work is:

JOHN GOLDA - ACUSHNET TRENCHING 508 995-9819.  
Name Address Tel.

Type of Pipe Required: PVC - SDR 35 -

PERMIT EXPIRES ONE YEAR AFTER DATE OF ISSUE

- \* Requires separate connections for sewage and storm drain where applicable. Storm water cannot be discharged to a sanitary sewer.
- \* All work must be inspected and approved by a D.P.W. inspector before backfilling.
- \* If this connection is to be part of a private service shared jointly with other building owners, attach copy of Recorded Joint Maintenance Agreement.
- \* Permits can be issued to Industrial and/or Commercial Applicants only upon receipt and approval by the Commissioner of Public Works of required plans and supplemental information.
- \* In addition, a City-issued Industrial User Discharge Permit and/or a Sewer Extension/Connection Permit issued by the Commonwealth of Massachusetts D.E.P. shall be required by the City for Industrial Discharge into the sewer system.

Industrial User Discharge Permit No..... Date.....

Comm. Mass. Sewer Conn./Ext. Permit No..... Date.....

A Filing and Inspection Fee of \$150.00, plus an Entrance Fee of \$290.00 where applicable, must accompany this application.

Bank # COMPASS Check # 3202 Date: 7-3-01 Receipt # 4062

Other requirements: INSP ONLY TO BE CONNECTED TO A 330 GPD

STUB @ REPLINE 29' FT @ 10" = \$290. + \$150. Sewer Permit

☒ Sewer

TOTAL \$440.00

Connection made to

☐ Storm Drain

Part of jointly-shared private line ☐ Yes ☒ No

FOR INSPECTION ONLY, A 24 HOUR  
NOTICE IS REQUIRED AND THE  
CONTRACTOR/APPLICANT IS  
REQUIRED TO NOTIFY THE  
WASTEWATER DIVISION AT 991-6158

Applicant agrees to abide by the above terms, as well as all pertinent ordinances of the City of New Bedford, and such other special rules as the Commissioner of Public Works may deem necessary

Lawrence J. Warden  
Commissioner of Public Works

Adrien W. Coderre  
Signature of Property Owner or Representative

INSPECTOR'S REPORT

INSPECTED BY: \_\_\_\_\_

DATE: \_\_\_\_\_

COMMENTS: \_\_\_\_\_

\_\_\_\_\_  
\_\_\_\_\_  
\_\_\_\_\_  
\_\_\_\_\_

☐ APPROVED

☐ DISAPPROVED

SIGNATURE

SKETCH PLAN




- ① GIVE STREET NAME  
② " HOUSE NUMBER  
③ SHOW NORTH ARROW.

CODERRE, ADRIEN W. & BLANCHE L.

8/5/75 6'd.

4275 Hochsnet Ave.  
Taby St.

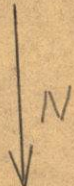

90.3'  
53.5'  
75.5'

PROP. LINE

CURB LINE (IF ANY)

29'

SEWER