

PERMIT NO.

23100



CITY OF NEW BEDFORD

SEWER AND/OR STORM DRAIN PERMIT

DATE 7-11-01

EXP 7-11-02

This certifies that permission is granted to

New Homes by Castelo Inc. 1815 Acushnet Ave. NB MA 02746

Property Owner

Address

Tel. 9956291

to connect a sewer and/or storm drain located at Worcester St. - 210' n. of Brackton St.

Assessor's Plot 127B, Lot 494, to the sewer and/or storm drain in Worcester St. Street

to be laid in accordance with the conditions in this application and the City of New Bedford ordinances.

TYPE OF USE: ☒ RESIDENTIAL ☐ COMMERICAL ☐ INDUSTRIAL ☐ OTHER

AUG - 7 2001

If applicant other than actual property owner, attach Letter of Authorization from Property Owner.

DEPT. OF PUBLIC WORKS  
NEW BEDFORD, MASS

Name.....Tel.....

Mailing Address.....

The Bonded Contractor/Drain Layer authorized to perform this work is:

R. J. Canessa 915 Hathaway Rd. NB 508 9939508

Name

Address

Tel.

Type of Pipe Required: SDR 35 (PVC)

PERMIT EXPIRES ONE YEAR AFTER DATE OF ISSUE

\* Requires separate connections for sewage and storm drain where applicable. Storm water cannot be discharged to a sanitary sewer.

\* All work must be inspected and approved by a D.P.W. inspector before backfilling.

\* If this connection is to be part of a private service shared jointly with other building owners, attach copy of Recorded Joint Maintenance Agreement.

\* Permits can be issued to Industrial and/or Commercial Applicants only upon receipt and approval by the Commissioner of Public Works of required plans and supplemental information.

\* In addition, a City-issued Industrial User Discharge Permit and/or a Sewer Extension/Connection Permit issued by the Commonwealth of Massachusetts D.E.P. shall be required by the City for Industrial Discharge into the sewer system.

Industrial User Discharge Permit No.....Date.....

Comm. Mass. Sewer Conn./Ext. Permit No.....Date.....

A Filing and Inspection Fee of \$....., plus an Entrance Fee of \$..... where applicable, must accompany this application.

Bank # Compass Check # 2499 Date: 7/11/01 Receipt # 4074

Other requirements: Inspection Only

Connect to 20" sewer

☒ Sewer

Connection made to

Part of jointly-shared private line ☐ Yes ☒ No

☐ Storm Drain

FOR INSPECTION ONLY, A 24 HOUR NOTICE IS REQUIRED AND THE CONTRACTOR/APPLICANT IS REQUIRED TO NOTIFY THE WASTEWATER DIVISION AT 991-6158

Applicant agrees to abide by the above terms, as well as all pertinent ordinances of the City of New Bedford, and such other special rules as the Commissioner of Public Works may deem necessary

Lawrence D. Worden (CM) Commissioner of Public Works

Signature of Property Owner or Representative

INSPECTOR'S REPORT

INSPECTED BY: JOSEPH MARTIN

DATE: 7/17/01


COMMENTS:

☒ APPROVED

☐ DISAPPROVED

SIGNATURE

31-746

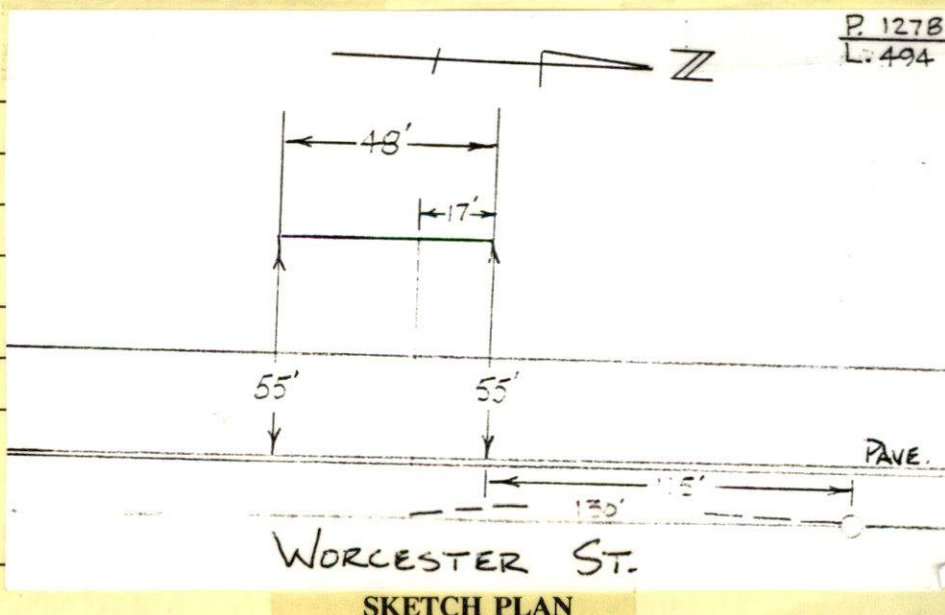



This certifies that permission is granted to  
New Homes by Castelo Inc. 1815 Acushnet Ave. NB MA 02746  
Property Owner Address Tel. 9956291

to connect a sewer and/or storm drain located at Worcester St. - 210' n. of Breckton St.  
Assessor's Plot 127B, Lot 494, to the sewer and/or ~~storm drain~~ west side in Worcester St. Street

to be laid in accordance with the conditions in this application and the City of New Bedford ordinances.

TYPE OF USE: ☒ RESIDENTIAL ☐ COMMERICAL ☐ INDUSTRIAL ☐ OTHER

If applicant other than actual property owner, attach Letter of Authorization from Property Owner.

Name.....Tel.....

Mailing Address.....

The Bonded Contractor/Drain Layer authorized to perform this work is:

R. J. Canessa 915 Hathaway Rd. NB 508 9939508  
Name Address Tel.

Type of Pipe Required: SDR 35 (PVC)

PERMIT EXPIRES ONE YEAR AFTER DATE OF ISSUE

\* Requires separate connections for sewage and storm drain where applicable. Storm water cannot be discharged to a sanitary sewer.

\* All work must be inspected and approved by a D.P.W. inspector before backfilling.

330 g.p.d.

\* If this connection is to be part of a private service shared jointly with other building owners, attach copy of Recorded Joint Maintenance Agreement.

\* Permits can be issued to Industrial and/or Commercial Applicants only upon receipt and approval by the Commissioner of Public Works of required plans and supplemental information.

\* In addition, a City-issued Industrial User Discharge Permit and/or a Sewer Extension/Connection Permit issued by the Commonwealth of Massachusetts D.E.P. shall be required by the City for Industrial Discharge into the sewer system.

Industrial User Discharge Permit No.....Date.....

Comm. Mass. Sewer Conn./Ext. Permit No.....Date.....

A Filing and Inspection Fee of \$....., plus an Entrance Fee of \$..... where applicable, must accompany this application.

Bank # Compass Check # 2499 Date: 7/11/01 Receipt # 4074

Other requirements: Inspection Only

Connect to 20" sewer

☒ Sewer

Connection made to Part of jointly-shared private line ☐ Yes ☒ No

☐ Storm Drain

FOR INSPECTION ONLY, A 24 HOUR NOTICE IS REQUIRED AND THE CONTRACTOR/APPLICANT IS REQUIRED TO NOTIFY THE WASTEWATER DIVISION AT 991-6158

Applicant agrees to abide by the above terms, as well as all pertinent ordinances of the City of New Bedford, and such other special rules as the Commissioner of Public Works may deem necessary

Lawrence D. Worden (MS)  
Commissioner of Public Works


Jose S. Castelo  
Signature of Property Owner or Representative

### INSPECTOR'S REPORT

INSPECTED BY: \_\_\_\_\_

DATE: \_\_\_\_\_

COMMENTS: \_\_\_\_\_  
\_\_\_\_\_  
\_\_\_\_\_  
\_\_\_\_\_

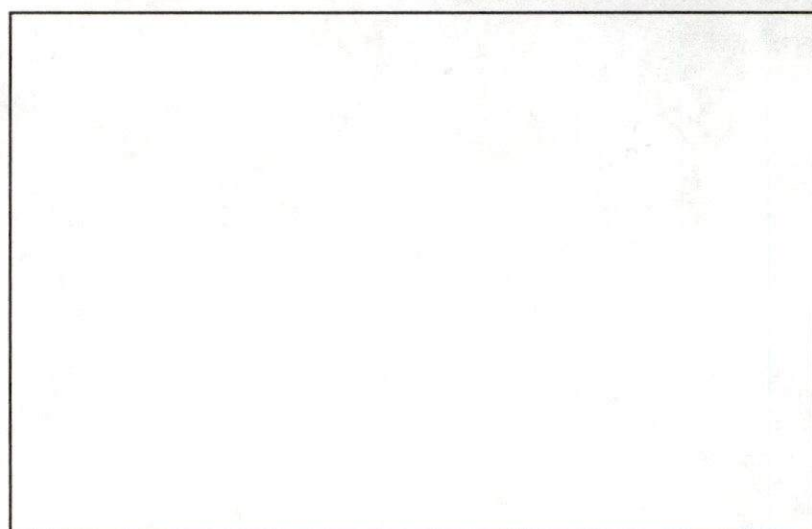

☐ APPROVED

☐ DISAPPROVED

SIGNATURE

SKETCH PLAN



Worcester

135

133

132

138

18310-64

20299-78

19133-70

BROOKTON ST.

164

SPRINGFIELD

30