

PERMIT NO.
23102



CITY OF NEW BEDFORD
SEWER AND/OR STORM DRAIN PERMIT

DATE 7/11/2001
RECEIVED
SEP 27 2001

DEPT. OF PUBLIC WORKS
NEW BEDFORD, MASS
508-995-0900

This certifies that permission is granted to
Paul Couto Bethany Couto 33 Lark St. New Bedford
Property Owner Address Tel.

to connect a sewer and/or storm drain located at Robin St. NW corner of Lark St.
Assessor's Plot 138, Lot 240, to the sewer and/or storm drain in Robin St. Street

to be laid in accordance with the conditions in this application and the City of New Bedford ordinances.

TYPE OF USE: ☒ RESIDENTIAL ☐ COMMERICAL ☐ INDUSTRIAL ☐ OTHER

B30 GPD

If applicant other than actual property owner, attach Letter of Authorization from Property Owner.

Name Paul Couto Tel. 508-995-0900
Mailing Address 33 Lark St. New Bedford MA 02745

The Bonded Contractor/Drain Layer authorized to perform this work is:

Edgar Reynolds Construction 963 Brantwood St. 508-995-1864
Name Address Tel.

Type of Pipe Required: PVC-SDR-35

PERMIT EXPIRES ONE YEAR AFTER DATE OF ISSUE

- * Requires separate connections for sewage and storm drain where applicable. Storm water cannot be discharged to a sanitary sewer.
- * All work must be inspected and approved by a D.P.W. inspector before backfilling.
- * If this connection is to be part of a private service shared jointly with other building owners, attach copy of Recorded Joint Maintenance Agreement.
- * Permits can be issued to Industrial and/or Commercial Applicants only upon receipt and approval by the Commissioner of Public Works of required plans and supplemental information.
- * In addition, a City-issued Industrial User Discharge Permit and/or a Sewer Extension/Connection Permit issued by the Commonwealth of Massachusetts D.E.P. shall be required by the City for Industrial Discharge into the sewer system.

Industrial User Discharge Permit No. _____ Date _____

Comm. Mass. Sewer Conn./Ext. Permit No. _____ Date _____

A Filing and Inspection Fee of \$ 150.00, plus an Entrance Fee of \$ 260.00 where applicable, must accompany this application.

Bank # Compass Bank Check # 1387 Date: 7/11/01 Receipt # 4069

Other requirements: Inspection Only - Connect to Existing Stub - 1/2" Port Lot - New Home
Sassaquin Ave. Sewer Proj.

☒ Sewer
Connection made to Part of jointly-shared private line ☐ Yes ☒ No
☐ Storm Drain

FOR INSPECTION ONLY, A 24 HOUR
NOTICE IS REQUIRED AND THE
CONTRACTOR/APPLICANT IS
REQUIRED TO NOTIFY THE
WASTEWATER DIVISION AT 991-6158

Applicant agrees to abide by the above terms, as well as all pertinent ordinances of the City of New Bedford, and such other special rules as the Commissioner of Public Works may deem necessary

Lawrence D. Worden
Commissioner of Public Works

X Paul J. Couto
Signature of Property Owner or Representative

INSPECTOR'S REPORT


INSPECTED BY: JOSEPH MARTIN

DATE: 9/11/01

COMMENTS: City had to install
stub because stub which supposed
was put in during Sassaquin Ave
Sewer project (1975) in actuality
was not installed so City had to
put in.


☒ APPROVED ☐ DISAPPROVED

Joseph Martin
SIGNATURE

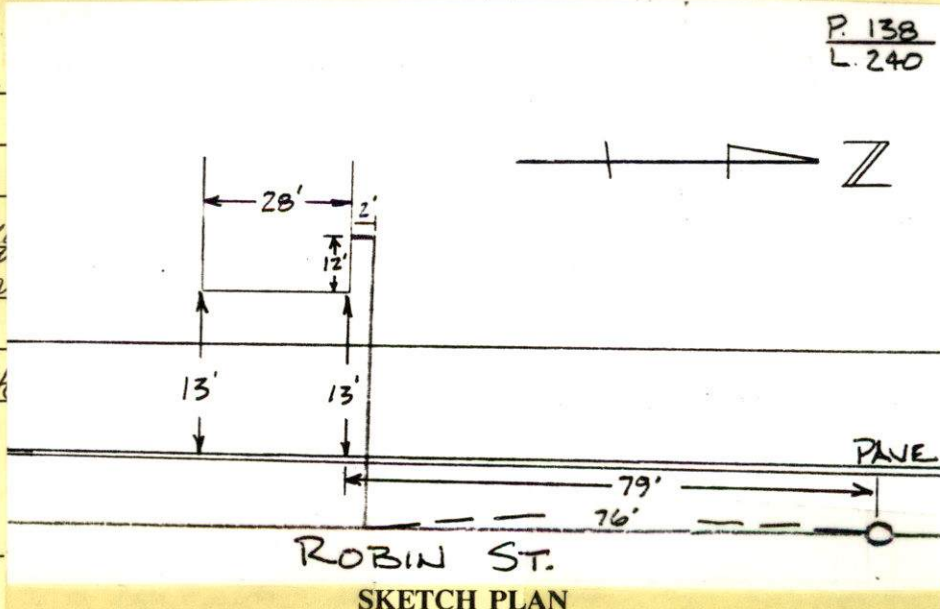

- ① GIVE STREET NAME
- ② " HOUSE NUMBER.
- ③ SHOW NORTH ARROW.

Mick S.

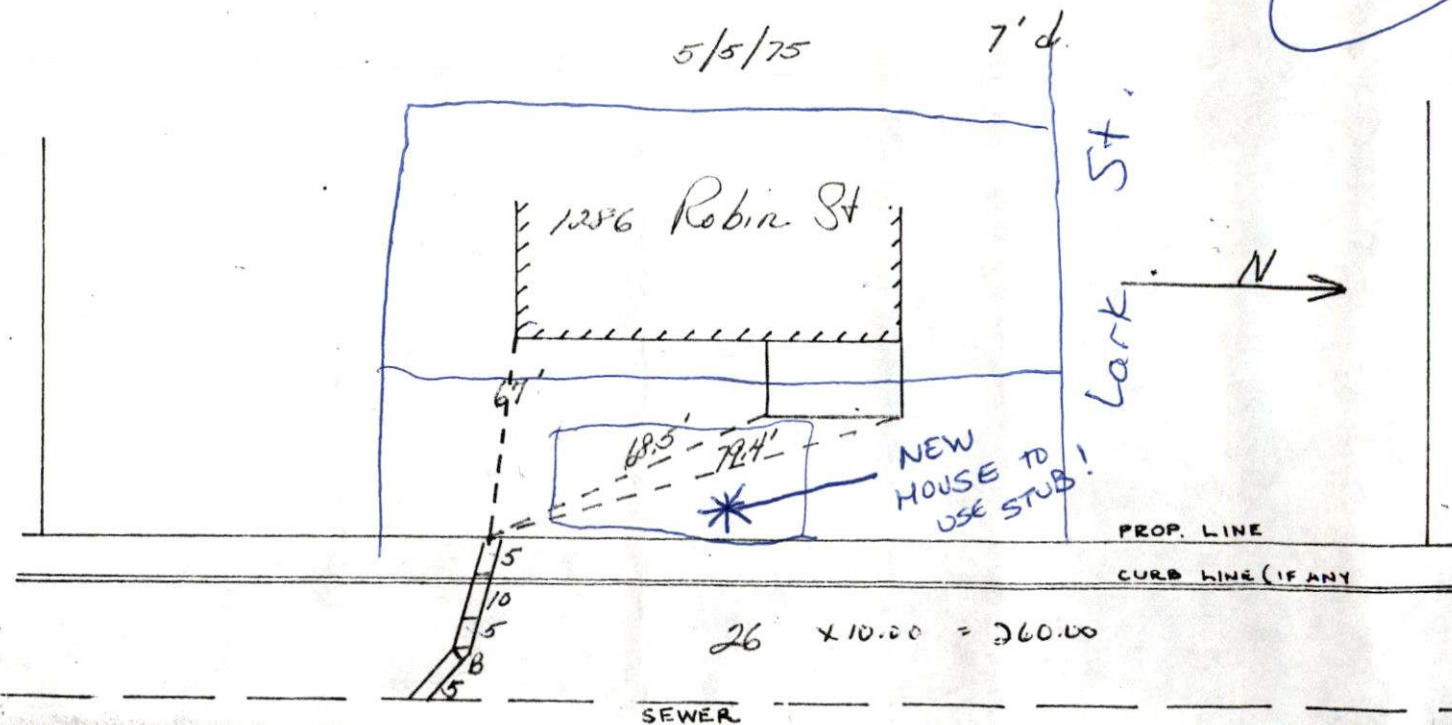



MASSACHUSETTS

DEPT. OF PUBLIC WORKS

133 WILLIAM STREET

LAWRENCE D. WORDEN
COMMISSIONER

To Whom It May Concern:

I, Bethany Couto 33 LARK Street, being
(Name) Print Mailing Address

owner of property located at Robin Street

Plot 138, Lot 240, hereby agree to allow Paul Couto
Name

33 LARK Street to act on my behalf, including affixing my signature,
Mailing Address
in securing permits for:

☒ Sewer/Drain Service Permits
☒ Water Service Permits
☐ Driveway Installation Permits
☐ Sidewalk Installation Permits

I further agree to conform to, and abide by, all City rules and ask regulations applicable to the permit (s) being applied for.

Name Bethany S Couto
(Signature)

33 LARK Street
(Address)

508 995 0900
(Date) (Telephone Number)