

PERMIT NO.
23109



CITY OF NEW BEDFORD
SEWER AND/OR STORM DRAIN PERMIT

DATE 7/17/01
EXN 7/17/02

This certifies that permission is granted to

Donna M. Belliveau 1735 Robin St. New Bedford, MA
Property Owner Address (E.S.) S. Bluff St. RECEIVED
to connect a sewer and/or storm drain located at Robin St. #1235
Assessor's Plot 138, Lot 326-327 & 337-338, to the sewer and/or storm drain in Robin Street

to be laid in accordance with the conditions in this application and the City of New Bedford ordinance.
TYPE OF USE: ☒ RESIDENTIAL ☐ COMMERCIAL ☐ INDUSTRIAL ☐ OTHER
DEPT. OF PUBLIC WORKS
NEW BEDFORD, MASS.
3306PD

If applicant other than actual property owner, attach Letter of Authorization from Property Owner.

Name Alice Roduco of Joseph G. Mello, Inc. Tel. 508-763-3158

Mailing Address P.O. Box 676, Freetown, MA 02717

The Bonded Contractor/Drain Layer authorized to perform this work is: (Pending Bonding) Stubat P.L.
Joseph G. Mello, Inc. P.O. Box 676 Freetown MA 02717 508-763-3158

Name Address Tel.

Type of Pipe Required: PVC 30" 35"

PERMIT EXPIRES ONE YEAR AFTER DATE OF ISSUE

- * Requires separate connections for sewage and storm drain where applicable. Storm water cannot be discharged to a sanitary sewer.
- * All work must be inspected and approved by a D.P.W. inspector before backfilling.
- * If this connection is to be part of a private service shared jointly with other building owners, attach copy of Recorded Joint Maintenance Agreement.
- * Permits can be issued to Industrial and/or Commercial Applicants only upon receipt and approval by the Commissioner of Public Works of required plans and supplemental information.
- * In addition, a City-issued Industrial User Discharge Permit and/or a Sewer Extension/Connection Permit issued by the Commonwealth of Massachusetts D.E.P. shall be required by the City for Industrial Discharge into the sewer system.

Industrial User Discharge Permit No. Date.
Comm. Mass. Sewer Conn./Ext. Permit No. Date.

A Filing and Inspection Fee of \$150.00, plus an Entrance Fee of \$100.00 where applicable, must accompany this application.

Bank # Citizens Bank Check # 6418 Date: 7/17/01 Receipt # 4082

Other requirements: For Michoud Only - Jansiquin Ave. Sewer Project - Stub Cost =
10' X 10' Ht = \$100.00 + Permit = \$150.00
Total = \$250.00 (Stub at Property line.)
☒ Sewer

Connection made to Part of jointly-shared private line ☐ Yes ☒ No
☐ Storm Drain

Applicant agrees to abide by the above terms, as well as all pertinent ordinances of the City of New Bedford, and such other special rules as the Commissioner of Public Works may deem necessary


Lawrence D. Warden, Inc. Commissioner of Public Works
Alice Roduco Signature of Property Owner or Representative

INSPECTOR'S REPORT

INSPECTED BY: JOSEPH MARTIN
DATE: 7/18/01
COMMENTS:

☒ APPROVED ☐ DISAPPROVED

Signature of Inspector

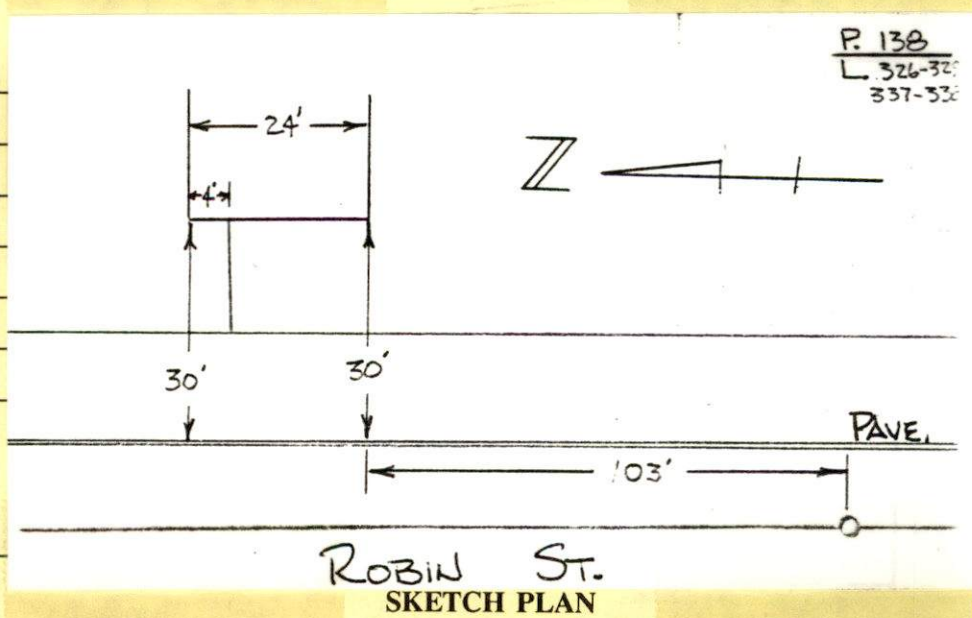

PERMIT NO.
23109



CITY OF NEW BEDFORD
SEWER AND/OR STORM DRAIN PERMIT

DATE 7/17/01
EXP 7/17/02

This certifies that permission is granted to

Donna M. Belliveau 1235 Robin St. New Bedford MA
Property Owner Address Tel. 508-995-2576

to connect a sewer and/or storm drain located at Robin St #1235
Assessor's Plot 138, Lot 326-329 & 331-338, to the sewer and/or storm drain in Robin Street

to be laid in accordance with the conditions in this application and the City of New Bedford ordinances.

TYPE OF USE: ☒ RESIDENTIAL ☐ COMMERICAL ☐ INDUSTRIAL ☐ OTHER

3306PD

If applicant other than actual property owner, attach Letter of Authorization from Property Owner.

Name Alice Pacheco of Joseph G. Mello, Inc. Tel. 508-763-3158

Mailing Address P.O. Box 676, Freetown, MA 02717

The ~~Bonded~~ Contractor/Drain Layer authorized to perform this work is: (Pending Bonding) Stubat P.L.
Joseph G. Mello Inc. P.O. Box 676 Freetown MA 02717 508-763-3158
Name Address Tel.

Type of Pipe Required: PVC SDR 35

PERMIT EXPIRES ONE YEAR AFTER DATE OF ISSUE

- * Requires separate connections for sewage and storm drain where applicable. Storm water cannot be discharged to a sanitary sewer.
- * All work must be inspected and approved by a D.P.W. inspector before backfilling.
- * If this connection is to be part of a private service shared jointly with other building owners, attach copy of Recorded Joint Maintenance Agreement.
- * Permits can be issued to Industrial and/or Commercial Applicants only upon receipt and approval by the Commissioner of Public Works of required plans and supplemental information.
- * In addition, a City-issued Industrial User Discharge Permit and/or a Sewer Extension/Connection Permit issued by the Commonwealth of Massachusetts D.E.P. shall be required by the City for Industrial Discharge into the sewer system.

Industrial User Discharge Permit No. — Date —

Comm. Mass. Sewer Conn./Ext. Permit No. — Date —

A Filing and Inspection Fee of \$ 150.00, plus an Entrance Fee of \$ 100.00 where applicable, must accompany this application.

Bank # Citizens Bank Check # 6418 Date: 7/17/01 Receipt # 4082

Other requirements: Inspection Only - Jossiquin Ave. Sewer Project - Stub Cost =

10' x 10' ft = \$100.00 + Permit = \$150.00

Total = \$ 250.00 (Stub at Property line.)

Connection made to ☒ Sewer ☐ Storm Drain Part of jointly-shared private line ☐ Yes ☒ No

Must Contact Health Dept to notify abandoning septic.

Applicant agrees to abide by the above terms, as well as all pertinent ordinances of the City of New Bedford, and such other special rules as the Commissioner of Public Works may deem necessary

Lawrence D. Worden Jr.
Commissioner of Public Works

Alice Pacheco
Signature of Property Owner or Representative

INSPECTOR'S REPORT

INSPECTED BY: _____

DATE: _____

COMMENTS: _____

☐ APPROVED ☐ DISAPPROVED

SIGNATURE

SKETCH PLAN



MASSACHUSETTS

DEPT. OF PUBLIC WORKS

133 WILLIAM STREET

LAWRENCE D. WORDEN
COMMISSIONER

To Whom It May Concern:

I, Donna M. Bellevue 1235 Robin St., being
(Name) Print Mailing Address

owner of property located at 1235 ROBIN ST. (SS) BTWN. THURST & BLUEJAY STS,
326/327/328 (NS) W/BLUEJAY-

Plot 138, Lot 29/357, hereby agree to allow Glenn Pacheco of Joseph & Melinda
338 Name

10 Herbert Road Acushnet to act on my behalf, including affixing my signature,
Mailing Address
in securing permits for:

☒ Sewer/Drain Service Permits
☐ Water Service Permits
☐ Driveway Installation Permits
☐ Sidewalk Installation Permits

I further agree to conform to, and abide by, all City rules and ask regulations applicable to the permit (s) being applied for.

Name Donna Bellevue
(signature)

1235 Robin St. W.B
(Address)

July 16, 01 (608) 995-2576
(Date) (Telephone Number)

- ① GIVE STREET NAME
- ② " HOUSE NUMBER
- ③ SHOW NORTH ARROW.

Service Stub = $10' \times \$10./ft = \100.00
Permit = $\$150.00$
 $\$250.00$

18/4/75

