

PERMIT NO.
23123



CITY OF NEW BEDFORD
SEWER AND/OR STORM DRAIN PERMIT

DATE 9/10/01
EXP. 9/10/02

This certifies that permission is granted to John F. Long
Long, John F., Inc. 158 McCombs Blvd. 115 MA 02715 (508) 995-8240
Property Owner Address # 98 Tel. 141 E. 1st Ave
to connect a sewer and/or storm drain located at Bessy St. (S.S.) 240 Street
Assessor's Plot 134, Lot 428 to the sewer and/or storm drain in Bessy Street
to be laid in accordance with the conditions in this application and the City of New Bedford ordinances.

TYPE OF USE: ☒ RESIDENTIAL ☐ COMMERICAL ☐ INDUSTRIAL ☐ OTHER 330 GPD

If applicant other than actual property owner, attach Letter of Authorization from Property Owner.

Name John F. Long, Inc. Tel. (508) 995-8240
Mailing Address Same as above

The Bonded Contractor/Drain Layer authorized to perform this work is: Stub at 12
Stub at 12
Name Long Built Home Address (508) 995-8240 Tel.

Type of Pipe Required: PVC SDR 35

PERMIT EXPIRES ONE YEAR AFTER DATE OF ISSUE

- * Requires separate connections for sewage and storm drain where applicable. Storm water cannot be discharged to a sanitary sewer.
- * All work must be inspected and approved by a D.P.W. inspector before backfilling.
- * If this connection is to be part of a private service shared jointly with other building owners, attach copy of Recorded Joint Maintenance Agreement.
- * Permits can be issued to Industrial and/or Commercial Applicants only upon receipt and approval by the Commissioner of Public Works of required plans and supplemental information.
- * In addition, a City-issued Industrial User Discharge Permit and/or a Sewer Extension/Connection Permit issued by the Commonwealth of Massachusetts D.E.P. shall be required by the City for Industrial Discharge into the sewer system.

Industrial User Discharge Permit No. Date

Comm. Mass. Sewer Conn./Ext. Permit No. Date

A Filing and Inspection Fee of \$150.00, plus an Entrance Fee of \$ where applicable, must accompany this application.

* Bank # Commerce Bank Check # 22972 Date: 9/10/01 Receipt # 4136

* Other requirements: Inspection Only - Connecting to Stub at 12 - Stub put in
by building during Bessy St. Sewer Extension

Connection made to ☒ Sewer ☐ Storm Drain
Part of jointly-shared private line ☐ Yes ☒ No

FOR INSPECTION ONLY, A 24 HOUR
NOTICE IS REQUIRED AND THE
CONTRACTOR/APPLICANT IS
REQUIRED TO NOTIFY THE
WASTEWATER DIVISION AT 991-6158

Applicant agrees to abide by the above terms, as well as all pertinent ordinances of the City of New Bedford, and such other special rules as the Commissioner of Public Works may deem necessary

Lawrence D. McCardell
Commissioner of Public Works


John F. Long
Signature of Property Owner or Representative

INSPECTOR'S REPORT

INSPECTED BY: JOSEPH MARTIN
DATE: 11/27/01
COMMENTS: Stub from main to R
put in as part of Bessy St. Sewer
main extension done under separate
Sewer permit.

☒ APPROVED ☐ DISAPPROVED

Joseph Martin
SIGNATURE

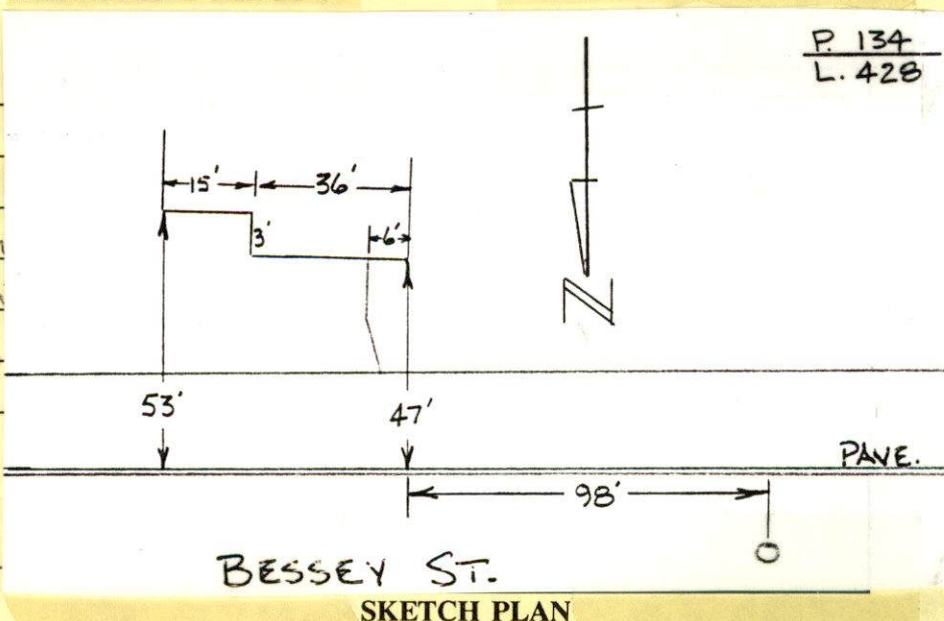

PERMIT NO.
23123



CITY OF NEW BEDFORD
SEWER AND/OR STORM DRAIN PERMIT

DATE 9/10/01
EXP 9/10/02

This certifies that permission is granted to John F. Long
Long Realty, Inc. 158 McCombs Blvd. NIS MA 02745 (508) 995-8240
Property Owner Address # 978 Tel. 740 E. 1 Acushnet Ave
to connect a sewer and/or storm drain located at Bessy St. (S.S.) Assessor's Plot 134 Lot 428 to the sewer and/or storm drain in Bessy Street
(Builder's Lot 2)
to be laid in accordance with the conditions in this application and the City of New Bedford ordinances.

TYPE OF USE: ☒ RESIDENTIAL ☐ COMMERICAL ☐ INDUSTRIAL ☐ OTHER 330 GPD

If applicant other than actual property owner, attach Letter of Authorization from Property Owner.

Name Jim Buckles of Long Built Homes Inc. Tel. (508) 995-8240 X-14
Mailing Address Same as Owner's

The Bonded Contractor/Drain Layer authorized to perform this work is: Stub at IR.
Will call us needs to submit plan/sketch showing if stub to IR.
Name Long Built Homes Address (508) 995-8240 Tel.

Type of Pipe Required: PVC SDIC 35

PERMIT EXPIRES ONE YEAR AFTER DATE OF ISSUE

- * Requires separate connections for sewage and storm drain where applicable. Storm water cannot be discharged to a sanitary sewer.
- * All work must be inspected and approved by a D.P.W. inspector before backfilling.
- * If this connection is to be part of a private service shared jointly with other building owners, attach copy of Recorded Joint Maintenance Agreement.
- * Permits can be issued to Industrial and/or Commercial Applicants only upon receipt and approval by the Commissioner of Public Works of required plans and supplemental information.
- * In addition, a City-issued Industrial User Discharge Permit and/or a Sewer Extension/Connection Permit issued by the Commonwealth of Massachusetts D.E.P. shall be required by the City for Industrial Discharge into the sewer system.

Industrial User Discharge Permit No. Date
Comm. Mass. Sewer Conn./Ext. Permit No. Date

A Filing and Inspection Fee of \$ 150.00, plus an Entrance Fee of \$ where applicable, must accompany this application.

* Bank # Compass Bank Check # 22972 Date: 9/10/01 Receipt # 4136

* Other requirements: Inspection Only - Connecting to stub at IR - Stub put in by builder during Bessy St. Sewer Extension

Connection made to ☒ Sewer ☐ Storm Drain Part of jointly-shared private line ☐ Yes ☒ No

FOR INSPECTION ONLY, A 24 HOUR NOTICE IS REQUIRED AND THE CONTRACTOR/APPLICANT IS REQUIRED TO NOTIFY THE WASTEWATER DIVISION AT 991-6158

Applicant agrees to abide by the above terms, as well as all pertinent ordinances of the City of New Bedford, and such other special rules as the Commissioner of Public Works may deem necessary

Lawrence D. Woods, Jr.
Commissioner of Public Works

James W. Buckles
Signature of Property Owner or Representative

INSPECTOR'S REPORT

INSPECTED BY:

DATE:

COMMENTS:

☐ APPROVED ☐ DISAPPROVED

SIGNATURE

SKETCH PLAN



CITY OF NEW BEDFORD
MASSACHUSETTS

DEPT. OF PUBLIC WORKS

133 WILLIAM STREET

LAWRENCE D. WORDEN
COMMISSIONER

To Whom It May Concern:

I, Long Built Homes, being
Name Mailing Address

owner of property located at LOT 1, 2, 3, 4 Bessey St +
LOT 79 Randall

Plot _____, Lot _____, hereby agree to allow Jim Buckles
Name

158 Charles McCombs Blvd to act on my behalf,
Mailing Address

New Bedford MA.
including affixing my signature, in securing permits for:

☒ Sewer/Drain Service Permits
☒ Water Service Permits
☒ Driveway Installation Permits
☒ Sidewalk Installation Permits

I further agree to confirm to, and abide by, all City rules and
regulations applicable to the permits(s) being applied for.

Long Built Homes
Name Robert Long Bestman
Print
158 Charles McCombs Blvd
Address
N.B. MA
Date 02745

