

PERMIT NO.
23127



CITY OF NEW BEDFORD

DATE... 8-28-01

SEWER AND/OR STORM DRAIN PERMIT

This certifies that permission is granted to

THADDEUS A. IRZYK - 1313 ASHLEY AVE. NB. MA. 02745.
Property Owner Address Tel. 998-3911.

to connect a sewer and/or storm drain located at ACUSHNET AVE. W.S. 250 S/VICTORIA ST.
Assessor's Plot... 120C, Lot... 747, to the sewer and/or storm drain in ACUSHNET AVE. Street
to be laid in accordance with the conditions in this application and the City of New Bedford ordinances SEP 27 2001

TYPE OF USE: ☐ RESIDENTIAL ☒ COMMERCIAL ☐ INDUSTRIAL ☐ OTHER

DEPT. OF PUBLIC WORKS
NEW BEDFORD, MASS.

If applicant other than actual property owner, attach Letter of Authorization from Property Owner.

Name... ACE ASPHALT... Tel. 999-6719
Mailing Address... 18 NANCY ST. FAIRHAVEN, MA 02719

The Bonded Contractor/Drain Layer authorized to perform this work is:

ACE ASPHALT. 18 NANCY ST. FAIRHAVEN MA. 02719
Name Address Tel.

Type of Pipe Required: PVC. SDR 35.

PERMIT EXPIRES ONE YEAR AFTER DATE OF ISSUE

- * Requires separate connections for sewage and storm drain where applicable. Storm water cannot be discharged to a sanitary sewer.
- * All work must be inspected and approved by a D.P.W. inspector before backfilling.
- * If this connection is to be part of a private service shared jointly with other building owners, attach copy of Recorded Joint Maintenance Agreement.
- * Permits can be issued to Industrial and/or Commercial Applicants only upon receipt and approval by the Commissioner of Public Works of required plans and supplemental information.
- * In addition, a City-issued Industrial User Discharge Permit and/or a Sewer Extension/Connection Permit issued by the Commonwealth of Massachusetts D.E.P. shall be required by the City for Industrial Discharge into the sewer system.

Industrial User Discharge Permit No. Date

Comm. Mass. Sewer Conn./Ext. Permit No. Date

A Filing and Inspection Fee of \$150.00, plus an Entrance Fee of \$... where applicable, must accompany this application.

Bank # SLADE FERRY Check # 3879 Date: 8-28-01 Receipt # 4123.

Other requirements: WSP ONLY

TO BE CONNECTED TO A SEWER MH IN PRIVATE PROP.

☒ Sewer

Connection made to Part of jointly-shared private line ☒ Yes ☐ No

☐ Storm Drain

Applicant agrees to abide by the above terms, as well as all pertinent ordinances of the City of New Bedford, and such other special rules as the Commissioner of Public Works may deem necessary

Commissioner of Public Works Signature of Property Owner or Representative

INSPECTOR'S REPORT


INSPECTED BY: JOSEPH MARTIN

DATE: 8/29/01

COMMENTS:

CONNECTED TO SEWER MH
ON PRIVATE PROP. -
JOINT SEWER

P 1306
L. 747

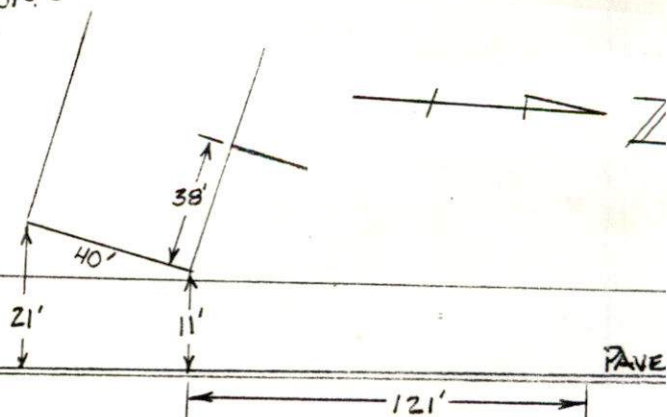

☒ APPROVED ☐ DISAPPROVED

Signature of Inspector

PERMIT NO.
23127



CITY OF NEW BEDFORD

DATE.....8-28-01.....

SEWER AND/OR STORM DRAIN PERMIT

This certifies that permission is granted to

THADDEUS A. IRZYK - 1313 ASHLEY AVE. NB. MA. 02745.
Property Owner Address Tel. 998-3911.

to connect a sewer and/or storm drain located at ACUSHNET AVE. WS. 250 S/VICTORIA ST.
Assessor's Plot. 130C, Lot. 747, to the sewer and/or storm drain in ACUSHNET AVE. Street

to be laid in accordance with the conditions in this application and the City of New Bedford ordinances.

TYPE OF USE: ☐ RESIDENTIAL ☒ COMMERICAL ☐ INDUSTRIAL ☐ OTHER

If applicant other than actual property owner, attach Letter of Authorization from Property Owner.

Name ACE ASPHALT. Tel. 999-6719.

Mailing Address 18 NANCY ST. FAIRHAVEN. MA 02719.

The Bonded Contractor/Drain Layer authorized to perform this work is:

ACE ASPHALT. 18 NANCY ST. FAIRHAVEN MA 02719.
Name Address Tel.

Type of Pipe Required: PVC SDR 35.

PERMIT EXPIRES ONE YEAR AFTER DATE OF ISSUE

- * Requires separate connections for sewage and storm drain where applicable. Storm water cannot be discharged to a sanitary sewer.
- * All work must be inspected and approved by a D.P.W. inspector before backfilling.
- * If this connection is to be part of a private service shared jointly with other building owners, attach copy of Recorded Joint Maintenance Agreement.
- * Permits can be issued to Industrial and/or Commercial Applicants only upon receipt and approval by the Commissioner of Public Works of required plans and supplemental information.
- * In addition, a City-issued Industrial User Discharge Permit and/or a Sewer Extension/Connection Permit issued by the Commonwealth of Massachusetts D.E.P. shall be required by the City for Industrial Discharge into the sewer system.

Industrial User Discharge Permit No. Date

Comm. Mass. Sewer Conn./Ext. Permit No. Date

A Filing and Inspection Fee of \$150.00, plus an Entrance Fee of \$ where applicable, must accompany this application.

Bank # STATE FERRY Check # 3879 Date: 8-28-01 Receipt # 4123.

Other requirements: INSP. ONLY -
TO BE CONNECTED TO A SEWER M.H. IN PRIVATE PROP.

☒ Sewer

Connection made to ☐ Storm Drain Part of jointly-shared private line ☒ Yes ☐ No

FOR INSPECTION ONLY, A 24 HOUR NOTICE IS REQUIRED AND THE CONTRACTOR/APPLICANT IS REQUIRED TO NOTIFY THE WASTEWATER DIVISION AT 991-6158

Applicant agrees to abide by the above terms, as well as all pertinent ordinances of the City of New Bedford, and such other special rules as the Commissioner of Public Works may deem necessary

Lawrence J. Warden
Commissioner of Public Works

Signature of Property Owner or Representative

INSPECTOR'S REPORT

INSPECTED BY: _____

DATE: _____

COMMENTS: _____

☐ APPROVED ☐ DISAPPROVED

SIGNATURE

SKETCH PLAN

JOINT SEWER MAINTENANCE AGREEMENT

In consideration of the City of New Bedford permitting

Michael Panagakos
(Names and Addresses of Owners)

to make connection to a public sewer, the said parties hereto, their heirs and/or assigns, being owners of property located at

Plot 130 C Lot 747
(Addresses and Plot & Lot Nos.)

do hereby agree to bear jointly the cost of maintaining the private sewer serving the above described properties, from the point where the individual house sewers combine into a single pipe to the point where said single pipe enters into the public sewer.

However, in cases in which the location requiring maintenance is found to be behind or above the point of connection of one or more of the above described individual house sewers, the cost shall be borne jointly by those remaining property owners which have joint use of the private sewer at such location.

WITNESS TO ALL:

Sue Rodriguez

OWNERS INVOLVED:
Michael Panagakos

COMMONWEALTH OF MASSACHUSETTS

Bristol, ss

New Bedford

8/28/01
(Date)

Then personally appeared the above named Michael Panagakos

and made oath that the above is their free act and deed,
before me Elizabeth C. Mayone

Notary Public

May 8, 2003



MASSACHUSETTS

DEPT. OF PUBLIC WORKS

133 WILLIAM STREET

LAWRENCE D. WORDEN
COMMISSIONER

To Whom It May Concern:

I, THADDEUS A IRZYKIR 1036 1st ST, being
(Name) Print Mailing Address
owner of property located at Acrehart Ave. west side 250' south of Victoria
Plot 130 C, Lot 747, hereby agree to allow Michael P. Parykko St.
Name

914 Mt. Pleasant ST, N.B. to act on my behalf, including affixing my signature,
Mailing Address
in securing permits for:

☐ Sewer/Drain Service Permits
☐ Water Service Permits
☒ Driveway Installation Permits
☐ Sidewalk Installation Permits

I further agree to conform to, and abide by, all City rules and ask regulations applicable to the permit (s) being applied for.

Name Thaddeus A. Irzyk
(signature)

1313 ASHLEY BLVD.
(Address)

3/24/01 508 9554646
(Date) (Telephone Number)

Thad's Inc.



MASSACHUSETTS

DEPT. OF PUBLIC WORKS

133 WILLIAM STREET

LAWRENCE D. WORDEN
COMMISSIONER

To Whom It May Concern:

I, Michael Panagakos, being
(Name) Print Mailing Address

owner of property located at Acushnet Avenue

Plot 130C, Lot 747, hereby agree to allow Ace Asphalt Co.
Name

18 Nancy St. Fhur. to act on my behalf, including affixing my signature,
Mailing Address
in securing permits for:

☒ Sewer/Drain Service Permits
☒ Water Service Permits
☐ Driveway Installation Permits
☐ Sidewalk Installation Permits

I further agree to conform to, and abide by, all City rules and ask regulations applicable to the permit (s) being applied for.

Name Michael Panagakos
(Signature)

(Address)

8/28/01
(Date)

99839911
(Telephone Number)