

PERMIT NO.
23131



CITY OF NEW BEDFORD
SEWER AND/OR STORM DRAIN PERMIT

DATE 9/24/01
EXP 9/24/02

This certifies that permission is granted to
Joe Tessier 1626 Padanaram Ave. New Bedford MA 02710 (508) 736-2753
Property Owner Address Tel.
to connect a sewer and/or storm drain located at Padanaram Ave. #1626 (S.S.) W. Mainville St.
Assessor's Plot 17A, Lot 107, to the sewer and/or storm drain in Padanaram Ave. Street
to be laid in accordance with the conditions in this application and the City of New Bedford ordinances.

TYPE OF USE: ☒ RESIDENTIAL ☐ COMMERICAL ☐ INDUSTRIAL ☐ OTHER

If applicant other than actual property owner, attach Letter of Authorization from Property Owner.

Name Joe August Backhoe Service Tel. (508) 758-5823
Mailing Address 345 Bridge St. Fairhaven MA 02719

DEPT. OF PUBLIC WORKS
NEW BEDFORD, MASS

The Bonded Contractor/Drain Layer authorized to perform this work is:
Joe August Backhoe Service 345 Bridge St. Fairhaven MA 02719
Name Address Tel. (508) 758-5823

Type of Pipe Required: PVC 30K 35
PERMIT EXPIRES ONE YEAR AFTER DATE OF ISSUE

- * Requires separate connections for sewage and storm drain where applicable. Storm water cannot be discharged to a sanitary sewer.
- * All work must be inspected and approved by a D.P.W. inspector before backfilling.
- * If this connection is to be part of a private service shared jointly with other building owners, attach copy of Recorded Joint Maintenance Agreement.
- * Permits can be issued to Industrial and/or Commercial Applicants only upon receipt and approval by the Commissioner of Public Works of required plans and supplemental information.
- * In addition, a City-issued Industrial User Discharge Permit and/or a Sewer Extension/Connection Permit issued by the Commonwealth of Massachusetts D.E.P. shall be required by the City for Industrial Discharge into the sewer system.

Industrial User Discharge Permit No. Date
Comm. Mass. Sewer Conn./Ext. Permit No. Date

A Filing and Inspection Fee of \$150.00, plus an Entrance Fee of \$ where applicable, must accompany this application.

Bank # Starks Bank Check # 3908 Date: 9/24/01 Receipt # 41172

Other requirements: Inspection Only - Abandoning Septic System and tying in
to 12" main in street. Must contact Health Dept. to make arrangements for cut application to abandon septic.
☐ Sewer ☒ Storm Drain

Connection made to Part of jointly-shared private line ☐ Yes ☒ No

FOR INSPECTION ONLY, A 24 HOUR NOTICE IS REQUIRED AND THE CONTRACTOR/APPLICANT IS REQUIRED TO NOTIFY THE WASTEWATER DIVISION AT 991-6158

Applicant agrees to abide by the above terms, as well as all pertinent ordinances of the City of New Bedford, and such other special rules as the Commissioner of Public Works may deem necessary

Lawrence D. Wrentham
Commissioner of Public Works
Signature of Property Owner or Representative

INSPECTOR'S REPORT


INSPECTED BY: JOSEPH MARTIN
DATE: 10/9/01
COMMENTS:



P. 17A
L. 107

☒ APPROVED ☐ DISAPPROVED

Signature of Joseph Martin

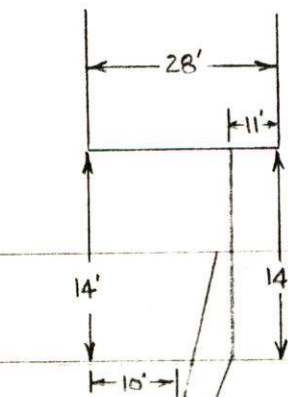

PADANARAM AVE.
SKETCH PLAN

PERMIT NO.

23131



CITY OF NEW BEDFORD

SEWER AND/OR STORM DRAIN PERMIT

DATE 9/24/01
EXP 9/24/02

This certifies that permission is granted to

Joy Tessier 1626 Padanaram Ave., New Bedford MA 02740 (508) 736-2253
Property Owner Address Tel.

to connect a sewer and/or storm drain located at Padanaram Ave. #1626 (S.S.) W. / Norwell St.
Assessor's Plot 17A, Lot 107, to the sewer and/or storm drain in Padanaram Ave. Street

to be laid in accordance with the conditions in this application and the City of New Bedford ordinances.

TYPE OF USE: ☒ RESIDENTIAL ☐ COMMERICAL ☐ INDUSTRIAL ☐ OTHER

330 GPD

If applicant other than actual property owner, attach Letter of Authorization from Property Owner.

Name Joe August Backhoe Service Tel. (508) 994-1493

Mailing Address 345 Bridge St. Fairhaven MA 02719

The Bonded Contractor/Drain Layer authorized to perform this work is:

Joe August Backhoe Service 345 Bridge St. Fairhaven MA 02719
Name Address

Type of Pipe Required: PVC SDK 35 Tel. Cell: (508) 958-583

PERMIT EXPIRES ONE YEAR AFTER DATE OF ISSUE

- * Requires separate connections for sewage and storm drain where applicable. Storm water cannot be discharged to a sanitary sewer.
- * All work must be inspected and approved by a D.P.W. inspector before backfilling.
- * If this connection is to be part of a private service shared jointly with other building owners, attach copy of Recorded Joint Maintenance Agreement.
- * Permits can be issued to Industrial and/or Commercial Applicants only upon receipt and approval by the Commissioner of Public Works of required plans and supplemental information.
- * In addition, a City-issued Industrial User Discharge Permit and/or a Sewer Extension/Connection Permit issued by the Commonwealth of Massachusetts D.E.P. shall be required by the City for Industrial Discharge into the sewer system.

Industrial User Discharge Permit No. _____ Date _____

Comm. Mass. Sewer Conn./Ext. Permit No. _____ Date _____

A Filing and Inspection Fee of \$150.00, plus an Entrance Fee of \$ _____ where applicable, must accompany this application.

Bank # Slacks Ferry Bank Check # 3908 Date: 9/24/01 Receipt # 4142

Other requirements: Inspection Only - Abandoning septic system and tying in

work 12" main in street. Must contact Health Dept. to make arrangements to fill out application to abandon septic.

Connection made to ☒ Sewer ☐ Storm Drain Part of jointly-shared private line ☐ Yes ☒ No

Must run stub for storm main to pwp. line from 10' S.D.

Applicant agrees to abide by the above terms, as well as all pertinent ordinances of the City of New Bedford, and such other special rules as the Commissioner of Public Works may deem necessary

Lawrence D. Worden, Jr.
Commissioner of Public Works

X Joe August
Signature of Property Owner or Representative

INSPECTOR'S REPORT

INSPECTED BY: _____

DATE: _____

COMMENTS: _____

☐ APPROVED

☐ DISAPPROVED

SIGNATURE

SKETCH PLAN



MASSACHUSETTS

DEPT. OF PUBLIC WORKS

133 WILLIAM STREET

LAWRENCE D. WORDEN
COMMISSIONER

To Whom It May Concern:

I, Joy Tessie 1626 Padanaram Ave N.B. being
(Name) (Address)
owner of property located at 1626 Padanaram Ave New Bedford m.
Plot 17 A, Lot 107, hereby agree to allow Joe August Backhoe Service
(Name)

345 Budge St. Phn, MA 02749 to act on my behalf, including affixing my signature,
(Mailing Address)
in securing permits for:

- ☒ Sewer/Drain Service Permits
- ☐ Water Service Permits
- ☐ Driveway Installation Permits
- ☐ Sidewalk Installation Permits

I further agree to conform to, and abide by, all City rules and ask regulations applicable to the permit (s) being applied for.

Name

Joy Tessie
(Signature)

1626 Padanaram Ave N.B.
(Address)

9/2/01
(Date)

508-736-2253
(Telephone Number)