

PERMIT NO.

23157



CITY OF NEW BEDFORD

DATE.....11/21/01.....

SEWER AND/OR STORM DRAIN PERMIT

This certifies that permission is granted to

T.M.P. - DEVELOPMENT - 24 JOCELYN ST. NB. 02745.  
 Property Owner Address #9 Tel. 508-998-2969.

to connect a sewer and/or storm drain located at VERNON ST WS. 75'± N/BROOKLAWN ST.  
 Assessor's Plot 117..., Lot 72..., to the sewer and/or storm drain in VERNON ST Street

to be laid in accordance with the conditions in this application and the City of New Bedford ordinance.

TYPE OF USE: ☒ RESIDENTIAL ☐ COMMERICAL ☐ INDUSTRIAL ☐ OTHER Bridge St.

If applicant other than actual property owner, attach Letter of Authorization from Property Owner.

Name..... Tel.....

Mailing Address.....

The Bonded Contractor/Drain Layer authorized to perform this work is:

R.T. CANESSA (508) 993-9508  
 Name Address Tel.

Type of Pipe Required: PVC SDR 35

PERMIT EXPIRES ONE YEAR AFTER DATE OF ISSUE

- \* Requires separate connections for sewage and storm drain where applicable. Storm water cannot be discharged to a sanitary sewer.
- \* All work must be inspected and approved by a D.P.W. inspector before backfilling.
- \* If this connection is to be part of a private service shared jointly with other building owners, attach copy of Recorded Joint Maintenance Agreement.
- \* Permits can be issued to Industrial and/or Commercial Applicants only upon receipt and approval by the Commissioner of Public Works of required plans and supplemental information.
- \* In addition, a City-issued Industrial User Discharge Permit and/or a Sewer Extension/Connection Permit issued by the Commonwealth of Massachusetts D.E.P. shall be required by the City for Industrial Discharge into the sewer system.

Industrial User Discharge Permit No..... Date.....

Comm. Mass. Sewer Conn./Ext. Permit No..... Date.....

A Filing and Inspection Fee of \$ 150.00..., plus an Entrance Fee of \$..... where applicable, must accompany this application.

Bank # CITIZEN'S BANK Check # 174 Date: 11-20-01 Receipt # 4195

Other requirements: INSPECTION ONLY - 330611

TO BE CONNECTED TO: 10" SEWER & 10" SURF DRAIN

Connection made to ☒ 10" Sewer ☒ 10" Storm Drain Part of jointly-shared private line ☐ Yes ☒ No

Applicant agrees to abide by the above terms, as well as all pertinent ordinances of the City of New Bedford, and such other special rules as the Commissioner of Public Works may deem necessary

Laurence J. Warden Commissioner of Public Works  
[Signature] Signature of Property Owner or Representative

INSPECTOR'S REPORT


INSPECTED BY: JOSEPH MARTIN

DATE: 12/6/01

COMMENTS:

☒ APPROVED ☐ DISAPPROVED

Joseph Martin  
 SIGNATURE

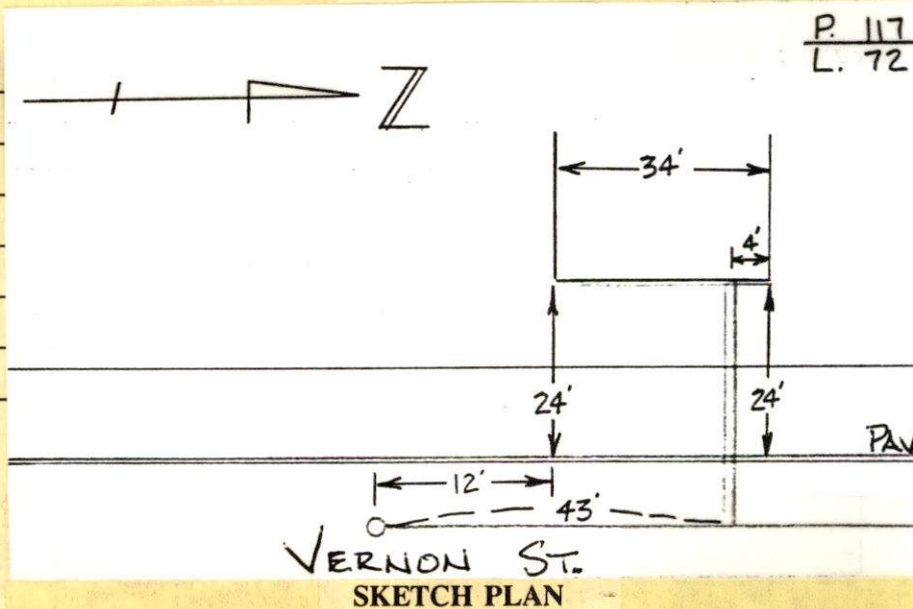

P. 117  
 L. 72



PERMIT NO.

23157



CITY OF NEW BEDFORD

DATE 11/21/01

SEWER AND/OR STORM DRAIN PERMIT

This certifies that permission is granted to  
J.M.P. - DEVELOPMENT - 24 JOCELYN ST. NB. 02745.  
Property Owner Address Tel. 508-998-2969.

to connect a sewer and/or storm drain located at 10 VERNON ST. WS. 75'± N/BROOKLAWN ST.  
Assessor's Plot 117, Lot 72, to the sewer and/or storm drain in VERNON ST. Street  
to be laid in accordance with the conditions in this application and the City of New Bedford ordinances.

TYPE OF USE: ☒ RESIDENTIAL ☐ COMMERICAL ☐ INDUSTRIAL ☐ OTHER

If applicant other than actual property owner, attach Letter of Authorization from Property Owner.

Name Mailing Address Tel.

The Bonded Contractor/Drain Layer authorized to perform this work is:

R.J. CANESSA - (508) 993-9508  
Name Address Tel.

Type of Pipe Required: PVC - SDR 35  
PERMIT EXPIRES ONE YEAR AFTER DATE OF ISSUE

- \* Requires separate connections for sewage and storm drain where applicable. Storm water cannot be discharged to a sanitary sewer.
- \* All work must be inspected and approved by a D.P.W. inspector before backfilling.
- \* If this connection is to be part of a private service shared jointly with other building owners, attach copy of Recorded Joint Maintenance Agreement.
- \* Permits can be issued to Industrial and/or Commercial Applicants only upon receipt and approval by the Commissioner of Public Works of required plans and supplemental information.
- \* In addition, a City-issued Industrial User Discharge Permit and/or a Sewer Extension/Connection Permit issued by the Commonwealth of Massachusetts D.E.P. shall be required by the City for Industrial Discharge into the sewer system.

Industrial User Discharge Permit No. Date  
Comm. Mass. Sewer Conn./Ext. Permit No. Date

A Filing and Inspection Fee of \$150.00, plus an Entrance Fee of \$ where applicable, must accompany this application.

Bank # CITIZEN'S BANK Check # 174 Date 11-20-01 Receipt # 4195

Other requirements: INS. ONLY - 3306PD 3306PD

TO BE CONNECTED TO: 10" Sewer & 10" SURF DRAIN.  
10" ☒ Sewer  
Connection made to Part of jointly-shared private line ☐ Yes ☒ No  
10" ☒ Storm Drain  
FOR INSPECTION ONLY, A 24 HOUR NOTICE IS REQUIRED AND THE CONTRACTOR/APPLICANT IS REQUIRED TO NOTIFY THE WASTEWATER DIVISION AT 991-6158


Applicant agrees to abide by the above terms, as well as all pertinent ordinances of the City of New Bedford, and such other special rules as the Commissioner of Public Works may deem necessary

Lawrence J. Wooden Jr. Commissioner of Public Works  
Signature of Property Owner or Representative

INSPECTOR'S REPORT

INSPECTED BY: \_\_\_\_\_  
DATE: \_\_\_\_\_  
COMMENTS: \_\_\_\_\_  
\_\_\_\_\_  
\_\_\_\_\_  
\_\_\_\_\_  
\_\_\_\_\_  
☐ APPROVED ☐ DISAPPROVED

SIGNATURE

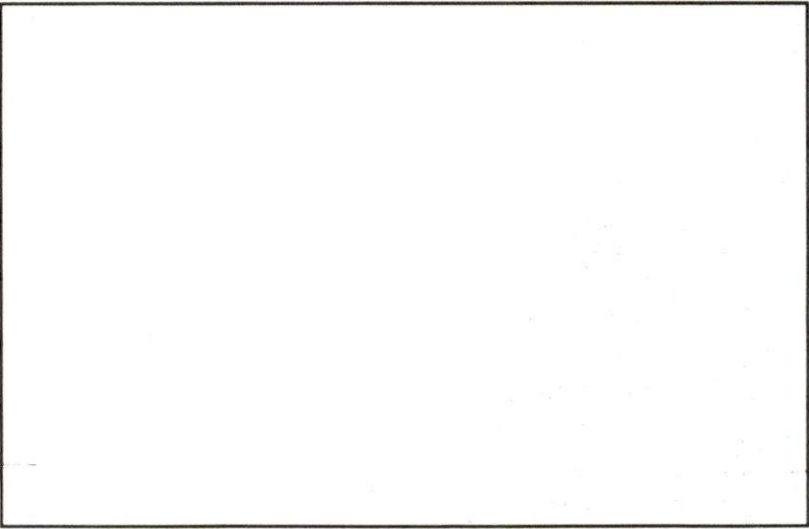

SKETCH PLAN



51.78'

42'

MAP 117 LOT 72  
4,838 Sq.Ft.

60.06'

7'

60.00'

13'

TOP OF FOUNDATION  
ELEV. 102.8

13'


15'

15'

55.74'

VERNON STREET

Driveway

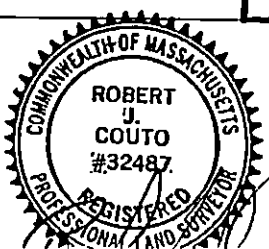

x100.0(=)

10" SEWER

100' GRADE SHOWN