

PERMIT NO.

23161



CITY OF NEW BEDFORD

DATE 11/21/01

SEWER AND/OR STORM DRAIN PERMIT

This certifies that permission is granted to

Margaret R. Martin 15 Ken Petty Dr. Assonet, MA 508-644-2039
 Property Owner Address Tel

to connect a sewer and/or storm drain located at Sunset St. (SE. corn. of Hathaway Rd.
 Assessor's Plot 80, Lot 66, to the sewer and/or storm drain in Sunset St. Street

to be laid in accordance with the conditions in this application and the City of New Bedford ordinances.

TYPE OF USE: ☒ RESIDENTIAL ☐ COMMERICAL ☐ INDUSTRIAL ☐ OTHER

RECEIVED

If applicant other than actual property owner, attach Letter of Authorization from Property Owner.

OCT 22 2002

Name Tel.

Mailing Address DEPT. OF PUBLIC WORKS NEW BEDFORD, MASS.

The Bonded Contractor/Drain Layer authorized to perform this work is:

Name (will call with Contractor around April) Address Tel.

Type of Pipe Required: PVC - SDR - 35

PERMIT EXPIRES ONE YEAR AFTER DATE OF ISSUE

- * Requires separate connections for sewage and storm drain where applicable. Storm water cannot be discharged to a sanitary sewer.
- * All work must be inspected and approved by a D.P.W. inspector before backfilling.
- * If this connection is to be part of a private service shared jointly with other building owners, attach copy of Recorded Joint Maintenance Agreement.
- * Permits can be issued to Industrial and/or Commercial Applicants only upon receipt and approval by the Commissioner of Public Works of required plans and supplemental information.
- * In addition, a City-issued Industrial User Discharge Permit and/or a Sewer Extension/Connection Permit issued by the Commonwealth of Massachusetts D.E.P. shall be required by the City for Industrial Discharge into the sewer system.

Industrial User Discharge Permit No. Date.

Comm. Mass. Sewer Conn./Ext. Permit No. Date.

A Filing and Inspection Fee of \$150.00, plus an Entrance Fee of \$550.00 where applicable, must accompany this application.

Bank # Hanscom Federal Credit Union Check # 1060 Date: 11/21/01 Receipt # 4198

Other requirements: Insp. Only, Stub at Property Line
 25' Stub @ \$22.00/ft = 550.00 (4 ft. deep stub)

☒ Sewer

330 GPD

Connection made to Part of jointly-shared private line ☐ Yes ☒ No

☐ Storm Drain

Applicant agrees to abide by the above terms, as well as all pertinent ordinances of the City of New Bedford, and such other special rules as the Commissioner of Public Works may deem necessary

Lawrence D. Worden
 Commissioner of Public Works

Signature of Property Owner or Representative

INSPECTOR'S REPORT

INSPECTED BY: KEN REBELLO

DATE: 7/19/02


COMMENTS: Ken inspected from
 Stub to house. Stub installed
 for Hathaway Rd. Sewer proj.
 by City of N.B.

☒ APPROVED

☐ DISAPPROVED

Ken Rebello

SIGNATURE

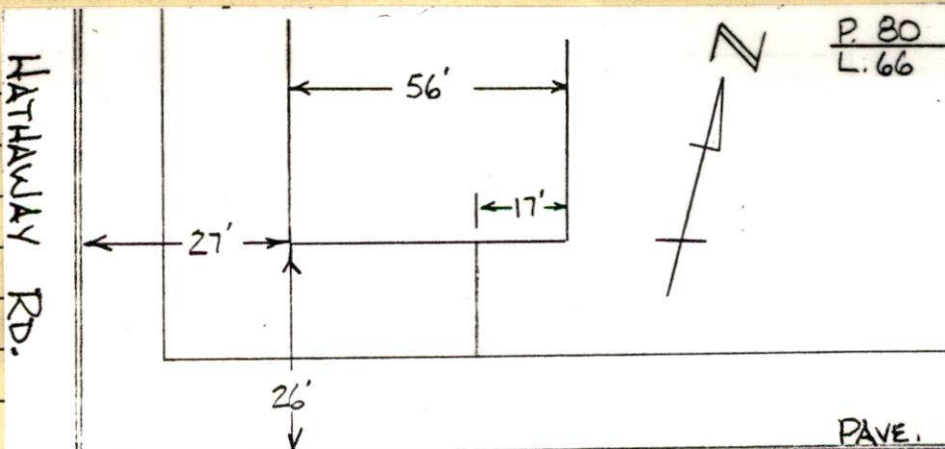

SUNSET ST.
 SKETCH PLAN

PERMIT NO.
23161



CITY OF NEW BEDFORD

DATE 11/21/01

SEWER AND/OR STORM DRAIN PERMIT

This certifies that permission is granted to

Margaret R. Martin 15 Ken Petty Dr. Assonet, MA 508-644-2039
Property Owner Address Tel.

to connect a sewer and/or storm drain located at Sunset St. (SE corn. of Hathaway Rd.
Assessor's Plot 80, Lot 66, to the sewer and/or storm drain in Sunset St. Street

to be laid in accordance with the conditions in this application and the City of New Bedford ordinances.

TYPE OF USE: ☒ RESIDENTIAL ☐ COMMERICAL ☐ INDUSTRIAL ☐ OTHER

If applicant other than actual property owner, attach Letter of Authorization from Property Owner.

Name Tel.

Mailing Address.

The ~~Bonded~~ Contractor/Drain Layer authorized to perform this work is:

COSTA PLUMBING LLC
Name (will call with Contractor around April) Address Tel.

Type of Pipe Required: PVC - SDR-35

PERMIT EXPIRES ONE YEAR AFTER DATE OF ISSUE

* Requires separate connections for sewage and storm drain where applicable. Storm water cannot be discharged to a sanitary sewer.

* All work must be inspected and approved by a D.P.W. inspector before backfilling.

* If this connection is to be part of a private service shared jointly with other building owners, attach copy of Recorded Joint Maintenance Agreement.

* Permits can be issued to Industrial and/or Commercial Applicants only upon receipt and approval by the Commissioner of Public Works of required plans and supplemental information.

* In addition, a City-issued Industrial User Discharge Permit and/or a Sewer Extension/Connection Permit issued by the Commonwealth of Massachusetts D.E.P. shall be required by the City for Industrial Discharge into the sewer system.

Industrial User Discharge Permit No. Date.

Comm. Mass. Sewer Conn./Ext. Permit No. Date.

A Filing and Inspection Fee of \$150.00, plus an Entrance Fee of \$550.00 where applicable, must accompany this application.

Bank # Hanscom Federal Credit Union Check # 1060 Date: 11/21/01 Receipt # 4198

Other requirements: Insp. Only, Stub at Property Line

25' Stub @ \$22.00/LF = 550.00 (4 ft. deep stub)

☒ Sewer 330 GPD
Connection made to Part of jointly-shared private line ☐ Yes ☒ No
☐ Storm Drain

Applicant agrees to abide by the above terms, as well as all pertinent ordinances of the City of New Bedford, and such other special rules as the Commissioner of Public Works may deem necessary

Lawrence D. Worden
Commissioner of Public Works

[Signature]
Signature of Property Owner or Representative

INSPECTOR'S REPORT

INSPECTED BY: _____

DATE: _____

COMMENTS: _____

☐ APPROVED ☐ DISAPPROVED

SIGNATURE

SKETCH PLAN



MASSACHUSETTS

DEPT. OF PUBLIC WORKS

133 WILLIAM STREET

LAWRENCE D. WARDEN
COMMISSIONER

To Whom It May Concern:

I, Margaret R. Martin 15 Ken Petty Dr Assonet Ma 02702, being
(Name) (Address)

owner of property located at Corner of Hathaway Rd + Sunset St.

Plot 80, Lot 66, hereby agree to allow Robert G. Martin
(Name)

15 Ken Petty Dr Assonet MA to act on my behalf, including affixing my signature,
(Address)
in securing permits for:

☒ Sewer/Drain Service Permits
☐ Water Service Permits
☐ Driveway Installation Permits
☐ Sidewalk Installation Permits

I further agree to conform to, and abide by, all City rules and ask regulations applicable to the permit (s) being applied for.

Name Margaret R. Martin
(Signature)
15 Ken Petty Dr. Assonet, Ma.
(Address)
11/21/01 508-644-2039
(Date) (Telephone Number)

\$
700

25
22
50
50
550.00
150