

PERMIT NO.

23163



CITY OF NEW BEDFORD

SEWER AND/OR STORM DRAIN PERMIT

DATE 11/30/01

EXP 11/30/02

This certifies that permission is granted to

Anthony W. Enos 3914 Acushnet Ave. N.B. MA 02715 (508) 995-4276

Property Owner

Address

Tel.

to connect a sewer and/or storm drain located at Acushnet Ave. # 3914

Assessor's Plot 136, Lot 257, to the sewer and/or storm drain in Acushnet Ave. Street

to be laid in accordance with the conditions in this application and the City of New Bedford ordinances.

TYPE OF USE: ☒ RESIDENTIAL ☐ COMMERICAL ☐ INDUSTRIAL ☐ OTHER

If applicant other than actual property owner, attach Letter of Authorization from Property Owner.

RECEIVED

Name N/A Tel. FEB 20 2002

Mailing Address DEPT. OF PUBLIC WORKS NEW BEDFORD, MASS.

The Bonded Contractor/Drain Layer authorized to perform this work is: Stub at R.R.

South coast Bobcat & Excavation, Ken Letourneau (508) 991-7887

Name

Address

Tel.

Type of Pipe Required: PVC SDR 35

PERMIT EXPIRES ONE YEAR AFTER DATE OF ISSUE

* Requires separate connections for sewage and storm drain where applicable. Storm water cannot be discharged to a sanitary sewer.

* All work must be inspected and approved by a D.P.W. inspector before backfilling.

* If this connection is to be part of a private service shared jointly with other building owners, attach copy of Recorded Joint Maintenance Agreement.

* Permits can be issued to Industrial and/or Commercial Applicants only upon receipt and approval by the Commissioner of Public Works of required plans and supplemental information.

* In addition, a City-issued Industrial User Discharge Permit and/or a Sewer Extension/Connection Permit issued by the Commonwealth of Massachusetts D.E.P. shall be required by the City for Industrial Discharge into the sewer system.

Industrial User Discharge Permit No. Date.

Comm. Mass. Sewer Conn./Ext. Permit No. Date.

A Filing and Inspection Fee of \$150.00, plus an Entrance Fee of \$725.00 where applicable, must accompany this application.

Bank # First Citizens Check # 123 Date: 11/30/01 Receipt # 4206

Other requirements: Inspection Only - Acushnet Ave. Sewer Proj. II (Stub = 25.5ft x 39ft = \$725.00; Permit Fee = \$150.00; Total = \$875.00)

☒ Sewer

Connection made to

Part of jointly-shared private line ☐ Yes ☒ No

☐ Storm Drain

FOR INSPECTION ONLY, A 24 HOUR NOTICE IS REQUIRED AND THE CONTRACTOR/APPLICANT IS REQUIRED TO NOTIFY THE WASTEWATER DIVISION AT 991-6158

Applicant agrees to abide by the above terms, as well as all pertinent ordinances of the City of New Bedford, and such other special rules as the Commissioner of Public Works may deem necessary

Lawrence D. Whelan, Jr. Commissioner of Public Works

Anthony W. Enos Signature of Property Owner or Representative

INSPECTOR'S REPORT

INSPECTED BY: JOSEPH MARTIN

DATE: 1/14/02

COMMENTS: Inspected by Joseph Martin on 1/14/02 from stub to house. Stub installed during Acushnet Ave. Sewer proj. II

☒ APPROVED


☐ DISAPPROVED

SIGNATURE

31-746



P. 136 L. 257

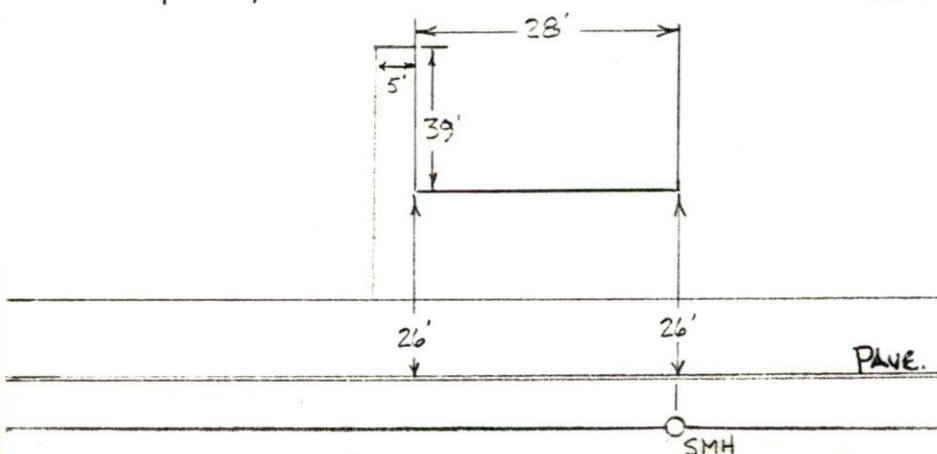

ACUSHNET AVE
SKETCH PLAN

PERMIT NO.

23163



CITY OF NEW BEDFORD

DATE 11/30/01
EXP 11/30/02

SEWER AND/OR STORM DRAIN PERMIT

This certifies that permission is granted to

Anthony W. Enos 3914 Acushnet Ave N.B. MA 02745 (508) 995-4276
Property Owner Address Tel.

to connect a sewer and/or storm drain located at Acushnet Ave. # 3914
Assessor's Plot 136, Lot 257, to the sewer and/or storm drain in Acushnet Ave. Street
to be laid in accordance with the conditions in this application and the City of New Bedford ordinances.

TYPE OF USE: ☒ RESIDENTIAL ☐ COMMERICAL ☐ INDUSTRIAL ☐ OTHER

3306RD

If applicant other than actual property owner, attach Letter of Authorization from Property Owner.

Name N/A Tel.

Mailing Address.

The Bonded Contractor/Drain Layer authorized to perform this work is: Sub at R.

South Coast Bobcat & Excavation, Ken Letourneau, (508) 991-7887
Name Address Tel.

Type of Pipe Required: PVC SDR 35

PERMIT EXPIRES ONE YEAR AFTER DATE OF ISSUE

* Requires separate connections for sewage and storm drain where applicable. Storm water cannot be discharged to a sanitary sewer.

* All work must be inspected and approved by a D.P.W. inspector before backfilling.

* If this connection is to be part of a private service shared jointly with other building owners, attach copy of Recorded Joint Maintenance Agreement.

* Permits can be issued to Industrial and/or Commercial Applicants only upon receipt and approval by the Commissioner of Public Works of required plans and supplemental information.

* In addition, a City-issued Industrial User Discharge Permit and/or a Sewer Extension/Connection Permit issued by the Commonwealth of Massachusetts D.E.P. shall be required by the City for Industrial Discharge into the sewer system.

Industrial User Discharge Permit No. Date.

Comm. Mass. Sewer Conn./Ext. Permit No. Date.

A Filing and Inspection Fee of \$150.00, plus an Entrance Fee of \$725.00 where applicable, must accompany this application.

Bank # First Citizens Check # 123 Date: 11/30/01 Receipt # 4206

Other requirements: Inspection Only - Acushnet Ave. Sewer Proj. II (Stub = 25.4' x 29.4' = \$725.00; Permit Fee = \$150.00; Total = \$875.00)

☒ Sewer

Connection made to

☐ Storm Drain

Part of jointly-shared private line ☐ Yes ☒ No

FOR INSPECTION ONLY, A 24 HOUR NOTICE IS REQUIRED AND THE CONTRACTOR/APPLICANT IS REQUIRED TO NOTIFY THE WASTEWATER DIVISION AT 991-6158

Applicant agrees to abide by the above terms, as well as all pertinent ordinances of the City of New Bedford, and such other special rules as the Commissioner of Public Works may deem necessary

Lawrence D. Warden / asr
Commissioner of Public Works

Anthony W. Enos
Signature of Property Owner or Representative

INSPECTOR'S REPORT

INSPECTED BY: _____

DATE: _____

COMMENTS: _____

☐ APPROVED

☐ DISAPPROVED

SIGNATURE

SKETCH PLAN

6/3/97

ACOSHNET AVE

PR CITY
65°

LA BONNE BROS.

2 DYNA Hoes

1 Loader

2 DUFFS

2 UTILITY TROWELS

1 BOWL

2 OFFSHOOTS

2 L. B. TROWS


2 POLICE VEHICLES

JOE CORREIA #3780

7:00

30' 6IN
6' DEEP

3888

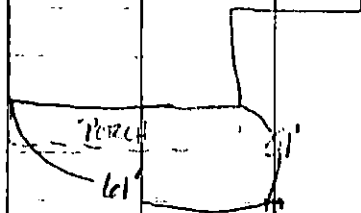


* 121' 6IN

(132)


32' 6IN
6.5' DEEP

3894

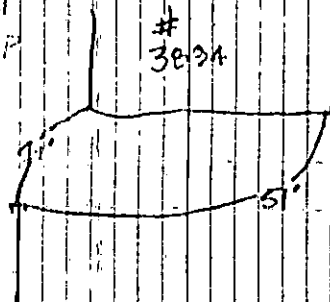


29' 6IN
6.5' DEEP

3814

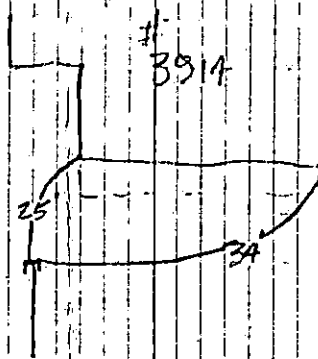

30' 6IN
6' 7.5' DEEP

3813

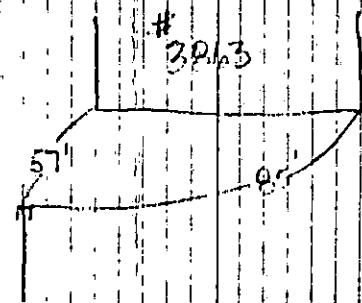

(133)