

Must connect to storm!

PERMIT NO.

23166



CITY OF NEW BEDFORD

DATE 12/10/01  
EXP 12/10/02

SEWER AND/OR STORM DRAIN PERMIT

This certifies that permission is granted to

JOSE M. Vaz, 232 Conduit St. New Bedford MA 02745 (508) 326-8666  
Property Owner Address Tel. 678-4119 Work

to connect a sewer and/or storm drain located at Shaw St. (S.S.) 75 1st St. W. / Conduit St.  
Assessor's Plot 111, Lot 34, to the sewer and/or storm drain in Shaw St. Street

to be laid in accordance with the conditions in this application and the City of New Bedford ordinances.

TYPE OF USE: ☒ RESIDENTIAL ☐ COMMERCIAL ☐ INDUSTRIAL ☐ OTHER

If applicant other than actual property owner, attach Letter of Authorization from Property Owner

RECEIVED

Name N/A Tel. JAN 25 2002

Mailing Address DEPT. OF PUBLIC WORKS  
NEW BEDFORD, MASS

The Bonded Contractor/Drain Layer authorized to perform this work is:

RT Conessa, Inc. 915 Hawthorne Rd. N.B. MA 02740 (508) 773-9508  
Name Address Tel.

Type of Pipe Required: PVC SDR 35

PERMIT EXPIRES ONE YEAR AFTER DATE OF ISSUE

- \* Requires separate connections for sewage and storm drain where applicable. Storm water cannot be discharged to a sanitary sewer.
- \* All work must be inspected and approved by a D.P.W. inspector before backfilling.
- \* If this connection is to be part of a private service shared jointly with other building owners, attach copy of Recorded Joint Maintenance Agreement.
- \* Permits can be issued to Industrial and/or Commercial Applicants only upon receipt and approval by the Commissioner of Public Works of required plans and supplemental information.
- \* In addition, a City-issued Industrial User Discharge Permit and/or a Sewer Extension/Connection Permit issued by the Commonwealth of Massachusetts D.E.P. shall be required by the City for Industrial Discharge into the sewer system.

Industrial User Discharge Permit No. Date

Comm. Mass. Sewer Conn./Ext. Permit No. Date

A Filing and Inspection Fee of \$ 150.00 plus an Entrance Fee of \$ where applicable, must accompany this application.

Bank # First Citizens Fed. Check # 1070 Date: 12/10/01 Receipt # 4216

Other requirements: Inspection Only - one 6" service line - wye branch to each

side - one common owner. In future, if joint owner - ships, must have joint maintenance Agreement signed, per Electric Anchorage.

Connection made to ☒ Sewer ☐ Storm Drain Part of jointly-shared private line ☐ Yes ☒ No

8" sewer and 20" storm w. 1/4" or 27" storm E. 1/4". See above note

Applicant agrees to abide by the above terms, as well as all pertinent ordinances of the City of New Bedford, and such other special rules as the Commissioner of Public Works may deem necessary

Lawrence D. Webster, Jr.  
Commissioner of Public Works

Signature of Property Owner or Representative

FOR INSPECTION ONLY, A 24 HOUR NOTICE IS REQUIRED AND THE CONTRACTOR/APPLICANT IS REQUIRED TO NOTIFY THE WASTEWATER DIVISION AT 991-6158

INSPECTOR'S REPORT

INSPECTED BY: JOSEPH MARTIN

DATE: 12/19/01


COMMENTS: See above notes re: joint ownership.

☒ APPROVED ☐ DISAPPROVED

Signature of Inspector

SIGNATURE

31-746

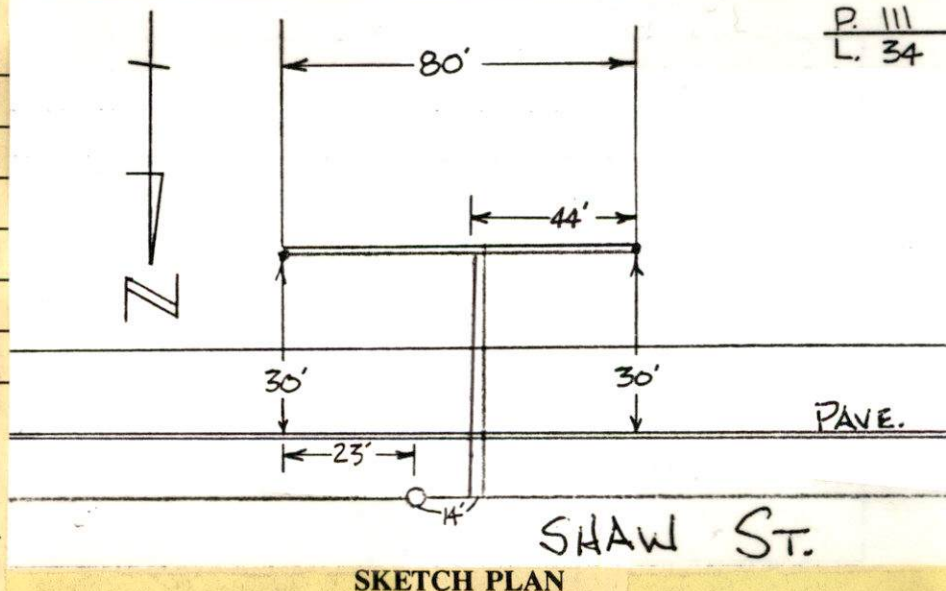

SKETCH PLAN



PERMIT NO.  
**23166**



CITY OF NEW BEDFORD  
SEWER AND/OR STORM DRAIN PERMIT

DATE 12/10/01  
EXP 12/10/02

This certifies that permission is granted to

Property Owner JOSE M. Vaz Address 232 Conduit St. New Bedford MA 02745 Tel. (508) 326-8666 <sup>Cell</sup>

to connect a sewer and/or storm drain located at Show St. (S.S.) 75 (+/-) w. / Conduit St.  
Assessor's Plot 111, Lot 34, to the sewer and/or storm drain in Show St. Street

to be laid in accordance with the conditions in this application and the City of New Bedford ordinances.

TYPE OF USE: ☒ RESIDENTIAL ☐ COMMERICAL ☐ INDUSTRIAL ☐ OTHER

Durabx-3 Polymers  
660 GPD  
Each

If applicant other than actual property owner, attach Letter of Authorization from Property Owner.

Name N/A Tel. \_\_\_\_\_

Mailing Address \_\_\_\_\_

The Bonded Contractor/Drain Layer authorized to perform this work is:

Name RT Conessa Exc. 915 Hathaway Rd. Address NB MA 02740 Tel. (508) 993-9508

Type of Pipe Required: PVC SDR 35

PERMIT EXPIRES ONE YEAR AFTER DATE OF ISSUE

\* Requires separate connections for sewage and storm drain where applicable. Storm water cannot be discharged to a sanitary sewer.

\* All work must be inspected and approved by a D.P.W. inspector before backfilling.

\* If this connection is to be part of a private service shared jointly with other building owners, attach copy of Recorded Joint Maintenance Agreement.

\* Permits can be issued to Industrial and/or Commercial Applicants only upon receipt and approval by the Commissioner of Public Works of required plans and supplemental information.

\* In addition, a City-issued Industrial User Discharge Permit and/or a Sewer Extension/Connection Permit issued by the Commonwealth of Massachusetts D.E.P. shall be required by the City for Industrial Discharge into the sewer system.

Industrial User Discharge Permit No. \_\_\_\_\_ Date \_\_\_\_\_

Comm. Mass. Sewer Conn./Ext. Permit No. \_\_\_\_\_ Date \_\_\_\_\_

A Filing and Inspection Fee of \$ 150.00 plus an Entrance Fee of \$ \_\_\_\_\_ where applicable, must accompany this application.

Bank # First Citizens Fed. Check # 1070 Date: 12/10/01 Receipt # 4216

Other requirements: Inspection Only - one 6" service line - w/pe branch to each

Side - one common owner. In future, if joint owner -  
ships, must have joint maintenance Agreement signed,  
per Duarte Andrade.

Connection made to ☒ Sewer Part of jointly-shared private line ☐ Yes ☒ No

☒ Storm Drain See above note

8" sewer and 20" storm w. 1m/h. or 27" storm E. 1m/h.

Applicant agrees to abide by the above terms, as well as all pertinent ordinances of the City of New Bedford, and such other special rules as the Commissioner of Public Works may deem necessary

Lucinda D. Woodruff  
Commissioner of Public Works

[Signature]  
Signature of Property Owner or Representative

FOR INSPECTION ONLY, A 24 HOUR  
NOTICE IS REQUIRED AND THE  
CONTRACTOR/APPLICANT IS  
REQUIRED TO NOTIFY THE  
WASTEWATER DIVISION AT 991-6158

INSPECTOR'S REPORT

INSPECTED BY: \_\_\_\_\_

DATE: \_\_\_\_\_

COMMENTS: \_\_\_\_\_

\_\_\_\_\_

\_\_\_\_\_

\_\_\_\_\_

\_\_\_\_\_

☐ APPROVED ☐ DISAPPROVED

SIGNATURE

SKETCH PLAN