

PERMIT NO.

23180



CITY OF NEW BEDFORD

SEWER AND/OR STORM DRAIN PERMIT

DATE 11/14/02

EXP 11/14/03

RECEIVED

This certifies that permission is granted to

Frank De Figueiredo, Trs. 2 Schoolhouse Ln. N. Dart. MA 01917
 Property Owner Address #156 Tel. DEPT. OF PUBLIC WORKS
 NEW BEDFORD, MASS.

to connect a sewer and/or storm drain located at Springfield St. (ES.) 220 N. Brockton St.

Assessor's Plot 127B, Lot 501-511, to the sewer and/or storm drain in Springfield Street

to be laid in accordance with the conditions in this application and the City of New Bedford ordinances.

TYPE OF USE: ☐ RESIDENTIAL ☒ COMMERCIAL ☐ INDUSTRIAL ☐ OTHER

If applicant other than actual property owner, attach Letter of Authorization from Property Owner.

Name Robert D. Martin / Ho-bac-line Enterprise Inc. Tel. (508) 998-7817

Mailing Address 627 Tenthin Hill Rd. New Bedford MA 02745

The Bonded Contractor/Drain Layer authorized to perform this work is:

RT. Concess. Excavating 915 Hawthorn Rd. N.B. MA 02710 (508) 993-9508
 Name Address Tel.

Type of Pipe Required: PVC SDR 40 - 6" ; 4 Floor Drains ; MDC trap & Oil & Gas

PERMIT EXPIRES ONE YEAR AFTER DATE OF ISSUE

- * Requires separate connections for sewage and storm drain where applicable. Storm water cannot be discharged to a sanitary sewer.
- * All work must be inspected and approved by a D.P.W. inspector before backfilling.
- * If this connection is to be part of a private service shared jointly with other building owners, attach copy of Recorded Joint Maintenance Agreement.
- * Permits can be issued to Industrial and/or Commercial Applicants only upon receipt and approval by the Commissioner of Public Works of required plans and supplemental information.
- * In addition, a City-issued Industrial User Discharge Permit and/or a Sewer Extension/Connection Permit issued by the Commonwealth of Massachusetts D.E.P. shall be required by the City for Industrial Discharge into the sewer system.

Industrial User Discharge Permit No. Date

Comm. Mass. Sewer Conn./Ext. Permit No. Date

A Filing and Inspection Fee of \$150.00 plus an Entrance Fee of \$ where applicable, must accompany this application.

Bank # Check # Cash Date: 11/14/02 Receipt # 240 (Cash)

Other requirements: Inspection Only - Connecting to 30" Relief Interceptor in Springfield St.

1111 PVC SDR 40 - 6" ; 4 Floor Drains ; MDC trap & Oil & Gas

Separator ; 4" Backwater Valve w/ cleanout cover & pipe to grade - see attached plan.

Connection made to ☒ Sewer Part of jointly-shared private line ☐ Yes ☒ No

☐ Storm Drain (Not Available)

Applicant agrees to abide by the above terms, as well as all pertinent ordinances of the City of New Bedford, and such other special rules as the Commissioner of Public Works may deem necessary

Lawrence D. Warren / Rep. Commissioner of Public Works

Signature of Property Owner or Representative


FOR INSPECTION ONLY, A 24 HOUR NOTICE IS REQUIRED AND THE CONTRACTOR/APPLICANT IS REQUIRED TO NOTIFY THE WASTEWATER DIVISION AT 991-6158

INSPECTOR'S REPORT

INSPECTED BY: JOSEPH MARTIN
 DATE: 4/23/02
 COMMENTS:

☒ APPROVED ☐ DISAPPROVED

Signature of Inspector

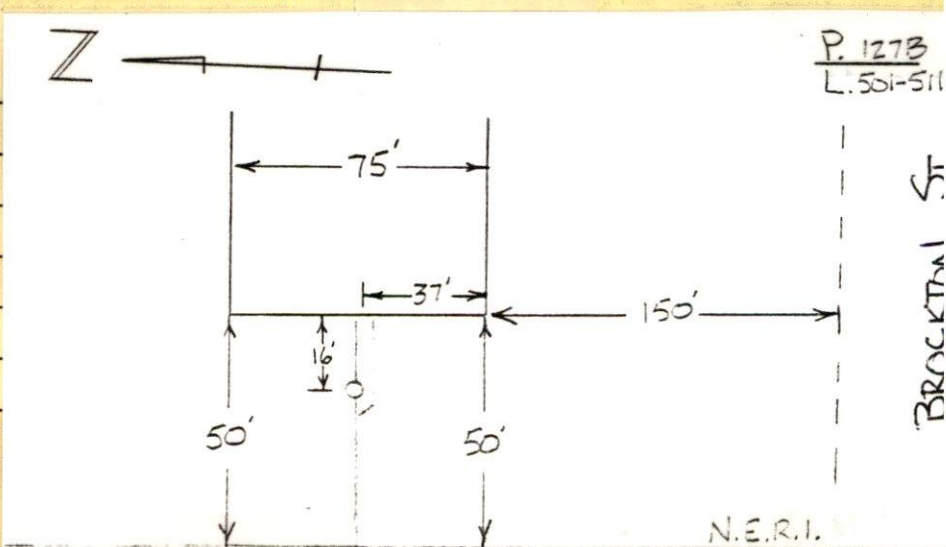

SKETCH PLAN

PERMIT NO.

23180



CITY OF NEW BEDFORD

SEWER AND/OR STORM DRAIN PERMIT

DATE 1/14/02
EXP 1/14/02

This certifies that permission is granted to 2 Schoolhouse Ln. N. Dart. MA 02747
Frank De Figueiredo, TRS. Springfield Realty Trust P.O. Box 51463 NB MA
Property Owner TRS. Address Tel. (508) 998-3901

to connect a sewer and/or storm drain located at Springfield St (ES.) 220 1/4 N. Brookton St.
Assessor's Plot 127B, Lot 501-511, to the sewer and/or storm drain in Springfield Street

to be laid in accordance with the conditions in this application and the City of New Bedford ordinances. Per Bob Martin

TYPE OF USE: ☐ RESIDENTIAL ☒ COMMERCIAL ☐ INDUSTRIAL ☐ OTHER

45 GPD

If applicant other than actual property owner, attach Letter of Authorization from Property Owner.

Name Robert D. Martin / Harborline Enterprise Inc. Tel. (508) 998-7817

Mailing Address 627 Tannin Hill Rd. New Bedford MA 02745

The Bonded Contractor/Drain Layer authorized to perform this work is:

R.T. Conessa Excavating 915 Hadraway Rd. NB MA 02740 (508) 993-9508
Name Filed out app. w/ Vinny Fimback (w/) Address Tel.

Type of Pipe Required: PVC SDR 40 - 6" ; 4 Floor Drains ; MDC Trap - Oil & Gas

PERMIT EXPIRES ONE YEAR AFTER DATE OF ISSUE Separator ; 4" Backwater Valve w/
cleanout cover & rise to grade

* Requires separate connections for sewage and storm drain where applicable. Storm water cannot be discharged to a sanitary sewer.

* All work must be inspected and approved by a D.P.W. inspector before backfilling.

* If this connection is to be part of a private service shared jointly with other building owners, attach copy of Recorded Joint Maintenance Agreement.

* Permits can be issued to Industrial and/or Commercial Applicants only upon receipt and approval by the Commissioner of Public Works of required plans and supplemental information.

* In addition, a City-issued Industrial User Discharge Permit and/or a Sewer Extension/Connection Permit issued by the Commonwealth of Massachusetts D.E.P. shall be required by the City for Industrial Discharge into the sewer system.

Industrial User Discharge Permit No. _____ Date _____

Comm. Mass. Sewer Conn./Ext. Permit No. _____ Date _____

A Filing and Inspection Fee of \$ 150.00 plus an Entrance Fee of \$ _____ where applicable, must accompany this application.

Bank # _____ Check # Cash Date: 1/14/02 Receipt # 240 (Cash)

Other requirements: Inspection Only - Connecting to 30" Relief Interceptor in Springfield St.

Use PVC SDR 40 - 6" ; 4 Floor Drains ; MDC trap - Oil & Gas

Separator ; 4" Backwater Valve w/ cleanout cover & rise to grade - see attached plan.

Connection made to ☒ Sewer ☐ Storm Drain (Not Available)

Part of jointly-shared private line ☐ Yes ☒ No

FOR INSPECTION ONLY, A 24 HOUR NOTICE IS REQUIRED AND THE CONTRACTOR/APPLICANT IS REQUIRED TO NOTIFY THE WASTEWATER DIVISION AT 991-6158

Reviewed & OK'd by Dante Andrade and Vinny Fimback

Applicant agrees to abide by the above terms, as well as all pertinent ordinances of the City of New Bedford, and such other special rules as the Commissioner of Public Works may deem necessary

Lawrence D. Moran / etc.
Commissioner of Public Works

Robert D. Martin
Signature of Property Owner or Representative

INSPECTOR'S REPORT

INSPECTED BY: _____

DATE: _____

COMMENTS: _____

☐ APPROVED

☐ DISAPPROVED

SIGNATURE

SKETCH PLAN



CITY OF NEW BEDFORD
MASSACHUSETTS

DEPT. OF PUBLIC WORKS

133 WILLIAM STREET

LAWRENCE D. WORDEN
COMMISSIONER

To Whom It May Concern:

I, FRANK DE FIGUEROA D/B/A SPRINGFIELD REALTY TRUST PO BOX 51463 NB MA, being
(Name) Print Mailing Address

owner of property located at _____

Plot 127 B, Lots 501-511, hereby agree to allow ROBERT D MARTIN
Name
HARBORLINE ENTERPRISES INC

627 TARKILN HILL ROAD MA to act on my behalf, including affixing my signature,
Mailing Address
in securing permits for:

<input checked="" type="checkbox"/>	Sewer/Drain Service Permits
<input checked="" type="checkbox"/>	Water Service Permits
<input type="checkbox"/>	Driveway Installation Permits
<input checked="" type="checkbox"/>	Sidewalk Installation Permits

I further agree to conform to, and abide by, all City rules and ask regulations applicable to the permit (s) being applied for.

Name Frank de Figueroa
(signature)

PO BOX 51463 NEW BEDFORD MA
(Address)

12-18-01 508 9983901
(Date) (Telephone Number)