

PERMIT NO.
23188



CITY OF NEW BEDFORD
SEWER AND/OR STORM DRAIN PERMIT

DATE 2/21/02
EXP. 2/21/03

This certifies that permission is granted to
Crimson Realty Trust / Isabel N. Perry, Trs. 1112 Tudor Rd., N. Dartmouth, MA 02747
Property Owner Address #58 Tel. (508) 993-4552
to connect a sewer and/or storm drain located at White Lock St. (S.S.) 553 (41) W. Mt. Pleasant St.
Assessor's Plot 123B, Lot 51, to the sewer and/or storm drain in White Lock St. (Easement on Lot 51) Street
to be laid in accordance with the conditions in this application and the City of New Bedford ordinances.

TYPE OF USE: ☒ RESIDENTIAL ☐ COMMERCIAL ☐ INDUSTRIAL ☐ OTHER

If applicant other than actual property owner, attach Letter of Authorization from Property Owner.

Name Curt M. Perry Tel. (508) 993-4552
Mailing Address 1143 Tudor Rd., N. Dartmouth, MA 02747

The Bonded Contractor/Drain Layer authorized to perform this work is:

Cordoso Paving & Construction Co., 12 White St., Acushnet, MA 02743
Name Address Tel. (508) 998-5115

Type of Pipe Required: PVC SDR 35

PERMIT EXPIRES ONE YEAR AFTER DATE OF ISSUE

MAY 29 2002

DEPT. OF PUBLIC WORKS
NEW BEDFORD, MASS.

- * Requires separate connections for sewage and storm drain where applicable. Storm water cannot be discharged to a sanitary sewer.
- * All work must be inspected and approved by a D.P.W. inspector before backfilling.
- * If this connection is to be part of a private service shared jointly with other building owners, attach copy of Recorded Joint Maintenance Agreement.
- * Permits can be issued to Industrial and/or Commercial Applicants only upon receipt and approval by the Commissioner of Public Works of required plans and supplemental information.
- * In addition, a City-issued Industrial User Discharge Permit and/or a Sewer Extension/Connection Permit issued by the Commonwealth of Massachusetts D.E.P. shall be required by the City for Industrial Discharge into the sewer system.

Industrial User Discharge Permit No. _____ Date _____

Comm. Mass. Sewer Conn./Ext. Permit No. _____ Date _____

A Filing and Inspection Fee of \$ 150.00 plus an Entrance Fee of \$ _____ where applicable, must accompany this application.

Bank # Compass Check # 1657 Date: 2/21/02 Receipt # 4242

Other requirements: Inspector Only - Tying into 8" sewer pipe in the 20' wide
sewer easement that runs parallel to the westerly
line of Lot 51

Connection made to ☒ Sewer ☐ Storm Drain
Part of jointly-shared private line ☐ Yes ☒ No

FOR INSPECTION ONLY, A 24 HOUR
NOTICE IS REQUIRED AND THE
CONTRACTOR/APPLICANT IS
REQUIRED TO NOTIFY THE
WASTEWATER DIVISION AT 991-6158

Applicant agrees to abide by the above terms, as well as all pertinent ordinances of the City of New Bedford, and such other special rules as the Commissioner of Public Works may deem necessary

Lawrence D. Whiteaker, Jr.
Commissioner of Public Works

[Signature]
Signature of Property Owner or Representative

INSPECTOR'S REPORT


INSPECTED BY: PETE SCIESZKA

DATE: 3/21/02

COMMENTS:

☒ APPROVED ☐ DISAPPROVED

[Signature]
SIGNATURE

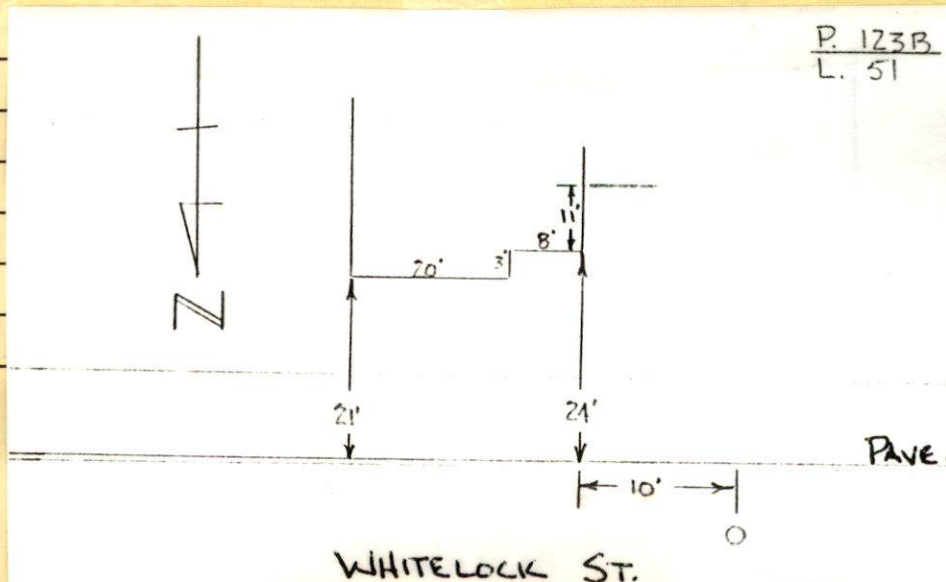

PERMIT NO.

23188



CITY OF NEW BEDFORD

SEWER AND/OR STORM DRAIN PERMIT

DATE 2/21/02
EXP. 2/21/03

This certifies that permission is granted to

Crimson Realty Trust / Isabel N. Perry, Trs. 1143 Tucker Rd., N. Dartmouth MA 02747
Property Owner Address Tel. (508) 993-4552

to connect a sewer and/or storm drain located at Whitelock St. (S.S.) 553 (41) W. Mt. Pleasant St.
Assessor's Plot 123B, Lot 51, to the sewer and/or storm drain in Whitelock St. (Eastman on Lot 51) Street
to be laid in accordance with the conditions in this application and the City of New Bedford ordinances.

TYPE OF USE: ☒ RESIDENTIAL ☐ COMMERCIAL ☐ INDUSTRIAL ☐ OTHER

If applicant other than actual property owner, attach Letter of Authorization from Property Owner.

Name Curt M. Perry Tel. (508) 993-4552

Mailing Address 1143 Tucker Rd., N. Dartmouth MA 02747

The Bonded Contractor/Drain Layer authorized to perform this work is:

Cordoso Paving & Construction Co., 12 White St., Acushnet MA 02743
Name Address Tel. (508) 998-5115

Type of Pipe Required: PVC SDR 35

PERMIT EXPIRES ONE YEAR AFTER DATE OF ISSUE

* Requires separate connections for sewage and storm drain where applicable. Storm water cannot be discharged to a sanitary sewer.

* All work must be inspected and approved by a D.P.W. inspector before backfilling.

* If this connection is to be part of a private service shared jointly with other building owners, attach copy of Recorded Joint Maintenance Agreement.

* Permits can be issued to Industrial and/or Commercial Applicants only upon receipt and approval by the Commissioner of Public Works of required plans and supplemental information.

* In addition, a City-issued Industrial User Discharge Permit and/or a Sewer Extension/Connection Permit issued by the Commonwealth of Massachusetts D.E.P. shall be required by the City for Industrial Discharge into the sewer system.

Industrial User Discharge Permit No. _____ Date _____

Comm. Mass. Sewer Conn./Ext. Permit No. _____ Date _____

A Filing and Inspection Fee of \$ 150.00 plus an Entrance Fee of \$ _____ where applicable, must accompany this application.

Bank # Compass Check # 1657 Date: 2/21/02 Receipt # 4242

Other requirements: Inspector Only - Tying into 8" sewer pipe in the 20' wide sewer easement that runs parallel to the westerly line of Lot 51

Connection made to ☒ Sewer ☐ Storm Drain
Part of jointly-shared private line ☐ Yes ☒ No

FOR INSPECTION ONLY, A 24 HOUR NOTICE IS REQUIRED AND THE CONTRACTOR/APPLICANT IS REQUIRED TO NOTIFY THE WASTEWATER DIVISION AT 991-6158

Applicant agrees to abide by the above terms, as well as all pertinent ordinances of the City of New Bedford, and such other special rules as the Commissioner of Public Works may deem necessary

Lawrence D. Worderlan
Commissioner of Public Works

[Signature]
Signature of Property Owner or Representative

INSPECTOR'S REPORT

INSPECTED BY: _____

DATE: _____

COMMENTS: _____

☐ APPROVED ☐ DISAPPROVED

SIGNATURE

SKETCH PLAN



**CITY OF NEW BEDFORD
MASSACHUSETTS**

DEPARTMENT OF PUBLIC WORKS
ENGINEERING DIVISION
133 WILLIAM STREET, ROOM 303
NEW BEDFORD, MA 02740
Tel: (508) 979-1527
Fax: (508) 961-3043

To Whom It May Concern:

I, Sabel N. Perry 1143 Tucker Rd. NP, being
(Name) (Mailing Address)

Owner of property located at Whitelock St. New Bedford

Plot 123B, Lot 51, hereby agree to allow Curt Perry
(Name)

1143 Tucker Rd. NP to act on my behalf including affixing my
(Mailing Address)

signature in securing permit for:

- ☒ Sewer/Drain Service Permits
- ☒ Water Service Permits
- ☒ Driveway Installation Permits
- ☒ Sidewalk Installation Permits

I further agree to conform to, and abide by, all City rules and ask regulations applicable to the permit (s) being applied for:

Name [Signature]
(Signature)

(Address)

(Date)

(Telephone number)

[illegible]

GARCIA

(PRIVATE)

[illegible]

WHITELOCK

[illegible]