

PERMIT NO:

23189



CITY OF NEW BEDFORD

DATE 2-27-02

SEWER AND/OR STORM DRAIN PERMIT

This certifies that permission is granted to

Richard Bailey, Walton Land Co. LLC 568 LANTERN LN. W.B. MA. 02740 (508) 990-8726  
 Property Owner Address Tel.

to connect a sewer and/or storm drain located at (ES) John St 570 S/ALLEN ST  
 Assessor's Plot 33, Lot 81, to the sewer and/or storm drain in John St  
 to be laid in accordance with the conditions in this application and the City of New Bedford ordinances.

TYPE OF USE: ☒ RESIDENTIAL ☐ COMMERICAL ☐ INDUSTRIAL ☐ OTHER

If applicant other than actual property owner, attach Letter of Authorization from Property Owner.

Name..... Tel.....

Mailing Address.....

The Bonded Contractor/Drain Layer authorized to perform this work is:

Reis Asphalt 476 Hixville Rd (508) 996 0735  
 Name Address Tel.

Type of Pipe Required: SDR 35 (PVC)

PERMIT EXPIRES ONE YEAR AFTER DATE OF ISSUE

- \* Requires separate connections for sewage and storm drain where applicable. Storm water cannot be discharged to a sanitary sewer.
- \* All work must be inspected and approved by a D.P.W. inspector before backfilling.
- \* If this connection is to be part of a private service shared jointly with other building owners, attach copy of Recorded Joint Maintenance Agreement.
- \* Permits can be issued to Industrial and/or Commercial Applicants only upon receipt and approval by the Commissioner of Public Works of required plans and supplemental information.
- \* In addition, a City-issued Industrial User Discharge Permit and/or a Sewer Extension/Connection Permit issued by the Commonwealth of Massachusetts D.E.P. shall be required by the City for Industrial Discharge into the sewer system.

Industrial User Discharge Permit No. N/A Date.....

Comm. Mass. Sewer Conn./Ext. Permit No. N/A Date.....

A Filing and Inspection Fee of \$150.00, plus an Entrance Fee of \$..... where applicable, must accompany this application.

Bank # Peoples Savings Bank Check # 793 Date: 2-27-02 Receipt # 4248

Other requirements: inspection only

☒ Sewer

Connection made to Part of jointly-shared private line ☐ Yes ☒ No

☐ Storm Drain

Applicant agrees to abide by the above terms, as well as all pertinent ordinances of the City of New Bedford, and such other special rules as the Commissioner of Public Works may deem necessary

Lawrence D. McDevitt  
 Commissioner of Public Works

x Richard F. Bailey  
 Signature of Property Owner or Representative

INSPECTOR'S REPORT

INSPECTED BY: JOSEPH MARTIN


DATE: 6/6/02

COMMENTS:

☒ APPROVED

☐ DISAPPROVED

Joseph Martin  
 SIGNATURE

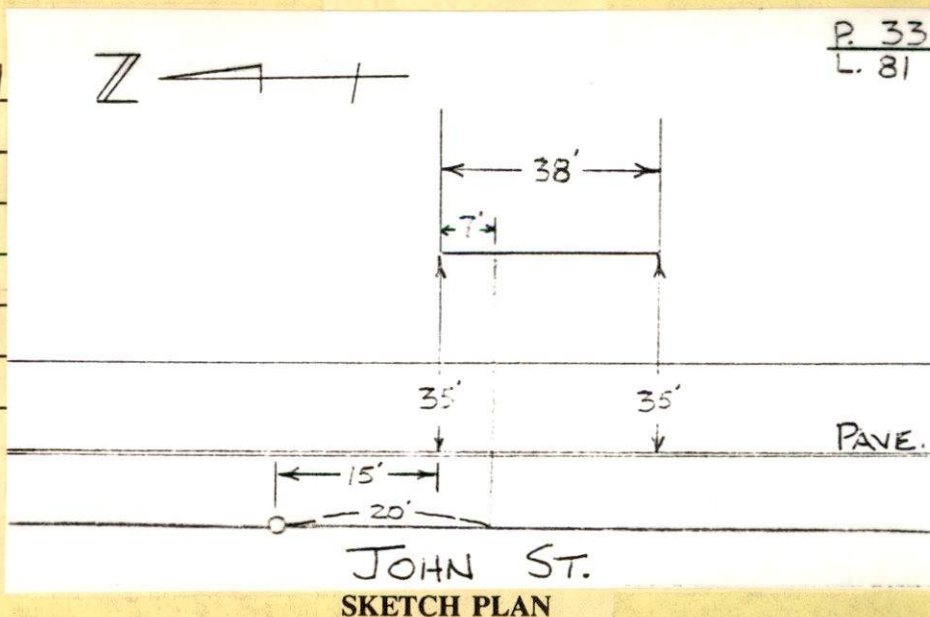

P. 33  
 L. 81



PERMIT NO:

23189



CITY OF NEW BEDFORD

DATE 2-27-02

SEWER AND/OR STORM DRAIN PERMIT

This certifies that permission is granted to  
Richard Bailey, Walpole Land Co. LLC 568 LANTERN LN. N.B. MA. 02740 (508) 990-8726  
Property Owner Address Tel.

to connect a sewer and/or storm drain located at (ES) John St 570 S ALLEN ST  
Assessor's Plot 33, Lot 81, to the sewer and/or storm drain in John St Street

to be laid in accordance with the conditions in this application and the City of New Bedford ordinances.

TYPE OF USE: ☒ RESIDENTIAL ☐ COMMERICAL ☐ INDUSTRIAL ☐ OTHER 330 6PD

If applicant other than actual property owner, attach Letter of Authorization from Property Owner.

Name Tel.

Mailing Address

The Bonded Contractor/Drain Layer authorized to perform this work is:

Reis Asphalt 476 Hixville Rd (508) 996 0735  
Name Address Tel.

Type of Pipe Required: SDR 35 (PVC)

PERMIT EXPIRES ONE YEAR AFTER DATE OF ISSUE

- \* Requires separate connections for sewage and storm drain where applicable. Storm water cannot be discharged to a sanitary sewer.
- \* All work must be inspected and approved by a D.P.W. inspector before backfilling.
- \* If this connection is to be part of a private service shared jointly with other building owners, attach copy of Recorded Joint Maintenance Agreement.
- \* Permits can be issued to Industrial and/or Commercial Applicants only upon receipt and approval by the Commissioner of Public Works of required plans and supplemental information.
- \* In addition, a City-issued Industrial User Discharge Permit and/or a Sewer Extension/Connection Permit issued by the Commonwealth of Massachusetts D.E.P. shall be required by the City for Industrial Discharge into the sewer system.

Industrial User Discharge Permit No. N/A Date  
Comm. Mass. Sewer Conn./Ext. Permit No. N/A Date

A Filing and Inspection Fee of \$150.00, plus an Entrance Fee of \$ where applicable, must accompany this application.

Bank # Peoples Savings Bank Check # 793 Date: 2-27-02 Receipt # 4248

Other requirements: inspection only

Connection made to ☒ Sewer ☐ Storm Drain  
Part of jointly-shared private line ☐ Yes ☒ No

FOR INSPECTION ONLY, A 24 HOUR NOTICE IS REQUIRED AND THE CONTRACTOR/APPLICANT IS REQUIRED TO NOTIFY THE WASTEWATER DIVISION AT 991-6158

Applicant agrees to abide by the above terms, as well as all pertinent ordinances of the City of New Bedford, and such other special rules as the Commissioner of Public Works may deem necessary

Lawrence D. Worden 1st Comm. Commissioner of Public Works  
Signature of Property Owner or Representative

INSPECTOR'S REPORT

INSPECTED BY: \_\_\_\_\_  
DATE: \_\_\_\_\_  
COMMENTS: \_\_\_\_\_  
\_\_\_\_\_  
\_\_\_\_\_  
\_\_\_\_\_  
☐ APPROVED ☐ DISAPPROVED

SIGNATURE

SKETCH PLAN