

PERMIT NO.



CITY OF NEW BEDFORD

DATE 3/13/02

23191

NARY

SEWER AND/OR STORM DRAIN PERMIT

This certifies that permission is granted to

NARONICS

SBB REALTY, LLC

5 DOVER ST. N.B. MA. 02740

(508) 984-4100

(Cynthia Spence) Property Owner

Address #259

Tel.

to connect a sewer and/or storm drain located at SAMUEL BARNET BLVD.

DARTMOUTH 84, Lot 8, to the sewer and/or storm drain in SAMUEL BARNET BLVD. Street

to be laid in accordance with the conditions in this application and the City of New Bedford ordinances.

TYPE OF USE: ☐ RESIDENTIAL ☐ COMMERICAL ☐ INDUSTRIAL ☒ OTHER

LITE INDUSTRIAL-  
POSSIBLE 7 UNITS TO BE  
REVIEWED INDIVIDUALLY  
PER VINNIE FORTAD  
3/12/02

If applicant other than actual property owner, attach Letter of Authorization from Property Owner.

Name N/A

Tel. 3/12/02

Mailing Address

The Bonded Contractor/Drain Layer authorized to perform this work is:

G. LOPES CONST.

TAUNTON

MA

(508) 824 4834

Name

Address

Tel.

Type of Pipe Required: PVC SDR 35

PERMIT EXPIRES ONE YEAR AFTER DATE OF ISSUE

- \* Requires separate connections for sewage and storm drain where applicable. Storm water cannot be discharged to a sanitary sewer.
- \* All work must be inspected and approved by a D.P.W. inspector before backfilling.
- \* If this connection is to be part of a private service shared jointly with other building owners, attach copy of Recorded Joint Maintenance Agreement.
- \* Permits can be issued to Industrial and/or Commercial Applicants only upon receipt and approval by the Commissioner of Public Works of required plans and supplemental information.
- \* In addition, a City-issued Industrial User Discharge Permit and/or a Sewer Extension/Connection Permit issued by the Commonwealth of Massachusetts D.E.P. shall be required by the City for Industrial Discharge into the sewer system.

Industrial User Discharge Permit No. N/A Date

Comm. Mass. Sewer Conn./Ext. Permit No. N/A Date

A Filing and Inspection Fee of \$150.00, plus an Entrance Fee of \$ where applicable, must accompany this application.

Bank # COMPASS BANK Check # 1012 Date: 3/13/02 Receipt #

Other requirements: Inspection Only - Tying into existing 8" sewer stub in the Town of Dartmouth.

☒ Sewer

Connection made to

Part of jointly-shared private line ☐ Yes ☒ No

☐ Storm Drain

Applicant agrees to abide by the above terms, as well as all pertinent ordinances of the City of New Bedford, and such other special rules as the Commissioner of Public Works may deem necessary

Lawrence D. Worden

MHS

Commissioner of Public Works

Cynthia F. Spence

Signature of Property Owner or Representative


INSPECTED BY:

DATE:

COMMENTS:

☐ APPROVED

☐ DISAPPROVED

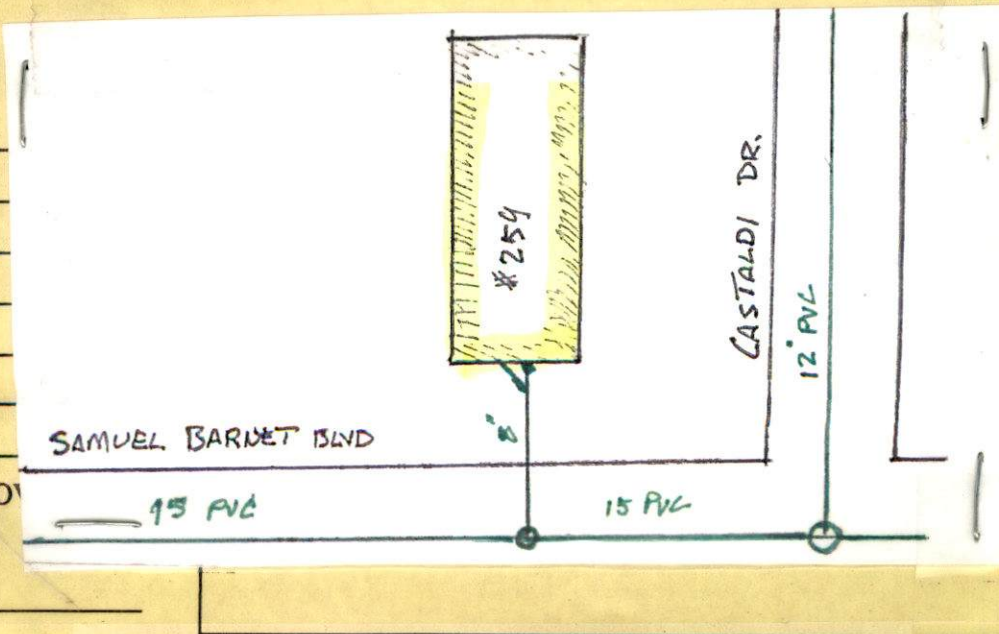

SIGNATURE

SKETCH PLAN



PERMIT NO.

23191



CITY OF NEW BEDFORD

DATE 3/13/02

SEWER AND/OR STORM DRAIN PERMIT

This certifies that permission is granted to

NAYONICS

SBB REALTY, LLC

5 DOVER ST. N.B. MA. 02740

(508) 984-4100

(Cynthia Spence) Property Owner

Address

Tel.

to connect a sewer and/or storm drain located at SAMUEL BARNET BLVD.

DARTMOUTH Assessor's Plot 84, Lot 8-11, to the sewer and/or storm drain in SAMUEL BARNET BLVD. Street

to be laid in accordance with the conditions in this application and the City of New Bedford ordinances.

TYPE OF USE: ☐ RESIDENTIAL ☐ COMMERCIAL ☐ INDUSTRIAL ☒ OTHER LITE INDUSTRIAL - POSSIBLE 7 UNITS TO BE REVIEWED INDIVIDUALLY

If applicant other than actual property owner, attach Letter of Authorization from Property Owner. PER VINNIE FORTAD 3/12/02

Name N/A Tel.

Mailing Address.

The ~~Bonded~~ Contractor/Drain Layer authorized to perform this work is:

G. LOPES CONST. TAUNTON MA (508) 824 4834

Name

Address

Tel.

Type of Pipe Required: PVC SDR 35

PERMIT EXPIRES ONE YEAR AFTER DATE OF ISSUE

\* Requires separate connections for sewage and storm drain where applicable. Storm water cannot be discharged to a sanitary sewer.

\* All work must be inspected and approved by a D.P.W. inspector before backfilling.

\* If this connection is to be part of a private service shared jointly with other building owners, attach copy of Recorded Joint Maintenance Agreement.

\* Permits can be issued to Industrial and/or Commercial Applicants only upon receipt and approval by the Commissioner of Public Works of required plans and supplemental information.

\* In addition, a City-issued Industrial User Discharge Permit and/or a Sewer Extension/Connection Permit issued by the Commonwealth of Massachusetts D.E.P. shall be required by the City for Industrial Discharge into the sewer system.

Industrial User Discharge Permit No. N/A Date.

Comm. Mass. Sewer Conn./Ext. Permit No. N/A Date.

A Filing and Inspection Fee of \$150.00, plus an Entrance Fee of \$ where applicable, must accompany this application.

Bank # COMPASS BANK Check # 1012 Date: 3/13/02 Receipt #

Other requirements: Inspection Only - Tying into existing 8" sewer stub in the Town of Dartmouth

☒ Sewer

Connection made to

☐ Storm Drain

Part of jointly-shared private line ☐ Yes ☒ No

FOR INSPECTION ONLY, A 24 HOUR NOTICE IS REQUIRED AND THE CONTRACTOR/APPLICANT IS REQUIRED TO NOTIFY THE WASTEWATER DIVISION AT 991-6158

Applicant agrees to abide by the above terms, as well as all pertinent ordinances of the City of New Bedford, and such other special rules as the Commissioner of Public Works may deem necessary

Lawrence S. Worden MHS  
Commissioner of Public Works

Cynthia F. Spence  
Signature of Property Owner or Representative

INSPECTOR'S REPORT

INSPECTED BY: \_\_\_\_\_

DATE: \_\_\_\_\_

COMMENTS: \_\_\_\_\_

\_\_\_\_\_

\_\_\_\_\_

\_\_\_\_\_

☐ APPROVED

☐ DISAPPROVED

SIGNATURE

SKETCH PLAN