

PERMIT NO.  
23198



CITY OF NEW BEDFORD  
SEWER AND/OR STORM DRAIN PERMIT

DATE 4/9/02  
EXP 4/9/03  
**RECEIVED**

This certifies that permission is granted to

Joseph E. Lemieux, Trs. River Rd. Realty Trust 25 Hathorn St. Acushnet MA 02713  
Property Owner Address

to connect a sewer and/or storm drain located at River Rd. (U.S.) 150' (+/-) S. of Truro St.  
Assessor's Plot 116, Lot 380, to the sewer and/or storm drain in River Rd. Street

to be laid in accordance with the conditions in this application and the City of New Bedford ordinances.  
TYPE OF USE: ☒ RESIDENTIAL ☐ COMMERCIAL ☐ INDUSTRIAL ☐ OTHER 330 GPD

If applicant other than actual property owner, attach Letter of Authorization from Property Owner.  
Name Joseph E. Lemieux Tel. (508) 985-0775  
Mailing Address 179 River Rd. New Bedford MA 02713

The Bonded Contractor/Drain Layer authorized to perform this work is:  
N. Cardoso, Perry & Construction 12 White St. Acushnet MA 02713  
Name Address Tel. (508) 998-5115

Type of Pipe Required: PVC SDR 35  
PERMIT EXPIRES ONE YEAR AFTER DATE OF ISSUE

- \* Requires separate connections for sewage and storm drain where applicable. Storm water cannot be discharged to a sanitary sewer.
- \* All work must be inspected and approved by a D.P.W. inspector before backfilling.
- \* If this connection is to be part of a private service shared jointly with other building owners, attach copy of Recorded Joint Maintenance Agreement.
- \* Permits can be issued to Industrial and/or Commercial Applicants only upon receipt and approval by the Commissioner of Public Works of required plans and supplemental information.
- \* In addition, a City-issued Industrial User Discharge Permit and/or a Sewer Extension/Connection Permit issued by the Commonwealth of Massachusetts D.E.P. shall be required by the City for Industrial Discharge into the sewer system.

Industrial User Discharge Permit No. 64-Permit Date 4/9/02  
Comm. Mass. Sewer Conn./Ext. Permit No. 64-Permit Date 4/9/02

A Filing and Inspection Fee of \$ 100.00, plus an Entrance Fee of \$ — where applicable, must accompany this application.

Bank # Citizens Bank Check # 881 Date: 4/9/02 Receipt # 4272

Other requirements: Final fee only - Connecting to 18" sewer main and 10" storm drain pipe in River Rd.

Connection made to ☒ Sewer ☐ Storm Drain  
Part of jointly-shared private line ☐ Yes ☒ No

FOR INSPECTION ONLY, A 24 HOUR NOTICE IS REQUIRED AND THE CONTRACTOR/APPLICANT IS REQUIRED TO NOTIFY THE WASTEWATER DIVISION AT 991-6130

Applicant agrees to abide by the above terms, as well as all pertinent ordinances of the City of New Bedford, and such other special rules as the Commissioner of Public Works may deem necessary


Laurence D. Whitcomb Commissioner of Public Works  
Joseph E. Lemieux Signature of Property Owner or Representative

INSPECTOR'S REPORT

INSPECTED BY: JOSEPH MARTIN  
DATE: 8/7/02  
COMMENTS:

☒ APPROVED ☐ DISAPPROVED

Joseph Martin  
SIGNATURE

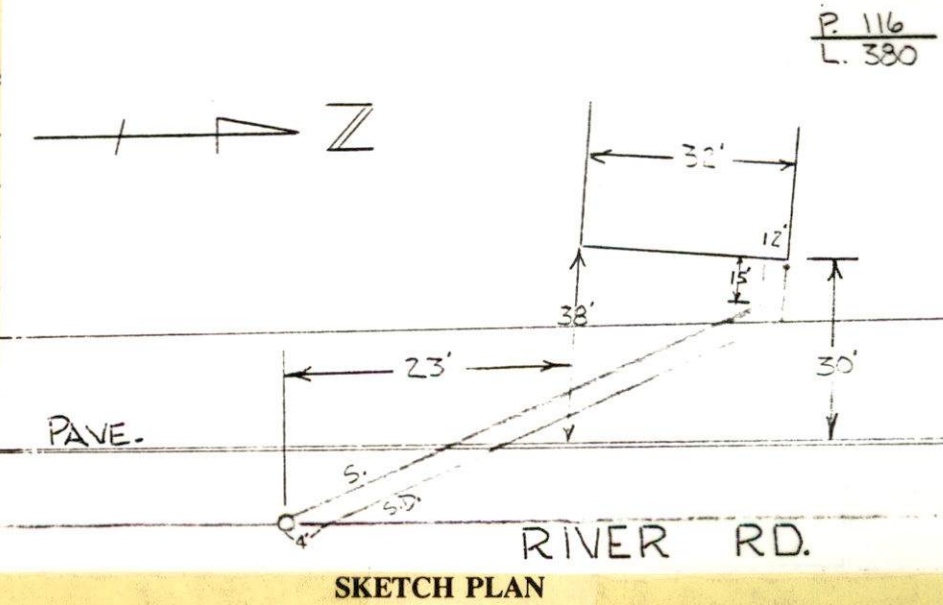



PERMIT NO.  
**23198**



CITY OF NEW BEDFORD  
SEWER AND/OR STORM DRAIN PERMIT

DATE 4/9/02  
EXP 4/9/03

This certifies that permission is granted to

Joseph E. Lemieux, Trs. River Rd. Realty Trust 25 Hathaway Rd. Acushnet MA 0271  
Property Owner Address Tel. (508) 993-5521

to connect a sewer and/or storm drain located at River Rd. (W.S.) 150 (+/-) S. / Truro St.

Assessor's Plot 116, Lot 380, to the sewer and/or storm drain in River Rd. Street

to be laid in accordance with the conditions in this application and the City of New Bedford ordinances.

TYPE OF USE: ☒ RESIDENTIAL ☐ COMMERICAL ☐ INDUSTRIAL ☐ OTHER

330 GPD

If applicant other than actual property owner, attach Letter of Authorization from Property Owner.

Name Scott E. Lemieux Tel. (508) 985-0995

Mailing Address 179 River Rd. New Bedford MA 02743 Tel. (508) 328-4955

The Bonded Contractor/Drain Layer authorized to perform this work is:

N. Cardoso Paving & Construction 12 White St. Acushnet MA 02743  
Name Address Tel. (508) 998-5115

Type of Pipe Required: PVC SDR 35

PERMIT EXPIRES ONE YEAR AFTER DATE OF ISSUE

\* Requires separate connections for sewage and storm drain where applicable. Storm water cannot be discharged to a sanitary sewer.

\* All work must be inspected and approved by a D.P.W. inspector before backfilling.

\* If this connection is to be part of a private service shared jointly with other building owners, attach copy of Recorded Joint Maintenance Agreement.

\* Permits can be issued to Industrial and/or Commercial Applicants only upon receipt and approval by the Commissioner of Public Works of required plans and supplemental information.

\* In addition, a City-issued Industrial User Discharge Permit and/or a Sewer Extension/Connection Permit issued by the Commonwealth of Massachusetts D.E.P. shall be required by the City for Industrial Discharge into the sewer system.

Industrial User Discharge Permit No. - Date -

Comm. Mass. Sewer Conn./Ext. Permit No. - Date -

A Filing and Inspection Fee of \$ 150.00, plus an Entrance Fee of \$ - where applicable, must accompany this application.

Bank # Citizens Bank Check # 442 881 Date: 4/9/02 Receipt # 4272

Other requirements: Inspection Only - Connecting to 18" sewer main  
and 10" storm drain pipe in River Rd.

☒ Sewer

Connection made to

☐ Storm Drain

Part of jointly-shared private line ☐ Yes ☒ No

FOR INSPECTION ONLY, A 24 HOUR  
NOTICE IS REQUIRED AND THE  
CONTRACTOR/APPLICANT IS  
REQUIRED TO NOTIFY THE  
WASTEWATER DIVISION AT 991-6158

Applicant agrees to abide by the above terms, as well as all pertinent ordinances of the City of New Bedford, and such other special rules as the Commissioner of Public Works may deem necessary

Lawrence D. Weldon/ass  
Commissioner of Public Works

Scott E. Lemieux  
Signature of Property Owner or Representative

INSPECTOR'S REPORT

INSPECTED BY: \_\_\_\_\_

DATE: \_\_\_\_\_

COMMENTS: \_\_\_\_\_  
\_\_\_\_\_  
\_\_\_\_\_  
\_\_\_\_\_

☐ APPROVED

☐ DISAPPROVED

SIGNATURE

SKETCH PLAN





**CITY OF NEW BEDFORD  
MASSACHUSETTS**

DEPARTMENT OF PUBLIC WORKS  
ENGINEERING DIVISION  
133 WILLIAM STREET, ROOM 303  
NEW BEDFORD, MA 02740  
Tel: (508) 979-1527  
Fax: (508) 961-3043

To Whom It May Concern:

I, Joseph E Lemieux 25 Hathaway Rd Acushnet 02743, being  
(Name) (Mailing Address)

Owner of property located at River Road

Plot 116, Lot 380, hereby agree to allow Scott Lemieux  
(Name)

179 River Road New Bedford 02745 to act on my behalf including affixing my  
(Mailing Address)

signature in securing permit for:

X Sewer/Drain Service Permits  
       Water Service Permits  
X Driveway Installation Permits  
       Sidewalk Installation Permits

I further agree to conform to, and abide by, all City rules and ask regulations applicable to the permit (s) being applied for:

Name Joseph E Lemieux  
(Signature)

→ See Above  
(Address)

→ 4/9/02 (508) 99 55521  
(Date) (Telephone number)