

PERMIT NO.
23199



CITY OF NEW BEDFORD
SEWER AND/OR STORM DRAIN PERMIT

DATE: 7/9/02
EXPIRATION: 7/9/03

This certifies that permission is granted to
Thomas A. DeCosta P.O. Box 70189, N. Dartmouth, MA 02747 (508) 942-2417
Property Owner Address #1622 CVAS measure & Tel
to connect a sewer and/or storm drain located at Padanaram Ave. (S.S.) at Intersect w/ Norwalk St.
Assessor's Plot 17A, Lot 108, to the sewer and/or storm drain in Padanaram Ave. Street
to be laid in accordance with the conditions in this application and the City of New Bedford ordinances.
TYPE OF USE: ☒ RESIDENTIAL ☐ COMMERICAL ☐ INDUSTRIAL ☐ OTHER 330 GRD
If applicant other than actual property owner, attach Letter of Authorization from Property Owner.
Name N/A Tel.
Mailing Address
The Bonded Contractor/Drain Layer authorized to perform this work is: Franklin Bros. (will call us) **RECEIVED OCT 21 2002**
Name Address **DEPT. OF PUBLIC WORKS NEW BEDFORD, MASS.**
Type of Pipe Required: PVC SDR 35
PERMIT EXPIRES ONE YEAR AFTER DATE OF ISSUE

- * Requires separate connections for sewage and storm drain where applicable. Storm water cannot be discharged to a sanitary sewer.
- * All work must be inspected and approved by a D.P.W. inspector before backfilling.
- * If this connection is to be part of a private service shared jointly with other building owners, attach copy of Recorded Joint Maintenance Agreement.
- * Permits can be issued to Industrial and/or Commercial Applicants only upon receipt and approval by the Commissioner of Public Works of required plans and supplemental information.
- * In addition, a City-issued Industrial User Discharge Permit and/or a Sewer Extension/Connection Permit issued by the Commonwealth of Massachusetts D.E.P. shall be required by the City for Industrial Discharge into the sewer system.

Industrial User Discharge Permit No. Date
Comm. Mass. Sewer Conn./Ext. Permit No. Date
A Filing and Inspection Fee of \$ 150.00 plus an Entrance Fee of \$ where applicable, must accompany this application.
Bank # ROCKLAND FEDERAL Check # 0115 Date: 7/09/02 Receipt # 4273
Other requirements: Inspection Only - Connecting to 12" sewer main and 10" storm drain in padanaram Ave.

Connection made to ☒ Sewer ☐ Storm Drain
Part of jointly-shared private line ☐ Yes ☒ No

FOR INSPECTION ONLY, A 24 HOUR NOTICE IS REQUIRED AND THE CONTRACTOR/APPLICANT IS REQUIRED TO NOTIFY THE WASTEWATER DIVISION AT 991-6158


Applicant agrees to abide by the above terms, as well as all pertinent ordinances of the City of New Bedford, and such other special rules as the Commissioner of Public Works may deem necessary

Lawrence D. Warden Commissioner of Public Works
Tom DeCosta Signature of Property Owner or Representative

INSPECTOR'S REPORT

INSPECTED BY: Ken Rebello
DATE: 10/8/02
COMMENTS:

☐ APPROVED ☐ DISAPPROVED
Ken Rebello
SIGNATURE

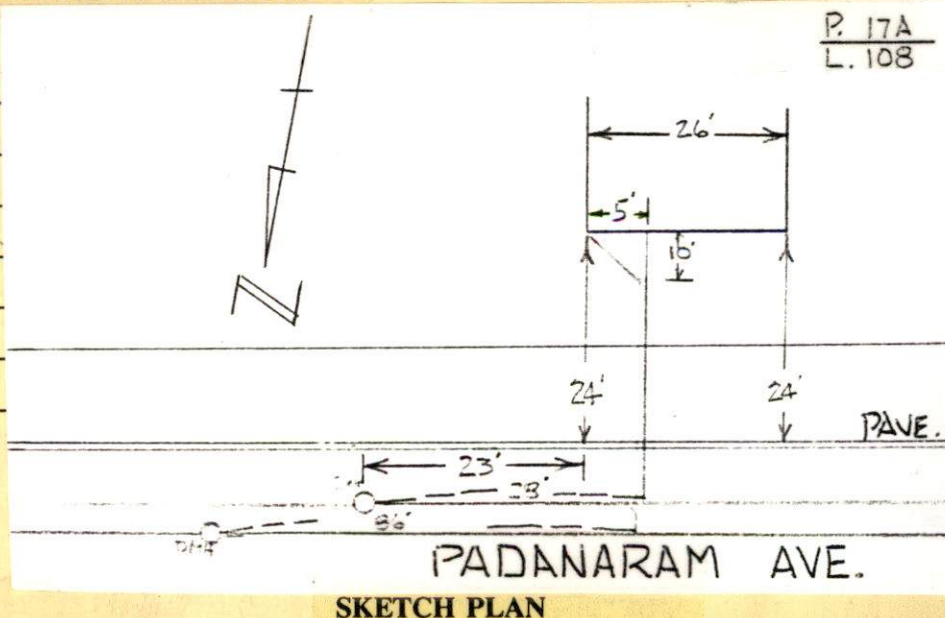

PERMIT NO.
23199



CITY OF NEW BEDFORD
SEWER AND/OR STORM DRAIN PERMIT

DATE 7/9/02
EXP 7/9/03

This certifies that permission is granted to
Thomas A. DeCosta P.O. Box 70189 N. Dartmouth MA 02747 (508) 942-247
Property Owner Address Tel.

to connect a sewer and/or storm drain located at Padanaram Ave. (S.S.) at Intersection w/ Norwell St.
Assessor's Plot 17A, Lot 108, to the sewer and/or storm drain in Padanaram Ave. Street
to be laid in accordance with the conditions in this application and the City of New Bedford ordinances.

TYPE OF USE: ☒ RESIDENTIAL ☐ COMMERCIAL ☐ INDUSTRIAL ☐ OTHER

330 GPD

If applicant other than actual property owner, attach Letter of Authorization from Property Owner.

Name N/A Tel. _____

Mailing Address _____

The Bonded Contractor/Drain Layer authorized to perform this work is: (will call us)

Name _____ Address _____ Tel. _____

Type of Pipe Required: PVC SDR 35

PERMIT EXPIRES ONE YEAR AFTER DATE OF ISSUE

- * Requires separate connections for sewage and storm drain where applicable. Storm water cannot be discharged to a sanitary sewer.
- * All work must be inspected and approved by a D.P.W. inspector before backfilling.
- * If this connection is to be part of a private service shared jointly with other building owners, attach copy of Recorded Joint Maintenance Agreement.
- * Permits can be issued to Industrial and/or Commercial Applicants only upon receipt and approval by the Commissioner of Public Works of required plans and supplemental information.
- * In addition, a City-issued Industrial User Discharge Permit and/or a Sewer Extension/Connection Permit issued by the Commonwealth of Massachusetts D.E.P. shall be required by the City for Industrial Discharge into the sewer system.

Industrial User Discharge Permit No. _____ Date _____

Comm. Mass. Sewer Conn./Ext. Permit No. _____ Date _____

A Filing and Inspection Fee of \$ 150.00 plus an Entrance Fee of \$ _____ where applicable, must accompany this application.

Bank # ROCKLAND FEDERN Check # 0115 Date: 7/09/02 Receipt # 4273

Other requirements: Inspection Only - Connecting to 12" sewer main and 10" storm drain in padanaram Ave.

Connection made to ☒ Sewer ☒ Storm Drain
Part of jointly-shared private line ☐ Yes ☒ No

FOR INSPECTION ONLY, A 24 HOUR NOTICE IS REQUIRED AND THE CONTRACTOR/APPLICANT IS REQUIRED TO NOTIFY THE WASTEWATER DIVISION AT 991-6158

Applicant agrees to abide by the above terms, as well as all pertinent ordinances of the City of New Bedford, and such other special rules as the Commissioner of Public Works may deem necessary

Lawrence D. Worden
Commissioner of Public Works

Tom DeCosta
Signature of Property Owner or Representative

INSPECTOR'S REPORT

INSPECTED BY: _____

DATE: _____

COMMENTS: _____

☐ APPROVED ☐ DISAPPROVED

SIGNATURE

SKETCH PLAN