

PERMIT NO.

23200



CITY OF NEW BEDFORD

SEWER AND/OR STORM DRAIN PERMIT

DATE **RECEIVED**

SEP 17 2002

DEPT. OF PUBLIC WORKS
NEW BEDFORD, MASS.

This certifies that permission is granted to

WAYNE C. FERREIRA

1073 WESTGATE ST.

N.B. MA.

02745

(508) 995-6379

Property Owner

Address

Tel.

to connect a sewer and/or storm drain located at 1073 WESTGATE ST (N.S.) 160' (42) E. / Barnard St.
Assessor's Plot 134A, Lot 73, to the sewer and/or storm drain in WESTGATE ST. Street

to be laid in accordance with the conditions in this application and the City of New Bedford ordinances.

TYPE OF USE: ☒ RESIDENTIAL ☐ COMMERICAL ☐ INDUSTRIAL ☐ OTHER

330 6PD

If applicant other than actual property owner, attach Letter of Authorization from Property Owner.

Name.....Tel.....

Mailing Address.....

The Bonded Contractor/Drain Layer authorized to perform this work is:

R.T. CANESSA

PO BOX 51643

NB MA 02745

(508) 993-9508

Name

Address

Tel.

Type of Pipe Required: PVC SDR 35

PERMIT EXPIRES ONE YEAR AFTER DATE OF ISSUE

* Requires separate connections for sewage and storm drain where applicable. Storm water cannot be discharged to a sanitary sewer.

* All work must be inspected and approved by a D.P.W. inspector before backfilling.

* If this connection is to be part of a private service shared jointly with other building owners, attach copy of Recorded Joint Maintenance Agreement.

* Permits can be issued to Industrial and/or Commercial Applicants only upon receipt and approval by the Commissioner of Public Works of required plans and supplemental information.

* In addition, a City-issued Industrial User Discharge Permit and/or a Sewer Extension/Connection Permit issued by the Commonwealth of Massachusetts D.E.P. shall be required by the City for Industrial Discharge into the sewer system.

Industrial User Discharge Permit No. N/A Date.....

Comm. Mass. Sewer Conn./Ext. Permit No. N/A Date.....

A Filing and Inspection Fee of \$150.00, plus an Entrance Fee of \$150.00 where applicable, must accompany this application.

Bank # FLEET BANK Check # 188 Date: 4-10-02 Receipt # 4275

Other requirements: Inspection only, stub to property line

☒ Sewer

Connection made to

☐ Storm Drain

Part of jointly-shared private line ☐ Yes ☒ No

FOR INSPECTION ONLY, A 24 HOUR NOTICE IS REQUIRED AND THE CONTRACTOR/APPLICANT IS REQUIRED TO NOTIFY THE WASTEWATER DIVISION AT 991-6158

Applicant agrees to abide by the above terms, as well as all pertinent ordinances of the City of New Bedford, and such other special rules as the Commissioner of Public Works may deem necessary

Lawrence D. Worden
Commissioner of Public Works

Wayne C. Ferreira
Signature of Property Owner or Representative

INSPECTOR'S REPORT

INSPECTED BY: JOSEPH MARTIN

DATE: 4/26/02


COMMENTS: Joe Martin inspect
from R to house. Stub install
from main to R under
C.N.B. project.

☒ APPROVED

☐ DISAPPROVED

SIGNATURE

31-746

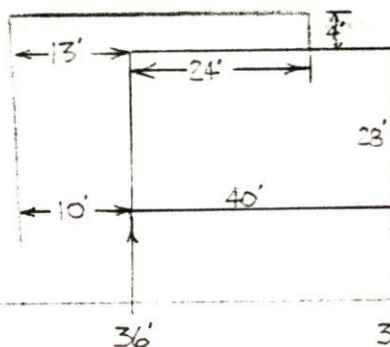

P. 134A
L. 73

0 D.M.H.

WESTGATE ST.

DAVE.

SKETCH PLAN

ST

ST. BACKLASH

20238-77

NO PERMIT
ISSUED
1975

20288-78

STUB TO
PROPERTY

1031

1073

1069

STORM DRAIN 12" PIPE

SEWER 8" PIPE

1070

NO PERMIT
ISSUED
1975

19678-74

PERMIT NO.

23200



CITY OF NEW BEDFORD

DATE 4-10-02

SEWER AND/OR STORM DRAIN PERMIT

This certifies that permission is granted to

WAYNE C FERREIRA

1073 WESTGATE ST

N.B. MA 02745 (508) 995-6879

Property Owner

Address

Tel.

to connect a sewer and/or storm drain located at 1073 WESTGATE ST

Assessor's Plot 134A, Lot 73, to the sewer and/or storm drain in WESTGATE ST Street

to be laid in accordance with the conditions in this application and the City of New Bedford ordinances.

TYPE OF USE: ☒ RESIDENTIAL ☐ COMMERICAL ☐ INDUSTRIAL ☐ OTHER

330 GPD

If applicant other than actual property owner, attach Letter of Authorization from Property Owner.

Name Tel.

Mailing Address

The Bonded Contractor/Drain Layer authorized to perform this work is:

RJ CANESSA

PO BOX 51643

NB MA 02745

(508) 993-9508

Name

Address

Tel.

Type of Pipe Required: PVC SDR 35

PERMIT EXPIRES ONE YEAR AFTER DATE OF ISSUE

* Requires separate connections for sewage and storm drain where applicable. Storm water cannot be discharged to a sanitary sewer.

* All work must be inspected and approved by a D.P.W. inspector before backfilling.

* If this connection is to be part of a private service shared jointly with other building owners, attach copy of Recorded Joint Maintenance Agreement.

* Permits can be issued to Industrial and/or Commercial Applicants only upon receipt and approval by the Commissioner of Public Works of required plans and supplemental information.

* In addition, a City-issued Industrial User Discharge Permit and/or a Sewer Extension/Connection Permit issued by the Commonwealth of Massachusetts D.E.P. shall be required by the City for Industrial Discharge into the sewer system.

Industrial User Discharge Permit No. N/A Date

Comm. Mass. Sewer Conn./Ext. Permit No. N/A Date

A Filing and Inspection Fee of \$150.00, plus an Entrance Fee of \$150.00 where applicable, must accompany this application.

Bank # FLEET BANK Check # 188 Date: 4-10-02 Receipt # 4275

Other requirements: Inspection only, stub to property line

☒ Sewer

Connection made to

☐ Storm Drain

Part of jointly-shared private line ☐ Yes ☒ No

FOR INSPECTION ONLY, A 24 HOUR NOTICE IS REQUIRED AND THE CONTRACTOR/APPLICANT IS REQUIRED TO NOTIFY THE WASTEWATER DIVISION AT 991-6158

Applicant agrees to abide by the above terms, as well as all pertinent ordinances of the City of New Bedford, and such other special rules as the Commissioner of Public Works may deem necessary

Lawrence D. Worden (ms)

Commissioner of Public Works

Wayne C Ferreira

Signature of Property Owner or Representative

INSPECTOR'S REPORT

INSPECTED BY:

DATE:

COMMENTS:

☐ APPROVED

☐ DISAPPROVED

SIGNATURE

SKETCH PLAN