

PERMIT NO.

23204



CITY OF NEW BEDFORD

SEWER AND/OR STORM DRAIN PERMIT

RECEIVED

SEP 17 2002

DEPT. OF PUBLIC WORKS
NEW BEDFORD, MASS

(508) 993-8088

This certifies that permission is granted to

DAVID DUCHAINE 53 CHURCH ST. N.B. MA.

Property Owner

Address

Tel.

to connect a sewer and/or storm drain located at 53 CHURCH ST. (a.s.) 25 1/2 Collette St.

Assessor's Plot 102, Lot 173, to the sewer and/or storm drain in Collette St. Street

to be laid in accordance with the conditions in this application and the City of New Bedford ordinances.

TYPE OF USE: ☐ RESIDENTIAL ☐ COMMERICAL ☐ INDUSTRIAL ☒ OTHER GYM

If applicant other than actual property owner, attach Letter of Authorization from Property Owner.

Name JOSEPH E. DUPRE III

(508) 993-8088

Tel.

2,500 GPD
25 GAL PER PARTICIPANT
ESTIMATED 100 PER DAY

Mailing Address 369 NASH RD. N.B. MA. 02746

The Bonded Contractor/Drain Layer authorized to perform this work is:

Joe Dupre, Inc.

369 Nash Rd.

New Bedford

508-993-8088

Name

Address

Tel.

Type of Pipe Required: PVC SDR 35

PERMIT EXPIRES ONE YEAR AFTER DATE OF ISSUE

* Requires separate connections for sewage and storm drain where applicable. Storm water cannot be discharged to a sanitary sewer.

* All work must be inspected and approved by a D.P.W. inspector before backfilling.

* If this connection is to be part of a private service shared jointly with other building owners, attach copy of Recorded Joint Maintenance Agreement.

* Permits can be issued to Industrial and/or Commercial Applicants only upon receipt and approval by the Commissioner of Public Works of required plans and supplemental information.

* In addition, a City-issued Industrial User Discharge Permit and/or a Sewer Extension/Connection Permit issued by the Commonwealth of Massachusetts D.E.P. shall be required by the City for Industrial Discharge into the sewer system.

Industrial User Discharge Permit No. N/A Date

Comm. Mass. Sewer Conn./Ext. Permit No. N/A Date

A Filing and Inspection Fee of \$150.00, plus an Entrance Fee of \$ where applicable, must accompany this application.

Bank # Compass Bank Check # 1049 Date: 4-18-02 Receipt # 4281

Other requirements: inspection only

☒ Sewer

Connection made to

Part of jointly-shared private line ☐ Yes ☒ No

☐ Storm Drain

Applicant agrees to abide by the above terms, as well as all pertinent ordinances of the City of New Bedford, and such other special rules as the Commissioner of Public Works may deem necessary

Lawrence D. W...
Commissioner of Public Works


Joseph E. Dupre III
Signature of Property Owner or Representative

INSPECTOR'S REPORT

INSPECTED BY: JOSEPH MARTIN

DATE: 6/24/02

COMMENTS:

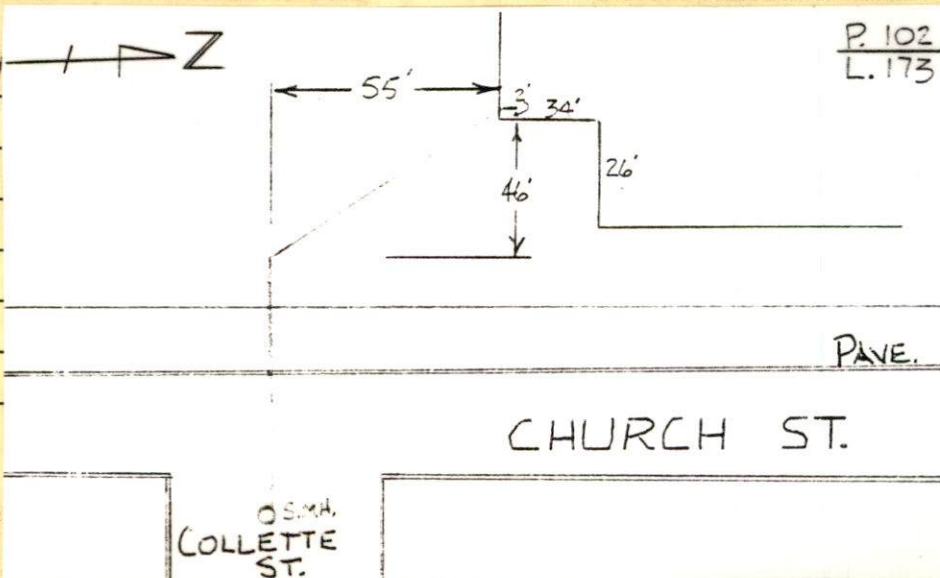

☒ APPROVED

☐ DISAPPROVED

SIGNATURE

SKETCH PLAN

PERMIT NO.

23204



CITY OF NEW BEDFORD

DATE 4/18/02

SEWER AND/OR STORM DRAIN PERMIT

This certifies that permission is granted to

DAVID DUCHAINE

53 CHURCH ST - N.B. MA.

(508) 993-8088

Property Owner

Address

Tel.

to connect a sewer and/or storm drain located at 53 CHURCH ST.

Assessor's Plot 102, Lot 173, to the sewer and/or storm drain in Collette St. Street

to be laid in accordance with the conditions in this application and the City of New Bedford ordinances.

TYPE OF USE: ☐ RESIDENTIAL ☐ COMMERICAL ☐ INDUSTRIAL ☒ OTHER GYM

2,500 GPD

If applicant other than actual property owner, attach Letter of Authorization from Property Owner

Name JOSEPH E. DUPRE III

(508) 993-8088

25 GAL PER PARTICIPANT
ESTIMATED 100 PER DAY

Mailing Address 369 NASH RD. N.B. MA. 02746

The Bonded Contractor/Drain Layer authorized to perform this work is:

Joe Dupre, Inc.

369 Nash Rd.

New Bedford

508-993-8088

Name

Address

Tel.

Type of Pipe Required: PVC SDR 35

PERMIT EXPIRES ONE YEAR AFTER DATE OF ISSUE

* Requires separate connections for sewage and storm drain where applicable. Storm water cannot be discharged to a sanitary sewer.

* All work must be inspected and approved by a D.P.W. inspector before backfilling.

* If this connection is to be part of a private service shared jointly with other building owners, attach copy of Recorded Joint Maintenance Agreement.

* Permits can be issued to Industrial and/or Commercial Applicants only upon receipt and approval by the Commissioner of Public Works of required plans and supplemental information.

* In addition, a City-issued Industrial User Discharge Permit and/or a Sewer Extension/Connection Permit issued by the Commonwealth of Massachusetts D.E.P. shall be required by the City for Industrial Discharge into the sewer system.

Industrial User Discharge Permit No. N/A Date

Comm. Mass. Sewer Conn./Ext. Permit No. N/A Date

A Filing and Inspection Fee of \$150.00, plus an Entrance Fee of \$ where applicable, must accompany this application.

Bank # Compass Bank Check # 1049 Date: 4-18-02 Receipt # 4281

Other requirements: inspection only

☒ Sewer

Connection made to

Part of jointly-shared private line ☐ Yes ☒ No

☐ Storm Drain

Applicant agrees to abide by the above terms, as well as all pertinent ordinances of the City of New Bedford, and such other special rules as the Commissioner of Public Works may deem necessary

Andrew D. Worsley
Commissioner of Public Works

Joseph E. Dupre III
Signature of Property Owner or Representative

INSPECTOR'S REPORT

INSPECTED BY:

DATE:

COMMENTS:

☐ APPROVED

☐ DISAPPROVED

SIGNATURE

SKETCH PLAN



53 Church Street
New Bedford, MA 02746
Telephone (508) 993-7900

JOE DUPRE III, from "Dupre
Construction", HAS my permission to
REPRESENT ME, REGARDING SERVICE into my
building. (WIZARD REALITY)

DAVID DUCHAINE
David Duchaîne
owner/HGR
04-17-02