

PERMIT NO.

23208



CITY OF NEW BEDFORD

SEWER AND/OR STORM DRAIN PERMIT

DATE 4/18/02
RECEIVED

SEP 17 2002

DEPT. OF PUBLIC WORKS
NEW BEDFORD, MASS

508-797-0353

This certifies that permission is granted to

Amelia Araujo

19 Welcome St. New Bedford

Property Owner

Address

Frank St. (SS) #116

Tel.

to connect a sewer and/or storm drain located at 128' W. Core Rd.

Assessor's Plot 17, Lot 267, to the sewer and/or storm drain in Frank St. Street

to be laid in accordance with the conditions in this application and the City of New Bedford ordinances.

TYPE OF USE: ☒ RESIDENTIAL ☐ COMMERCIAL ☐ INDUSTRIAL ☐ OTHER

330 GPD

If applicant other than actual property owner, attach Letter of Authorization from Property Owner.

Name.....Tel.....

Mailing Address.....

The Bonded Contractor/Drain Layer authorized to perform this work is:

Braga Bobcat

3 E Wardell St. Dartmouth, MA 994-7968

Name

Address

Tel.

Type of Pipe Required: PVC SDR-35

PERMIT EXPIRES ONE YEAR AFTER DATE OF ISSUE

* Requires separate connections for sewage and storm drain where applicable. Storm water cannot be discharged to a sanitary sewer.

* All work must be inspected and approved by a D.P.W. inspector before backfilling.

* If this connection is to be part of a private service shared jointly with other building owners, attach copy of Recorded Joint Maintenance Agreement.

* Permits can be issued to Industrial and/or Commercial Applicants only upon receipt and approval by the Commissioner of Public Works of required plans and supplemental information.

* In addition, a City-issued Industrial User Discharge Permit and/or a Sewer Extension/Connection Permit issued by the Commonwealth of Massachusetts D.E.P. shall be required by the City for Industrial Discharge into the sewer system.

Industrial User Discharge Permit No.....Date.....

Comm. Mass. Sewer Conn./Ext. Permit No.....Date.....

A Filing and Inspection Fee of \$....., plus an Entrance Fee of \$..... where applicable, must accompany this application.

Bank # St. Credit Union Bank Check # 206 Date: 4/18/02 Receipt # 4285

Other requirements: Insp. Only - 12" Storm Drain

+ 10" Sewer

☒ Sewer

Connection made to

Part of jointly-shared private line ☐ Yes ☒ No

☒ Storm Drain

Applicant agrees to abide by the above terms, as well as all pertinent ordinances of the City of New Bedford, and such other special rules as the Commissioner of Public Works may deem necessary

Laurence D. Worden (me)

Commissioner of Public Works

Signature of Property Owner or Representative

INSPECTOR'S REPORT

INSPECTED BY: JOSEPH MARTIN


DATE: 5/8/02

COMMENTS:

☒ APPROVED ☐ DISAPPROVED

Joseph Martin

SIGNATURE

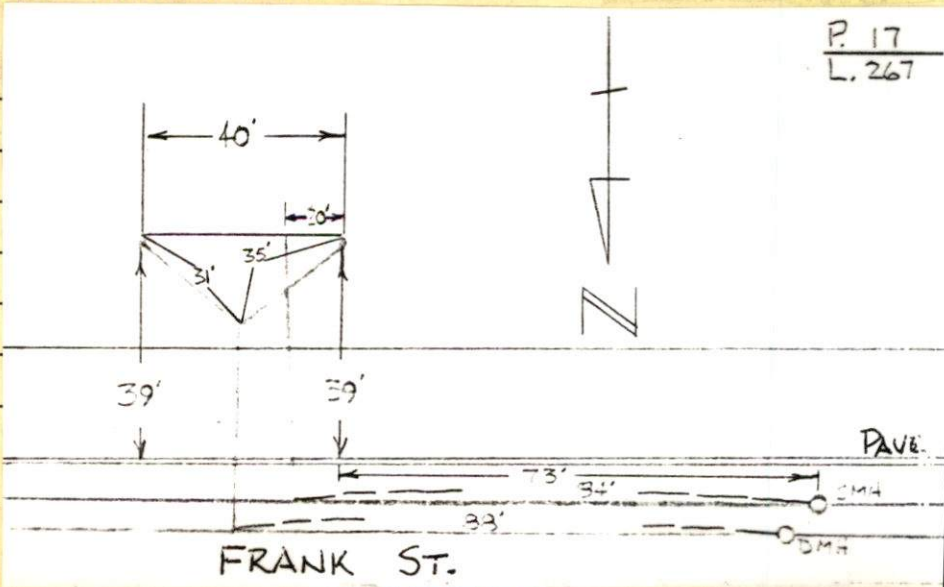

FRANK ST.

SKETCH PLAN

PERMIT NO. 23208



CITY OF NEW BEDFORD

DATE 4/18/02

SEWER AND/OR STORM DRAIN PERMIT

This certifies that permission is granted to
Amelia Araujo 19 Welcome St. New Bedford 508-997-0353
Property Owner Address Tel.
to connect a sewer and/or storm drain located at 120' W. Care Rd
Assessor's Plot 17, Lot 267, to the sewer and/or storm drain in Frank St Street
to be laid in accordance with the conditions in this application and the City of New Bedford ordinances.
TYPE OF USE: ☒ RESIDENTIAL ☐ COMMERICAL ☐ INDUSTRIAL ☐ OTHER 330 EPD
If applicant other than actual property owner, attach Letter of Authorization from Property Owner.
Name.....Tel.....
Mailing Address.....
The Bonded Contractor/Drain Layer authorized to perform this work is:
Braga Bobcat 3 E Wardell St. So. Dartmouth, MA 994-7968
Name Address Tel.
Type of Pipe Required: PVC SDR-35
PERMIT EXPIRES ONE YEAR AFTER DATE OF ISSUE

- * Requires separate connections for sewage and storm drain where applicable. Storm water cannot be discharged to a sanitary sewer.
- * All work must be inspected and approved by a D.P.W. inspector before backfilling.
- * If this connection is to be part of a private service shared jointly with other building owners, attach copy of Recorded Joint Maintenance Agreement.
- * Permits can be issued to Industrial and/or Commercial Applicants only upon receipt and approval by the Commissioner of Public Works of required plans and supplemental information.
- * In addition, a City-issued Industrial User Discharge Permit and/or a Sewer Extension/Connection Permit issued by the Commonwealth of Massachusetts D.E.P. shall be required by the City for Industrial Discharge into the sewer system.

Industrial User Discharge Permit No.....Date.....
Comm. Mass. Sewer Conn./Ext. Permit No.....Date.....
A Filing and Inspection Fee of \$....., plus an Entrance Fee of \$..... where applicable, must accompany this application.
Bank # St. Credit Union Bank Check # 206 Date: 4/18/02 Receipt # 4285
Other requirements: Insp. Only - 12" Storm Drain
+ 10" Sewer

☒ Sewer
Connection made to ☒ Storm Drain Part of jointly-shared private line ☐ Yes ☒ No

Applicant agrees to abide by the above terms, as well as all pertinent ordinances of the City of New Bedford, and such other special rules as the Commissioner of Public Works may deem necessary

Lawrence D. Libraden
Commissioner of Public Works


John Sousa
Signature of Property Owner or Representative

INSPECTOR'S REPORT

INSPECTED BY: _____
DATE: _____
COMMENTS: _____

☐ APPROVED ☐ DISAPPROVED

SIGNATURE

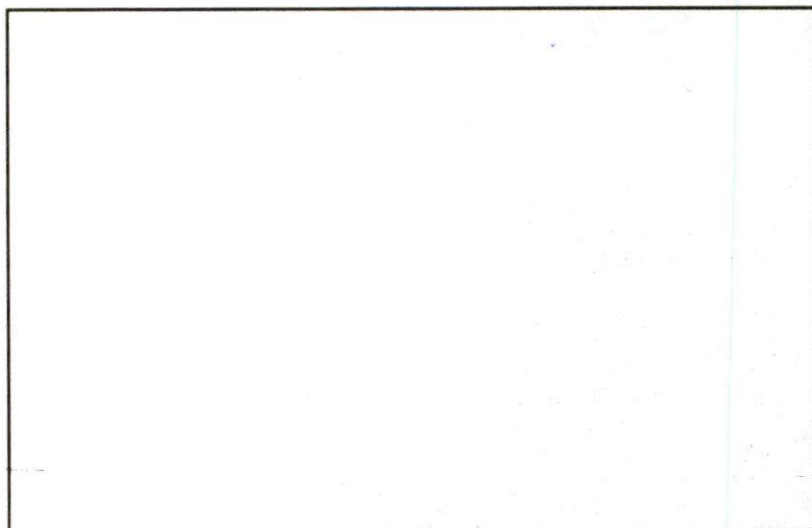

SKETCH PLAN



**CITY OF NEW BEDFORD
MASSACHUSETTS**

DEPARTMENT OF PUBLIC WORKS
ENGINEERING DIVISION

133 WILLIAM STREET, ROOM 303
NEW BEDFORD, MA 02740

Tel: (508) 979-1527

Fax: (508) 961-3043

To Whom It May Concern:

I, AMELIA ARAUJO, being
(Name) (Mailing Address)

Owner of property located at FRANK ST

Plot 17, Lot 267, hereby agree to allow John Sousa
(Name)

19 WELCOME ST N.B to act on my behalf including affixing my
(Mailing Address)

signature in securing permit for:

- ☒ Sewer/Drain Service Permits
- ☒ Water Service Permits
- ☒ Driveway Installation Permits
- ☒ Sidewalk Installation Permits

I further agree to conform to, and abide by, all City rules and ask regulations applicable to the permit (s) being applied for:

Name Amelia Araujo
(Signature)

19 Welcome st
(Address)

4-18-02
(Date) (Telephone number)