

PERMIT NO.
23216



CITY OF NEW BEDFORD

DATE 5/20/02 RECEIVED

SEWER AND/OR STORM DRAIN PERMIT

SEP 17 2002

DEPT. OF PUBLIC WORKS
NEW BEDFORD, MASS

This certifies that permission is granted to

ANTONIO PEREIRA, TRS.

SNOW ST. REALTY TRUST

P.O. Box 2026 New Bedford

MA 02741

Property Owner

Address

#52

Tel. 508-993-3637

to connect a sewer and/or storm drain located at Brownell Ave. (E) 150'± Sx Ryan St.
Assessor's Plot 38, Lot 384, to the sewer and/or storm drain in Brownell Ave Street

to be laid in accordance with the conditions in this application and the City of New Bedford ordinances.

TYPE OF USE: ☒ RESIDENTIAL ☐ COMMERICAL ☐ INDUSTRIAL ☐ OTHER

330 GPD

If applicant other than actual property owner, attach Letter of Authorization from Property Owner.

Name..... Tel.....

Mailing Address.....

The Bonded Contractor/Drain Layer authorized to perform this work is:

Nelson Cardoso Paving + Const.

12 White St. Acushnet

508-998-5115

Name

Address

Tel.

Type of Pipe Required: PVC SDR-35

PERMIT EXPIRES ONE YEAR AFTER DATE OF ISSUE

* Requires separate connections for sewage and storm drain where applicable. Storm water cannot be discharged to a sanitary sewer.

* All work must be inspected and approved by a D.P.W. inspector before backfilling.

* If this connection is to be part of a private service shared jointly with other building owners, attach copy of Recorded Joint Maintenance Agreement.

* Permits can be issued to Industrial and/or Commercial Applicants only upon receipt and approval by the Commissioner of Public Works of required plans and supplemental information.

* In addition, a City-issued Industrial User Discharge Permit and/or a Sewer Extension/Connection Permit issued by the Commonwealth of Massachusetts D.E.P. shall be required by the City for Industrial Discharge into the sewer system.

Industrial User Discharge Permit No..... Date.....

Comm. Mass. Sewer Conn./Ext. Permit No..... Date.....

A Filing and Inspection Fee of \$ 150.00, plus an Entrance Fee of \$..... where applicable, must accompany this application.

Bank # Compass Bank Check # 6049 Date: 5/20/02 Receipt # 4310
Other requirements: Insp. Only - Must be installed before 8" Sewer + 10" Storm Drain

Final Paving Compact in 6" lifts + install binder flush with existing Binder Roadway.

Connection made to

☐ Sewer

Part of jointly-shared private line ☐ Yes ☒ No

☒ Storm Drain

FOR INSPECTION ONLY, A 24 HOUR NOTICE IS REQUIRED AND THE CONTRACTOR/APPLICANT IS REQUIRED TO NOTIFY THE WASTEWATER DIVISION AT 991-6158

Applicant agrees to abide by the above terms, as well as all pertinent ordinances of the City of New Bedford, and such other special rules as the Commissioner of Public Works may deem necessary

Lawrence D. Warden ms
Commissioner of Public Works

[Signature]
Signature of Property Owner or Representative

INSPECTOR'S REPORT

INSPECTED BY: JOSEPH MARTIN

DATE: 7/24/02


COMMENTS:

☒ APPROVED

☐ DISAPPROVED

SIGNATURE

31-746

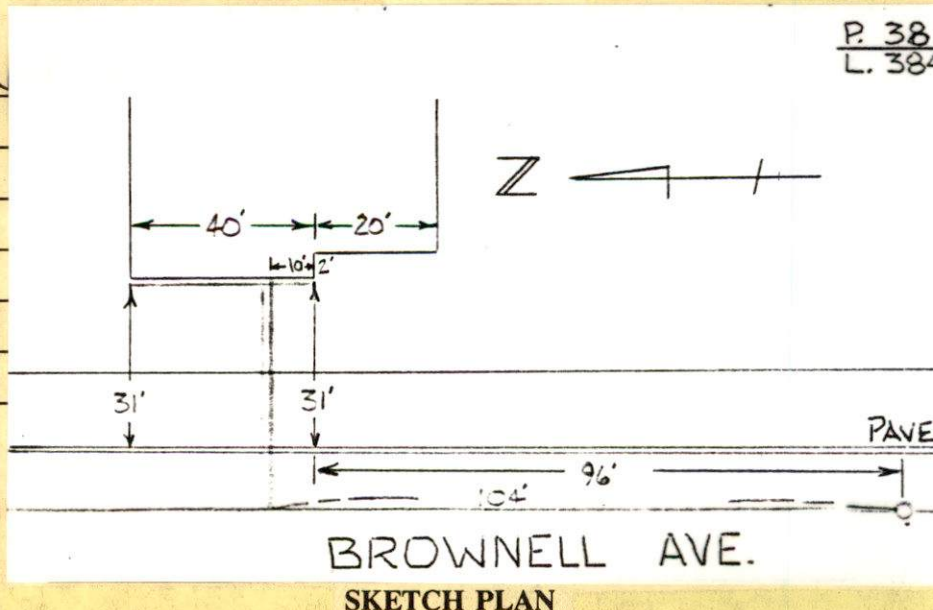

PERMIT NO.
23216



CITY OF NEW BEDFORD

DATE 5/20/02

SEWER AND/OR STORM DRAIN PERMIT

This certifies that permission is granted to ANTONIO PEREIRA, TRS.

Property Owner SNOW ST. REALTY TRUST Address P.O. Box 2026 New Bedford MA 02741 Tel. 508-993-3637

to connect a sewer and/or storm drain located at Brawnell Ave (Es) 150'± Sx Ryan St. Assessor's Plot 38, Lot 384, to the sewer and/or storm drain in Brawnell Ave Street to be laid in accordance with the conditions in this application and the City of New Bedford ordinances.

TYPE OF USE: [X] RESIDENTIAL [] COMMERICAL [] INDUSTRIAL [] OTHER

330 GPD

If applicant other than actual property owner, attach Letter of Authorization from Property Owner.

Name Tel

Mailing Address

The Bonded Contractor/Drain Layer authorized to perform this work is:

Name Nelson Cardoso Paving + Const. Address 12 White St. Acushnet Tel. 508-998-5115

Type of Pipe Required: PVC SDR-35

PERMIT EXPIRES ONE YEAR AFTER DATE OF ISSUE

- * Requires separate connections for sewage and storm drain where applicable. Storm water cannot be discharged to a sanitary sewer.
- * All work must be inspected and approved by a D.P.W. inspector before backfilling.
- * If this connection is to be part of a private service shared jointly with other building owners, attach copy of Recorded Joint Maintenance Agreement.
- * Permits can be issued to Industrial and/or Commercial Applicants only upon receipt and approval by the Commissioner of Public Works of required plans and supplemental information.
- * In addition, a City-issued Industrial User Discharge Permit and/or a Sewer Extension/Connection Permit issued by the Commonwealth of Massachusetts D.E.P. shall be required by the City for Industrial Discharge into the sewer system.

Industrial User Discharge Permit No. Date

Comm. Mass. Sewer Conn./Ext. Permit No. Date

A Filing and Inspection Fee of \$150.00, plus an Entrance Fee of \$ where applicable, must accompany this application.

Bank # Compass Bank Check # 6049 Date: 5/20/02 Receipt # 4310
Other requirements: Insp. Only - Must be installed before 8" Sewer + 10" Storm Drain

Final Paving Compact in 6" lifts + install binder flush with existing Binder Roadway.
[X] Sewer

Connection made to [X] Storm Drain Part of jointly-shared private line [] Yes [X] No

FOR INSPECTION ONLY, A 24 HOUR NOTICE IS REQUIRED AND THE CONTRACTOR/APPLICANT IS REQUIRED TO NOTIFY THE WASTEWATER DIVISION AT 991-6158

Applicant agrees to abide by the above terms, as well as all pertinent ordinances of the City of New Bedford, and such other special rules as the Commissioner of Public Works may deem necessary

Signature of Commissioner of Public Works
Commissioner of Public Works

Signature of Property Owner or Representative

INSPECTOR'S REPORT

INSPECTED BY:

DATE:

COMMENTS:

[] APPROVED [] DISAPPROVED

SIGNATURE

SKETCH PLAN