

PERMIT NO.

23224



CITY OF NEW BEDFORD

DATE 5/31/02
EXP. 5/31/03

SEWER AND/OR STORM DRAIN PERMIT

This certifies that permission is granted to Donald Rodrigues, Pres.

Sunset Realty Development Inc. 386 Division Rd. So. Dartmouth, MA 01968-0379
Property Owner Address Tel.

to connect a sewer and/or storm drain located at Sunset Way (SS) 170'± Ex Acushnet Ave.

Assessor's Plot 132 I, Lot 136, to the sewer and/or storm drain in Sunset Way **RECEIVED** Street

to be laid in accordance with the conditions in this application and the City of New Bedford ordinances. **JAN 30 2003**

TYPE OF USE: ☒ RESIDENTIAL ☐ COMMERICAL ☐ INDUSTRIAL ☐ OTHER 330-660 DEPT. OF PUBLIC WORKS
NEW BEDFORD, MASS

If applicant other than actual property owner, attach Letter of Authorization from Property Owner.

Name.....Tel.....

Mailing Address.....

The Bonded Contractor/Drain Layer authorized to perform this work is:

P.J. Canessa 915 Hathaway Rd. P.O. Box 51643 508-993-9508
Name Address Tel.

Type of Pipe Required: PVC SDR-35

PERMIT EXPIRES ONE YEAR AFTER DATE OF ISSUE

- * Requires separate connections for sewage and storm drain where applicable. Storm water cannot be discharged to a sanitary sewer.
- * All work must be inspected and approved by a D.P.W. inspector before backfilling.
- * If this connection is to be part of a private service shared jointly with other building owners, attach copy of Recorded Joint Maintenance Agreement.
- * Permits can be issued to Industrial and/or Commercial Applicants only upon receipt and approval by the Commissioner of Public Works of required plans and supplemental information.
- * In addition, a City-issued Industrial User Discharge Permit and/or a Sewer Extension/Connection Permit issued by the Commonwealth of Massachusetts D.E.P. shall be required by the City for Industrial Discharge into the sewer system.

Industrial User Discharge Permit No.....Date.....

Comm. Mass. Sewer Conn./Ext. Permit No.....Date.....

A Filing and Inspection Fee of \$ 150.00, plus an Entrance Fee of \$..... where applicable, must accompany this application.

Bank # Bank of Fall River Check # 2083 Date: 5/31/02 Receipt # 4317

Other requirements: Insp. Only

8" Sewer, 12" Storm Drain

Connection made to ☐ Sewer ☒ Storm Drain Part of jointly-shared private line ☐ Yes ☒ No

Applicant agrees to abide by the above terms, as well as all pertinent ordinances of the City of New Bedford, and such other special rules as the Commissioner of Public Works may deem necessary

Lawrence D. Worden (m)
Commissioner of Public Works

[Signature]
Signature of Property Owner or Representative

INSPECTOR'S REPORT

INSPECTED BY: JOE MARTIN


DATE: 5/31/02

COMMENTS:

STORM DRAIN NOT AVAIL.
TO THIS LOT. SUBDIVISION
has on-site drainage system

☒ APPROVED ☐ DISAPPROVED

[Signature]
SIGNATURE

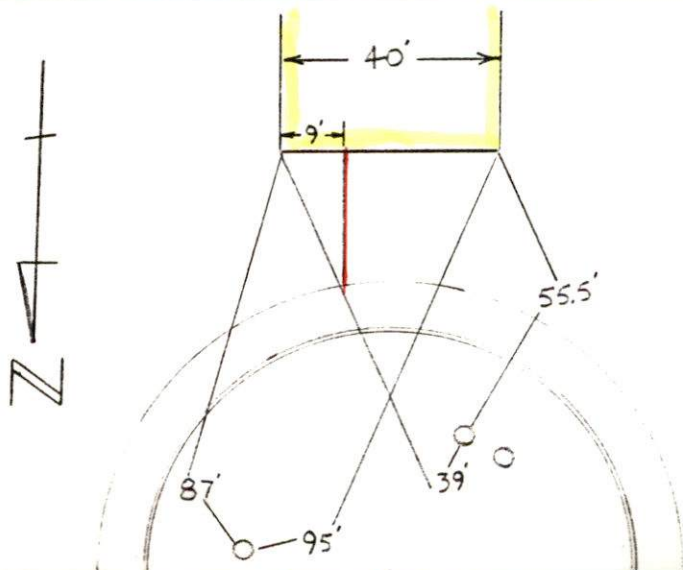

SKETCH PLAN

P. 132 I
L. 136

PERMIT NO.
23224



CITY OF NEW BEDFORD
SEWER AND/OR STORM DRAIN PERMIT

DATE 5/31/02
EXP. 5/31/03

This certifies that permission is granted to Donald Rodrigues, Pres.
Sunset Realty Development Inc. 386 Division Rd. So. Dartmouth, MA 01966-0379
Property Owner Address Tel.

to connect a sewer and/or storm drain located at Sunset Way (SS) 170'± Ex Acushnet Ave.
Assessor's Plot 132 I, Lot 136, to the sewer and/or storm drain in Sunset Way Street

to be laid in accordance with the conditions in this application and the City of New Bedford ordinances.
TYPE OF USE: ☒ RESIDENTIAL ☐ COMMERCIAL ☐ INDUSTRIAL ☐ OTHER 3306 PD

If applicant other than actual property owner, attach Letter of Authorization from Property Owner.
Name.....Tel.....
Mailing Address.....

The Bonded Contractor/Drain Layer authorized to perform this work is:
R.J. Canessa 915 Hathaway Rd. P.O. Box 51643 508-993-9508
Name Address Tel.

Type of Pipe Required: PVC SDR-35
PERMIT EXPIRES ONE YEAR AFTER DATE OF ISSUE

- * Requires separate connections for sewage and storm drain where applicable. Storm water cannot be discharged to a sanitary sewer.
- * All work must be inspected and approved by a D.P.W. inspector before backfilling.
- * If this connection is to be part of a private service shared jointly with other building owners, attach copy of Recorded Joint Maintenance Agreement.
- * Permits can be issued to Industrial and/or Commercial Applicants only upon receipt and approval by the Commissioner of Public Works of required plans and supplemental information.
- * In addition, a City-issued Industrial User Discharge Permit and/or a Sewer Extension/Connection Permit issued by the Commonwealth of Massachusetts D.E.P. shall be required by the City for Industrial Discharge into the sewer system.

Industrial User Discharge Permit No.....Date.....
Comm. Mass. Sewer Conn./Ext. Permit No.....Date.....

A Filing and Inspection Fee of \$ 150.00, plus an Entrance Fee of \$..... where applicable, must accompany this application.

Bank # Bank of Fall River Check # 2083 Date: 5/31/02 Receipt # 4317

Other requirements: Insp. Only
8" Sewer, 12" Storm Drain

Connection made to ☒ Sewer ☐ Storm Drain
Part of jointly-shared private line ☐ Yes ☒ No


Applicant agrees to abide by the above terms, as well as all pertinent ordinances of the City of New Bedford, and such other special rules as the Commissioner of Public Works may deem necessary
Lawrence D. Worden (m) [Signature]
Commissioner of Public Works Signature of Property Owner or Representative

INSPECTOR'S REPORT

INSPECTED BY: _____
DATE: _____
COMMENTS: _____

☐ APPROVED ☐ DISAPPROVED

SIGNATURE

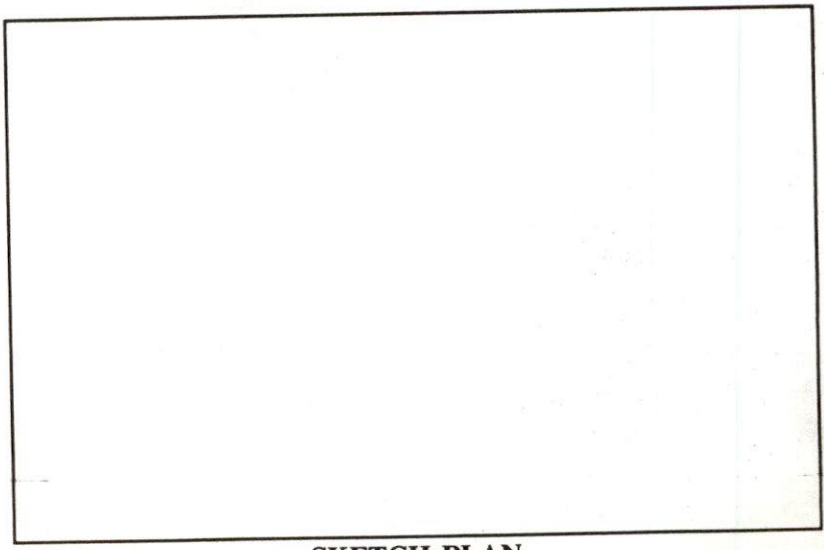

SKETCH PLAN