

PERMIT NO.

23227



CITY OF NEW BEDFORD

SEWER AND/OR STORM DRAIN PERMIT

DATE 6-10-02
RECEIVED

SEP 17 2002

DEPT. OF PUBLIC WORKS
NEW BEDFORD, MASS.

This certifies that permission is granted to

David & Frank Stringer 244 Wilbur St. NB MA (508) 991-1611
Property Owner Address Tel.
to connect a sewer and/or storm drain located at Wilbur St. # 244 (S.S.) 240' W. / Rockdale Ave.
Assessor's Plot 80, Lot 26, to the sewer and/or storm drain in Wilbur Street

to be laid in accordance with the conditions in this application and the City of New Bedford ordinances.

TYPE OF USE: ☒ RESIDENTIAL ☐ COMMERICAL ☐ INDUSTRIAL ☐ OTHER

220 6PD

If applicant other than actual property owner, attach Letter of Authorization from Property Owner.

Name N/A Tel.

Mailing Address 12 Ventura Dr. N. Dartmouth, MA (508) 995-3535

The Bonded Contractor/Drain Layer authorized to perform this work is:

J.S. Luiz, Inc. 12 Ventura Dr. N. Dartmouth, MA (508) 995-3535
Name Address Tel.

Type of Pipe Required: PVC 50K 35

PERMIT EXPIRES ONE YEAR AFTER DATE OF ISSUE

- * Requires separate connections for sewage and storm drain where applicable. Storm water cannot be discharged to a sanitary sewer.
- * All work must be inspected and approved by a D.P.W. inspector before backfilling.
- * If this connection is to be part of a private service shared jointly with other building owners, attach copy of Recorded Joint Maintenance Agreement.
- * Permits can be issued to Industrial and/or Commercial Applicants only upon receipt and approval by the Commissioner of Public Works of required plans and supplemental information.
- * In addition, a City-issued Industrial User Discharge Permit and/or a Sewer Extension/Connection Permit issued by the Commonwealth of Massachusetts D.E.P. shall be required by the City for Industrial Discharge into the sewer system.

Industrial User Discharge Permit No. N/A Date

Comm. Mass. Sewer Conn./Ext. Permit No. N/A Date

A Filing and Inspection Fee of \$150.00, plus an Entrance Fee of \$396.90 where applicable, must accompany this application.

Bank # Compass Bank Check # 482 Date: 6/10/02 Receipt # 4323

Other requirements: Inspection Only - Route St. Sewer Proj. Stub = 27' x \$14.70/ft =

\$396.90 plus \$150.00 Inspection Fee. Total = \$546.90

Owner/Contractor to contact Health Dept. Re: Abandoning Septic system.

Connection made to ☒ Sewer ☐ Storm Drain
Part of jointly-shared private line ☐ Yes ☒ No

Applicant agrees to abide by the above terms, as well as all pertinent ordinances of the City of New Bedford, and such other special rules as the Commissioner of Public Works may deem necessary

Edward A. Anderson Commissioner of Public Works
David W. Stringer Signature of Property Owner or Representative


INSPECTED BY: KEVIN CORNELL

DATE: 7/2/02

COMMENTS: Inspected from house to PR by Kevin C. 7/2/02. Stub from main to PR - Route St. Sewer Project - inspected by C.D.M.

☒ APPROVED ☐ DISAPPROVED

Kevin J. Cornell
SIGNATURE

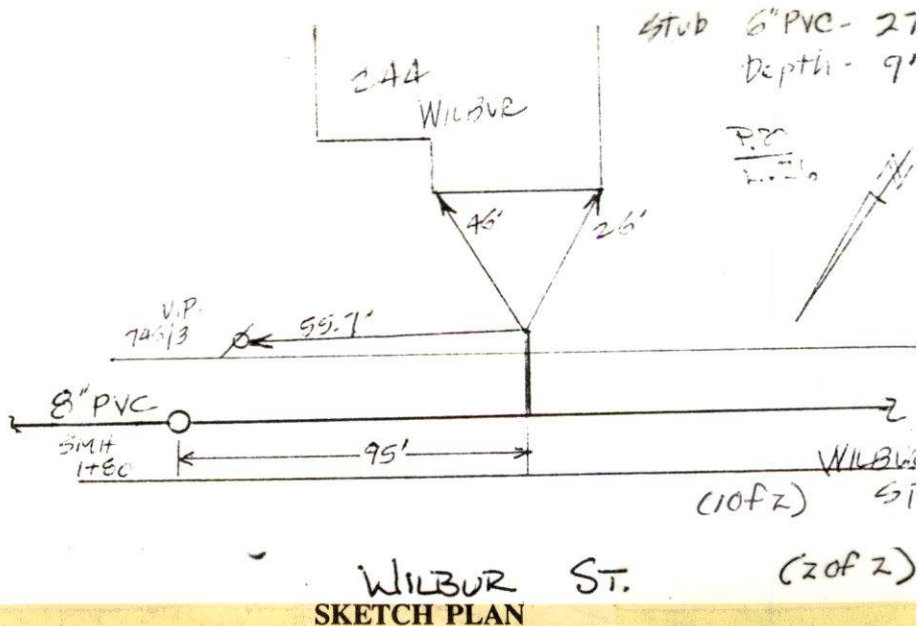

PERMIT NO.

23227



CITY OF NEW BEDFORD

DATE 6-10-02

SEWER AND/OR STORM DRAIN PERMIT

This certifies that permission is granted to

David & Edna Stringer 244 Wilbur St. NB MA (508) 997-1697
 Property Owner Address 02740 Tel.

to connect a sewer and/or storm drain located at Wilbur St. # 244
 Assessor's Plot 80, Lot 26, to the sewer and/or storm drain in Wilbur Street

to be laid in accordance with the conditions in this application and the City of New Bedford ordinances.

TYPE OF USE: ☒ RESIDENTIAL ☐ COMMERICAL ☐ INDUSTRIAL ☐ OTHER 220 6PD

If applicant other than actual property owner, attach Letter of Authorization from Property Owner.

Name N/A Tel.

Mailing Address T.S. Luiz

The Bonded Contractor/Drain Layer authorized to perform this work is:

T.S. Luiz, Inc. 12 Ventura Dr. N. Dartmouth MA (508) 995-3535
 Name Address 02747 Tel.

Type of Pipe Required: PVC SDR 35

PERMIT EXPIRES ONE YEAR AFTER DATE OF ISSUE

- * Requires separate connections for sewage and storm drain where applicable. Storm water cannot be discharged to a sanitary sewer.
- * All work must be inspected and approved by a D.P.W. inspector before backfilling.
- * If this connection is to be part of a private service shared jointly with other building owners, attach copy of Recorded Joint Maintenance Agreement.
- * Permits can be issued to Industrial and/or Commercial Applicants only upon receipt and approval by the Commissioner of Public Works of required plans and supplemental information.
- * In addition, a City-issued Industrial User Discharge Permit and/or a Sewer Extension/Connection Permit issued by the Commonwealth of Massachusetts D.E.P. shall be required by the City for Industrial Discharge into the sewer system.

Industrial User Discharge Permit No. N/A Date.

Comm. Mass. Sewer Conn./Ext. Permit No. N/A Date.

A Filing and Inspection Fee of \$150.00, plus an Entrance Fee of \$396.90 where applicable, must accompany this application.

Bank # Compass Bank Check # 482 Date: 6/10/02 Receipt # 4323

Other requirements: Inspection Only - Ream St. Sewer Proj. Stub = 27' x #14 70/14 =

\$396.90 plus \$150.00 Inspection Fee. Total = \$546.90

Owner/Contractor to contact Health Dept. Re: Abandoning Septic system.

Connection made to ☒ Sewer ☐ Storm Drain
 Part of jointly-shared private line ☐ Yes ☒ No

Applicant agrees to abide by the above terms, as well as all pertinent ordinances of the City of New Bedford, and such other special rules as the Commissioner of Public Works may deem necessary

Lawrence D. Norderlone
 Commissioner of Public Works

David W. Stringer
 Signature of Property Owner or Representative

INSPECTOR'S REPORT

INSPECTED BY:

DATE:

COMMENTS:

☐ APPROVED ☐ DISAPPROVED

SIGNATURE

SKETCH PLAN