

PERMIT NO.

23247



CITY OF NEW BEDFORD

DATE 7/19/02  
EXP 7/19/03

SEWER AND/OR STORM DRAIN PERMIT

This certifies that permission is granted to

Property Owner New Hinkley Castle 185 Adams Ave NB MA 02746 Address #1 Tel. (508) 399-6291

to connect a sewer and/or storm drain located at Cindy Ln. (W.S.) 50 (41-5) N. / Durfee St.  
Assessor's Plot 82, Lot 173, to the sewer and/or storm drain in Cindy Ln. Street  
(Buick's Lot 1)

to be laid in accordance with the conditions in this application and the City of New Bedford ordinances.

TYPE OF USE: ☒ RESIDENTIAL ☐ COMMERICAL ☐ INDUSTRIAL ☐ OTHER

330 GPD

If applicant other than actual property owner, attach Letter of Authorization from Property Owner.

Name N/A Tel. \_\_\_\_\_

Mailing Address \_\_\_\_\_

The Bonded Contractor/Drain Layer authorized to perform this work is:

Name Scott Franklin/ Franklin ENG. 4313 Adams Ave. NB MA 02745 Address (508) 399-8270 Tel. \_\_\_\_\_

Type of Pipe Required: PVC SDR 35

PERMIT EXPIRES ONE YEAR AFTER DATE OF ISSUE

- \* Requires separate connections for sewage and storm drain where applicable. Storm water cannot be discharged to a sanitary sewer.
- \* All work must be inspected and approved by a D.P.W. inspector before backfilling.
- \* If this connection is to be part of a private service shared jointly with other building owners, attach copy of Recorded Joint Maintenance Agreement.
- \* Permits can be issued to Industrial and/or Commercial Applicants only upon receipt and approval by the Commissioner of Public Works of required plans and supplemental information.
- \* In addition, a City-issued Industrial User Discharge Permit and/or a Sewer Extension/Connection Permit issued by the Commonwealth of Massachusetts D.E.P. shall be required by the City for Industrial Discharge into the sewer system.

Industrial User Discharge Permit No. \_\_\_\_\_ Date \_\_\_\_\_

Comm. Mass. Sewer Conn./Ext. Permit No. \_\_\_\_\_ Date \_\_\_\_\_

A Filing and Inspection Fee of \$ 150.00, plus an Entrance Fee of \$ \_\_\_\_\_ where applicable, must accompany this application.

Bank # Compass Bank Check # 3560 Date: 7/19/02 Receipt # 4366

Other requirements: Inspection Only - Rockdale Heights Subdivision - Per Planning Dept  
Kennedy Lots all shown except 3, 4, 5, 6. Stub at R.

Connection made to ☒ Sewer ☒ Storm Drain Part of jointly-shared private line ☐ Yes ☒ No

Applicant agrees to abide by the above terms, as well as all pertinent ordinances of the City of New Bedford, and such other special rules as the Commissioner of Public Works may deem necessary

Lawrence D. Williams  
Commissioner of Public Works

Joe S. Gualto  
Signature of Property Owner or Representative

INSPECTOR'S REPORT

INSPECTED BY: Pete Sieczka

DATE: 10-15-2002


COMMENTS: \_\_\_\_\_

\_\_\_\_\_

\_\_\_\_\_

☐ APPROVED ☐ DISAPPROVED

SIGNATURE

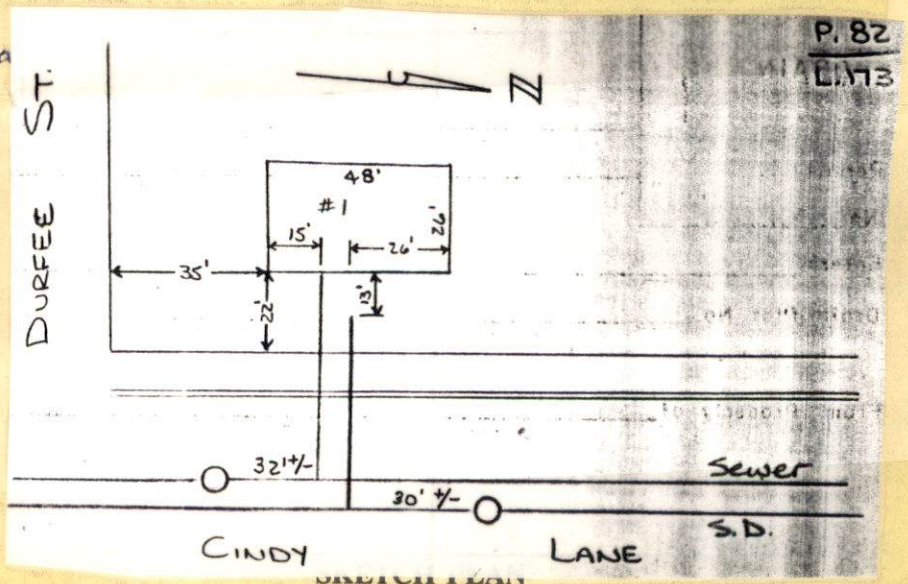



PERMIT NO.  
23247



CITY OF NEW BEDFORD  
SEWER AND/OR STORM DRAIN PERMIT

DATE 7/19/02  
EXP 7/19/03

This certifies that permission is granted to  
Nan Housky Castelo 1815 Acushnet Ave NB MA 02746  
Property Owner Address Tel. (508) 995-6291  
to connect a sewer and/or storm drain located at Cindy Ln. (WS.) 50 (41-1) N. / Durfee St.  
Assessor's Plot 82, Lot 173, to the sewer and/or storm drain in Cindy Ln. Street  
(Buckwheat Lot 1)  
to be laid in accordance with the conditions in this application and the City of New Bedford ordinances.

TYPE OF USE: ☒ RESIDENTIAL ☐ COMMERCIAL ☐ INDUSTRIAL ☐ OTHER 330 GRD

If applicant other than actual property owner, attach Letter of Authorization from Property Owner.  
Name N/A Tel. \_\_\_\_\_  
Mailing Address \_\_\_\_\_

The Bonded Contractor/Drain Layer authorized to perform this work is:  
Scott Franklin / Franklin Bros. 4393 Acushnet Ave NB MA 02745 (508) 998-8270  
Name Address Tel.

Type of Pipe Required: PVC SDR 35  
PERMIT EXPIRES ONE YEAR AFTER DATE OF ISSUE

- \* Requires separate connections for sewage and storm drain where applicable. Storm water cannot be discharged to a sanitary sewer.
- \* All work must be inspected and approved by a D.P.W. inspector before backfilling.
- \* If this connection is to be part of a private service shared jointly with other building owners, attach copy of Recorded Joint Maintenance Agreement.
- \* Permits can be issued to Industrial and/or Commercial Applicants only upon receipt and approval by the Commissioner of Public Works of required plans and supplemental information.
- \* In addition, a City-issued Industrial User Discharge Permit and/or a Sewer Extension/Connection Permit issued by the Commonwealth of Massachusetts D.E.P. shall be required by the City for Industrial Discharge into the sewer system.

Industrial User Discharge Permit No. \_\_\_\_\_ Date \_\_\_\_\_  
Comm. Mass. Sewer Conn./Ext. Permit No. \_\_\_\_\_ Date \_\_\_\_\_

A Filing and Inspection Fee of \$ 150.00, plus an Entrance Fee of \$ \_\_\_\_\_ where applicable, must accompany this application.

Bank # Compass Bank Check # 3560 Date: 7/19/02 Receipt # 4366


Other requirements: Inspection Only - Rockdale Heights Subdivision - Per Planning Dave Kennedy. Lots all reworked except 3, 4, 5, 6. Stub at R.

Connection made to ☒ Sewer ☒ Storm Drain  
Part of jointly-shared private line ☐ Yes ☒ No

Applicant agrees to abide by the above terms, as well as all pertinent ordinances of the City of New Bedford, and such other special rules as the Commissioner of Public Works may deem necessary  
Laurence D. Wozniak / one Commissioner of Public Works  
Joe S. Castelo Signature of Property Owner or Representative



INSPECTOR'S REPORT

INSPECTED BY: \_\_\_\_\_  
DATE: \_\_\_\_\_  
COMMENTS: \_\_\_\_\_  
\_\_\_\_\_  
\_\_\_\_\_  
\_\_\_\_\_  
☐ APPROVED ☐ DISAPPROVED

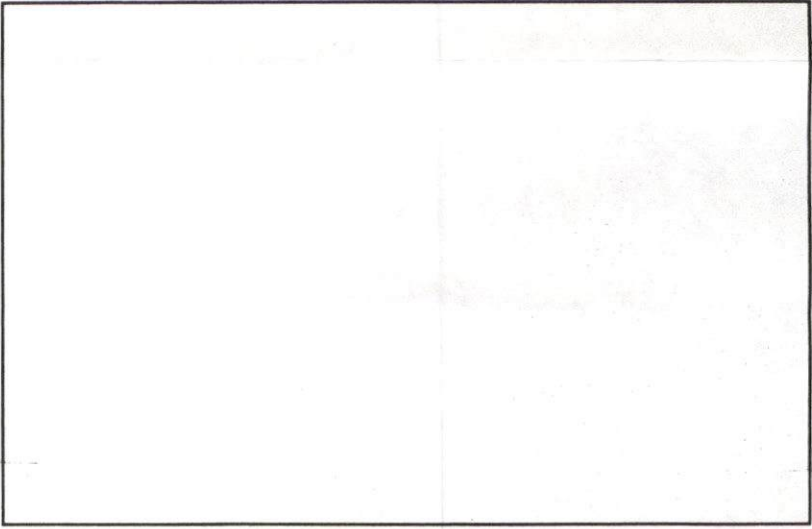

lot 1

7-17-02

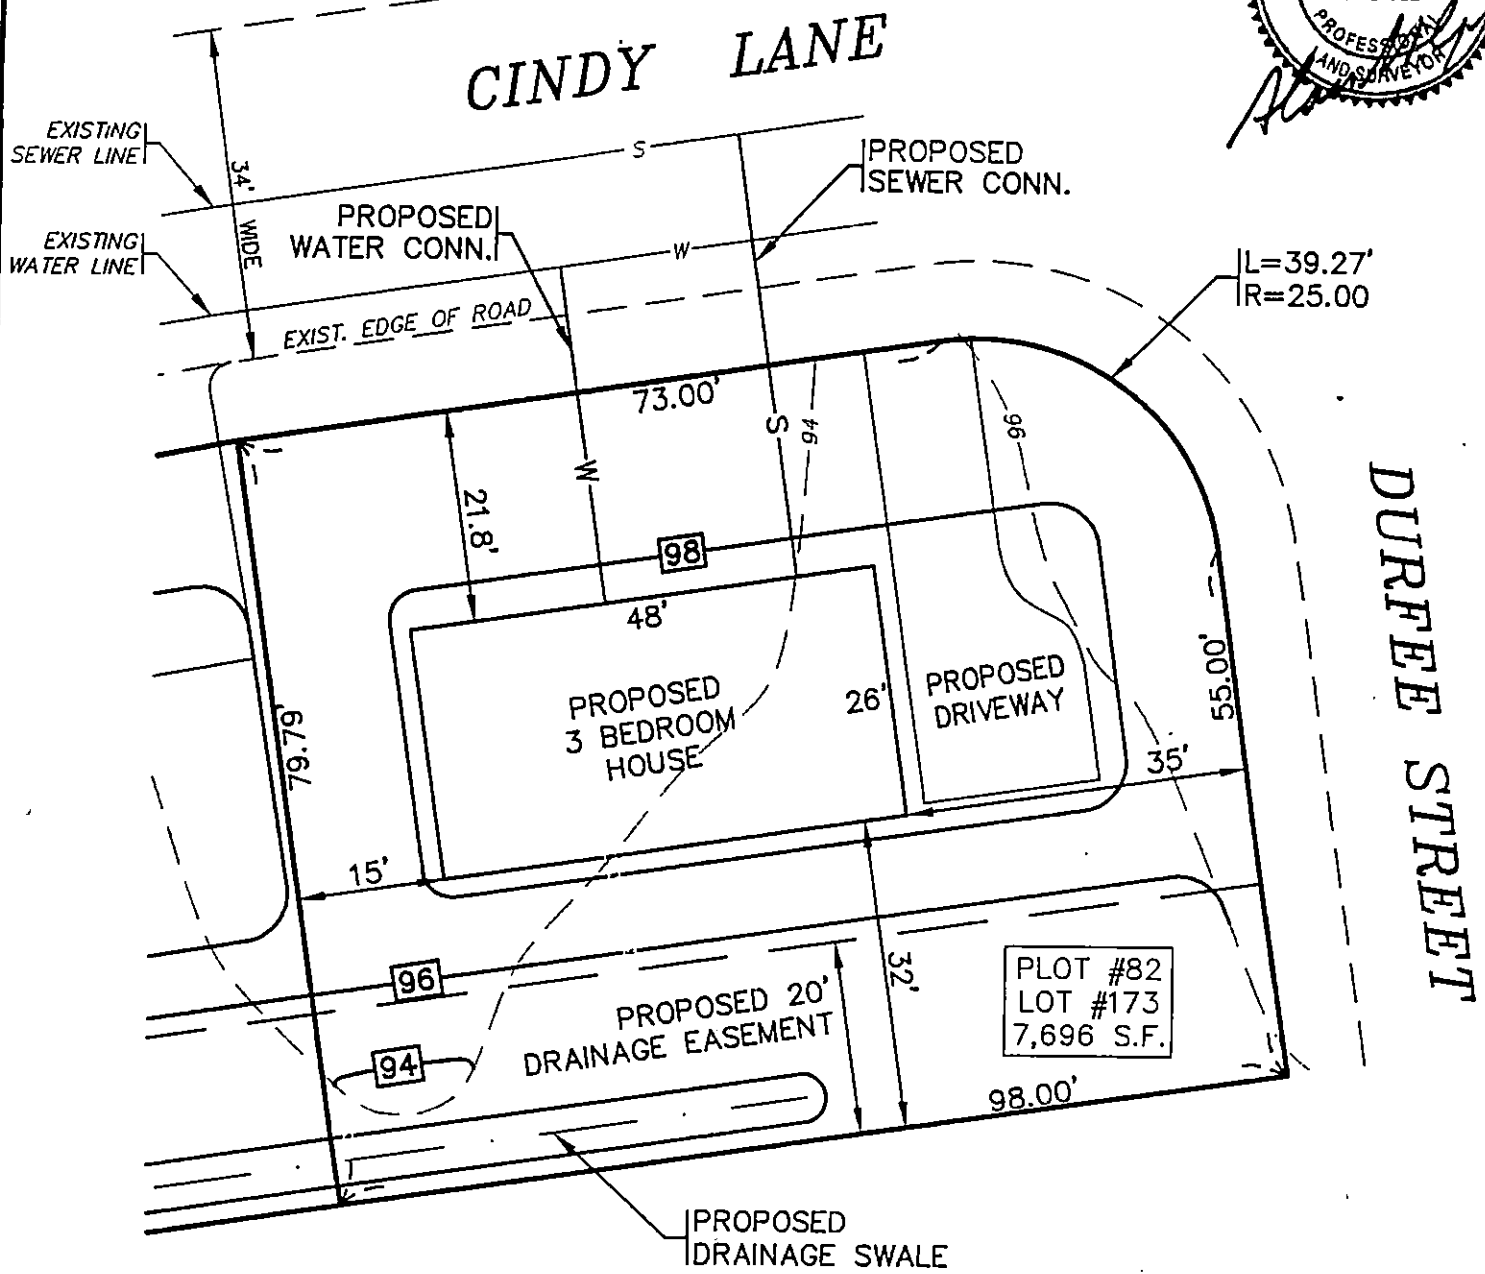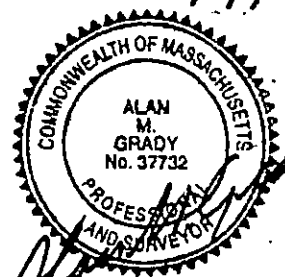

REFERENCE PLAN: "ROCKDALE HEIGHTS" DEFINITIVE SUBDIVISION OF LAND  
 PREPARED FOR ACUSHNET WESTPORT REALTY TRUST  
 DATED: DEC. 29, 1995. REVISED MAY 14, 1996 BY G.A.F. ENG., INC.



**PLOT PLAN TO ACCOMPANY  
 BUILDING PERMIT APPLICATION**  
 LOT 1, CINDY LANE NEW BEDFORD, MA  
 PREPARED FOR:  
**NEW HOMES BY CASTELO, INC.**

FILE LOCATION  
 :F:\02-5518\LOTS 1 & 2.dwg  
 DATE: JULY 16, 2002  
 DRAWN BY: J.J.K.  
 CHECKED BY: K.W.F.  
 JOB NO.: 02-5518  
 SCALE: 1" = 20'  
 DWG.: 1 OF 1

**G.A.F. ENGINEERING, INC.**  
 PROFESSIONAL ENGINEERS & LAND SURVEYORS  
 266 MAIN STREET, WAREHAM, MA 02571  
 TEL: (508) 295-6600 FAX: (508) 295-6634  
 E-MAIL: gaf.eng@verizon.net




0/15/02 - CINDY LANE - LOT #1 - FRANKLIN BRAS - PIPES PUT IN PREVIOUSLY


# 23247

DRAIN NO. \_\_\_\_\_ OWNER \_\_\_\_\_

- ① MEASURE FRONT OF HOUSE, DISTANCE TO LOT LINE.
- ② MEASURE FROM COR. OF HOUSE TO DRAIN, DISTANCE WHERE DRAIN CROSSES PROPERTY LINE, ENTERS SEWER.
- ③ LENGTH OF DRAIN FROM FRONT PROP. LINE TO HOUSE
- ④ SHOW NORTH ARROW.
- ⑤ MEASURE FROM DRAIN TO NEAREST INTERSECTION

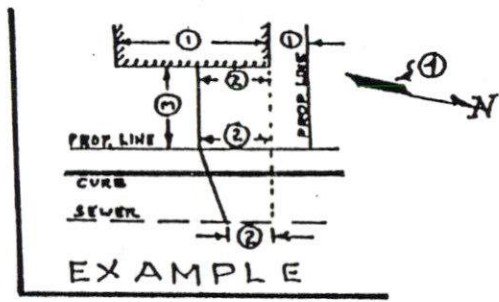

82/173

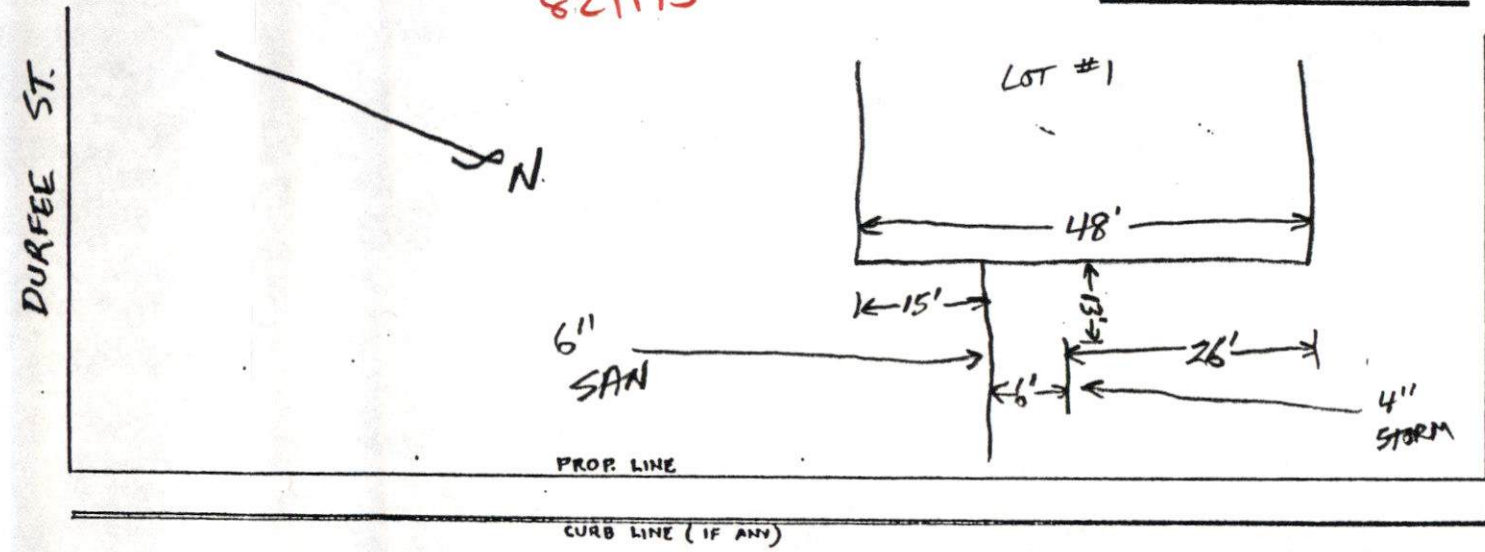

SEWER

CINDY LANE