

PERMIT NO.

23252



CITY OF NEW BEDFORD

DATE 8/18/02
EXP 7/18/03

SEWER AND/OR STORM DRAIN PERMIT

This certifies that permission is granted to

New Homes by Castelo 1815 Acushnet Ave NB MA 02746
Property Owner Address #14 Tel. (508) 995-6291
to connect a sewer and/or storm drain located at Cindy Ln. (E.S.) 130' (41) N. Durfee St.
Assessor's Plot 82, Lot 298 to the sewer and/or storm drain in Cindy Ln. Street
(Builder's lot 10)
to be laid in accordance with the conditions in this application and the City of New Bedford ordinances.

TYPE OF USE: ☒ RESIDENTIAL ☐ COMMERICAL ☐ INDUSTRIAL ☐ OTHER

If applicant other than actual property owner, attach Letter of Authorization from Property Owner.

Name N/A Tel.

Mailing Address

The Bonded Contractor/Drain Layer authorized to perform this work is:

Scott Franklin / Franklin Bros. 4313 Acushnet Ave. NB MA 02745 (508) 998-8270
Name Address Tel.

Type of Pipe Required: PVC SDR 35

PERMIT EXPIRES ONE YEAR AFTER DATE OF ISSUE

- * Requires separate connections for sewage and storm drain where applicable. Storm water cannot be discharged to a sanitary sewer.
- * All work must be inspected and approved by a D.P.W. inspector before backfilling.
- * If this connection is to be part of a private service shared jointly with other building owners, attach copy of Recorded Joint Maintenance Agreement.
- * Permits can be issued to Industrial and/or Commercial Applicants only upon receipt and approval by the Commissioner of Public Works of required plans and supplemental information.
- * In addition, a City-issued Industrial User Discharge Permit and/or a Sewer Extension/Connection Permit issued by the Commonwealth of Massachusetts D.E.P. shall be required by the City for Industrial Discharge into the sewer system.

Industrial User Discharge Permit No. Date

Comm. Mass. Sewer Conn./Ext. Permit No. Date

A Filing and Inspection Fee of \$ 150.00 plus an Entrance Fee of \$ where applicable, must accompany this application.

Bank # Compass Bank Check # 3660 Date: 8/20/02 Receipt # 4396

Other requirements: Inspector Only - Rockdale Heights Subdivision - Per Planning Dept
Kennedy Lots all vacant except 3, 4, 5, 6 (Bldg's lots). Stub at H.

Connection made to ☒ Sewer ☒ Storm Drain Part of jointly-shared private line ☐ Yes ☒ No

Applicant agrees to abide by the above terms, as well as all pertinent ordinances of the City of New Bedford, and such other special rules as the Commissioner of Public Works may deem necessary

Lawrence D. Walden
Commissioner of Public Works

Pete S. Sureska
Signature of Property Owner or Representative

INSPECTOR'S REPORT

INSPECTED BY: Pete Sureska

DATE: 10-15-02


COMMENTS:

10-15-02

Lawrence D. Walden

☐ APPROVED ☐ DISAPPROVED

SIGNATURE

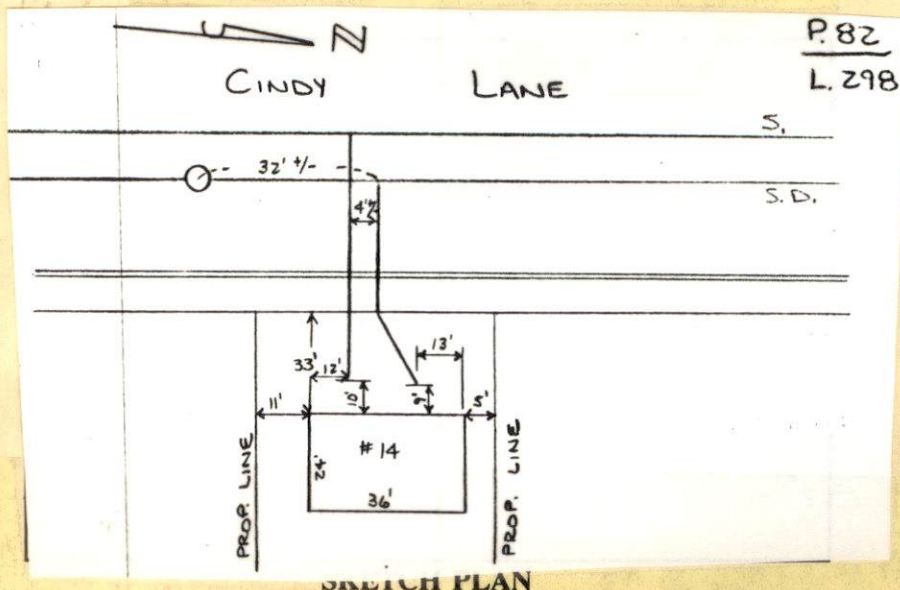

P. 82
L. 298

PERMIT NO.

23252



CITY OF NEW BEDFORD

SEWER AND/OR STORM DRAIN PERMIT

DATE 8/20/02
EXP 8/20/03

This certifies that permission is granted to

New Homes by Castelo 1815 Acushnet Ave NB MA 02746
Property Owner Address Tel. (508) 995-6291

to connect a sewer and/or storm drain located at Cindy Ln. (E.S.) 130 (41) N. 1 Durfee St.
Assessor's Plot 82, Lot 298 to the sewer and/or storm drain in Cindy Ln. Street
(Builder's lot 10)
to be laid in accordance with the conditions in this application and the City of New Bedford ordinances.

TYPE OF USE: ☒ RESIDENTIAL ☐ COMMERICAL ☐ INDUSTRIAL ☐ OTHER 3306PD

If applicant other than actual property owner, attach Letter of Authorization from Property Owner.

Name N/A Tel. _____

Mailing Address _____

The Bonded Contractor/Drain Layer authorized to perform this work is:

Scott Franklin / Franklin Bros. 4313 Acushnet Ave. NB MA 02745 (508) 998-8270
Name Address Tel.

Type of Pipe Required: PVC SDR 35

PERMIT EXPIRES ONE YEAR AFTER DATE OF ISSUE

* Requires separate connections for sewage and storm drain where applicable. Storm water cannot be discharged to a sanitary sewer.

* All work must be inspected and approved by a D.P.W. inspector before backfilling.

* If this connection is to be part of a private service shared jointly with other building owners, attach copy of Recorded Joint Maintenance Agreement.

* Permits can be issued to Industrial and/or Commercial Applicants only upon receipt and approval by the Commissioner of Public Works of required plans and supplemental information.

* In addition, a City-issued Industrial User Discharge Permit and/or a Sewer Extension/Connection Permit issued by the Commonwealth of Massachusetts D.E.P. shall be required by the City for Industrial Discharge into the sewer system.

Industrial User Discharge Permit No. _____ Date _____

Comm. Mass. Sewer Conn./Ext. Permit No. _____ Date _____

A Filing and Inspection Fee of \$ 150.00, plus an Entrance Fee of \$ _____ where applicable, must accompany this application.

Bank # Compass Bank Check # 3660 Date: 8/20/02 Receipt # 4396

Other requirements: Inspection Only - Rockdale Heights Subdivision - Per Planning Dave Kennedy. Lots all released except 3, 4, 5, 6 (Bldr's lots). Stub at R.

Connection made to ☒ Sewer Part of jointly-shared private line ☐ Yes ☒ No
☒ Storm Drain

Applicant agrees to abide by the above terms, as well as all pertinent ordinances of the City of New Bedford, and such other special rules as the Commissioner of Public Works may deem necessary

Lawrence D. Woodman
Commissioner of Public Works

Joe S. Castelo
Signature of Property Owner or Representative

INSPECTOR'S REPORT

INSPECTED BY: _____

DATE: _____


COMMENTS: _____

☐ APPROVED

☐ DISAPPROVED

SIGNATURE

SKETCH PLAN

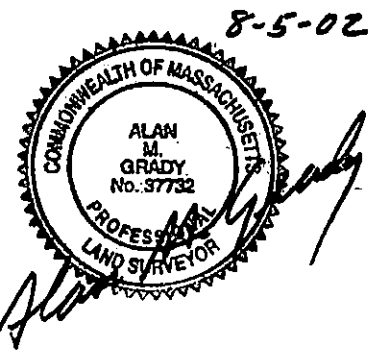

E-MAIL: gaf.eng@verizon.net

10/15/02 — CINDY LANE — LOT #10 — FRANKLIN BROS. #23252

DRAIN NO. — — — — — OWNER — — — — —

- ① MEASURE FRONT OF HOUSE, DISTANCE TO LOT LINE.
- ② MEASURE FROM COR. OF HOUSE TO DRAIN, DISTANCE WHERE DRAIN CROSSES PROPERTY LINE, ENTERS SEWER.
- ③ LENGTH OF DRAIN FROM FRONT PROP. LINE TO HOUSE
- ④ SHOW NORTH ARROW.
- ⑤ MEASURE FROM DRAIN TO NEAREST INTERSECTION

