

DATE.....7-22-02.....

SEWER AND/OR STORM DRAIN PERMIT



This certifies that permission is granted to  
NASHAWENA MILLS CORP (DAVID DESOZA) 620 BELLVILLE AVE N.B. MI. 02746 (508) 996-4723

Address

Tel.

RECEIVED

to connect a sewer and/or storm drain located at 620 BELLVILLE AVE

Assessor's Plot 111, Lot 98, to the sewer and/or storm drain in BELLVILLE AVE

to be laid in accordance with the conditions in this application and the City of New Bedford ordinances. NEW BEDFORD, MASS.

TYPE OF USE: ☐ RESIDENTIAL ☒ COMMERCIAL ☐ INDUSTRIAL ☐ OTHER

If applicant other than actual property owner, attach Letter of Authorization from Property Owner.

Name DAVE DE SOUZA

Tel. (508) 996-4123

Mailing Address.....620 DELLVILLE AVE.

The Bonded Contractor/Drain Layer authorized to perform this work is:

T S LUIZ 12 VENTURA AUG D. DARTMOUTH MA

(506) 995-3535

Name \_\_\_\_\_

Address

Tel

Type of Pipe Required:.....PVC.....SDR 35.....

**PERMIT EXPIRES ONE YEAR AFTER DATE OF ISSUE**

- \* Requires separate connections for sewage and storm drain where applicable. Storm water cannot be discharged to a sanitary sewer.
- \* All work must be inspected and approved by a D.P.W. inspector before backfilling.
- \* If this connection is to be part of a private service shared jointly with other building owners, attach copy of Recorded Joint Maintenance Agreement.
- \* Permits can be issued to Industrial and/or Commercial Applicants only upon receipt and approval by the Commissioner of Public Works of required plans and supplemental information.
- \* In addition, a City-issued Industrial User Discharge Permit and/or a Sewer Extension/Connection Permit issued by the Commonwealth of Massachusetts D.E.P. shall be required by the City for Industrial Discharge into the sewer system.

Industrial User Discharge Permit No. N/A PER V.F. (A13) Date \_\_\_\_\_

Comm. Mass. Sewer Conn./Ext. Permit No. 2/A ..... Date.....

A Filing and Inspection Fee of \$150.00, plus an Entrance Fee of \$       where applicable, must accompany this application.

Bank # FLEET Check # 2706 Date: 7-22-02 Receipt # 4368

Other requirements: INSPECTION ONLY per DoD Sec 5304.10, Reproduction to mail

US Signal permission slip.

☒ Sewer

Connection made to

Part of jointly-shared private line ☐ Yes ☒ No☐ Storm Drain

Applicant agrees to abide by the above terms, as well as all pertinent ordinances of the City of New Bedford, and such other special rules as the Commissioner of Public Works may deem necessary

*Lawrence D. Woodward*  
.....  
**Commissioner of Public Works**

**Signature of Property Owner or Representative**

## INSPECTOR'S REPORT

INSPECTED BY: JOSEPH MARTIN


DATE: 10/25/02

**COMMENTS:**

☒ APPROVED

☐ DISAPPROVED

SIGNATURE

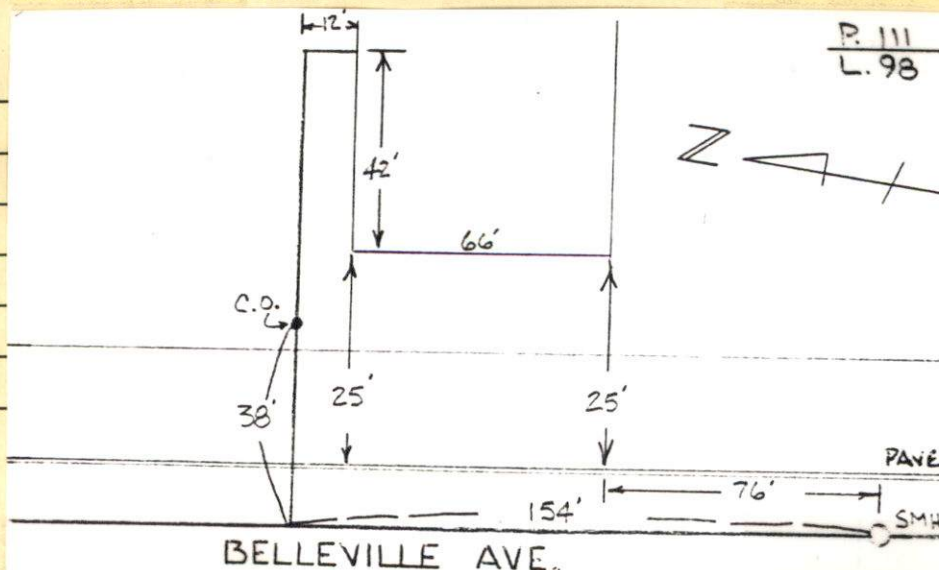

### SKETCH PLAN



PERMIT NO.

23254



CITY OF NEW BEDFORD

DATE...7-22-02

SEWER AND/OR STORM DRAIN PERMIT

This certifies that permission is granted to  
NASHAWENA MILLS CORP (DAVID DE SOUZA) 620 BELLVILLE AVE N.B. MA. 02746 (508) 996-4723  
Property Owner Address Tel.

to connect a sewer and/or storm drain located at 620 BELLVILLE AVE  
Assessor's Plot...111..., Lot...98..., to the sewer and/or storm drain in...BELLVILLE AVE Street  
to be laid in accordance with the conditions in this application and the City of New Bedford ordinances.

TYPE OF USE: ☐ RESIDENTIAL ☒ COMMERCIAL ☐ INDUSTRIAL ☐ OTHER

If applicant other than actual property owner, attach Letter of Authorization from Property Owner.

Name...DAVE DE SOUZA Tel... (508) 996-4723

Mailing Address...620 BELLVILLE AVE

The Bonded Contractor/Drain Layer authorized to perform this work is:

J S LUZ 12 VENTURA AVE N. DARTMOUTH MA (508) 995-3535  
Name Address Tel.

Type of Pipe Required: PVC SDR 35

PERMIT EXPIRES ONE YEAR AFTER DATE OF ISSUE

- \* Requires separate connections for sewage and storm drain where applicable. Storm water cannot be discharged to a sanitary sewer.
- \* All work must be inspected and approved by a D.P.W. inspector before backfilling.
- \* If this connection is to be part of a private service shared jointly with other building owners, attach copy of Recorded Joint Maintenance Agreement.
- \* Permits can be issued to Industrial and/or Commercial Applicants only upon receipt and approval by the Commissioner of Public Works of required plans and supplemental information.
- \* In addition, a City-issued Industrial User Discharge Permit and/or a Sewer Extension/Connection Permit issued by the Commonwealth of Massachusetts D.E.P. shall be required by the City for Industrial Discharge into the sewer system.

Industrial User Discharge Permit No...N/A PER V.F. (BIS) Date...

Comm. Mass. Sewer Conn./Ext. Permit No...N/A Date...

A Filing and Inspection Fee of \$150.00, plus an Entrance Fee of \$... where applicable, must accompany this application.

Bank # FLEET Check # 2706 Date: 7-22-02 Receipt # 4368

Other requirements: INSPECTION ONLY Per Duarte Andrade, Representative to mail  
U.S. Sigold, permission slip

☒ Sewer

Connection made to Part of jointly-shared private line ☐ Yes ☒ No  
☐ Storm Drain

Applicant agrees to abide by the above terms, as well as all pertinent ordinances of the City of New Bedford, and such other special rules as the Commissioner of Public Works may deem necessary

Lawrence D. Worden  
Commissioner of Public Works

Signature of Property Owner or Representative

INSPECTOR'S REPORT

INSPECTED BY: \_\_\_\_\_

DATE: \_\_\_\_\_

COMMENTS: \_\_\_\_\_  
\_\_\_\_\_  
\_\_\_\_\_  
\_\_\_\_\_

☐ APPROVED ☐ DISAPPROVED


SIGNATURE

SKETCH PLAN

# Computation Sheet

Subject SEWER CONNECTION  
620 BELLVILLE AVE

Page \_\_\_\_\_ of \_\_\_\_\_  
Made by \_\_\_\_\_  
Date \_\_\_\_\_  
Checked by \_\_\_\_\_  
Date \_\_\_\_\_

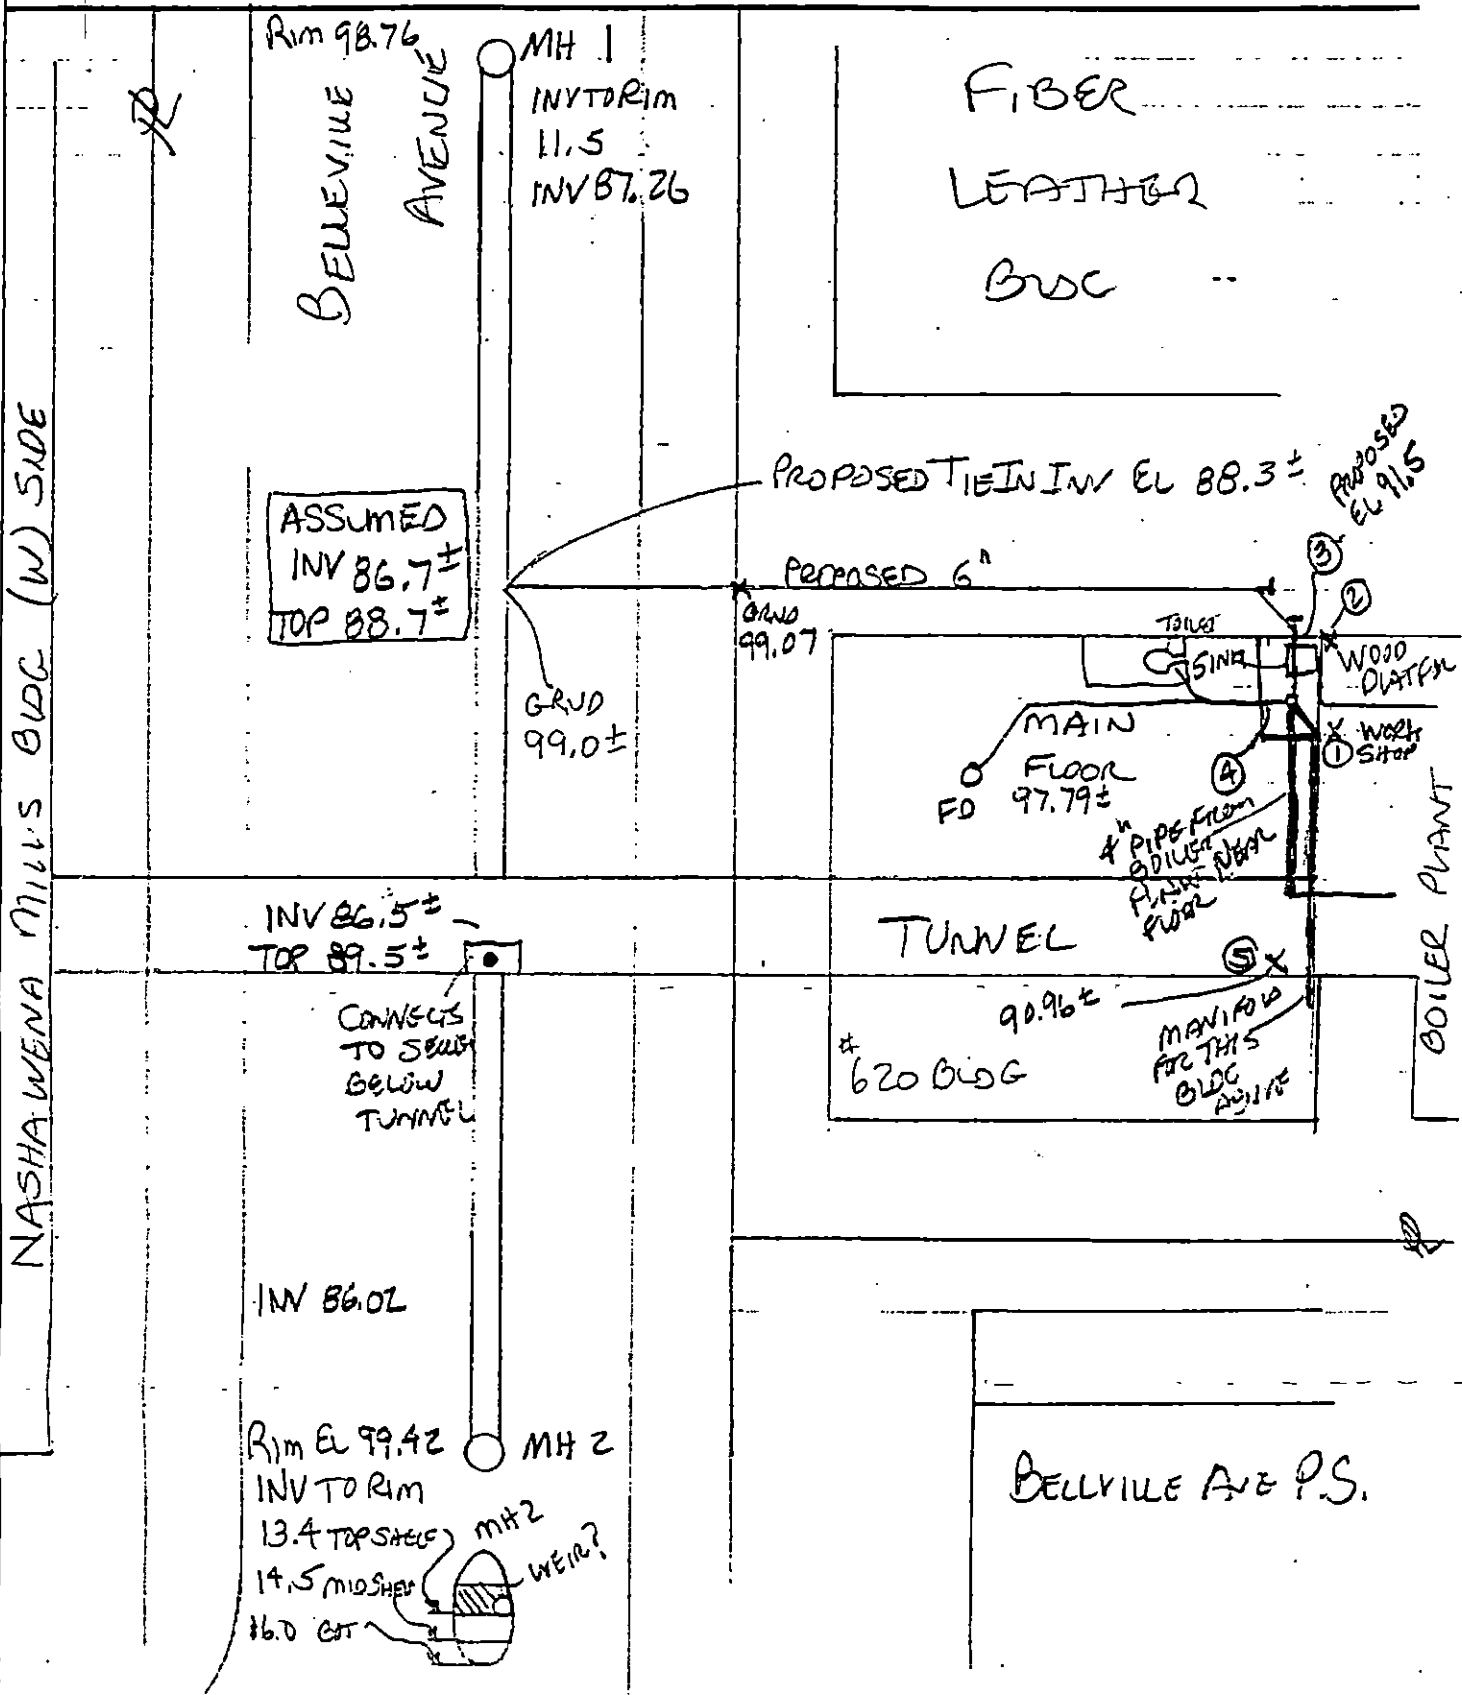

# Computation Sheet

Subject SEWER CONNECTION  
620 BELLEVILLE AVE

Page \_\_\_\_\_ of \_\_\_\_\_  
 Made by \_\_\_\_\_  
 Date \_\_\_\_\_  
 Checked by \_\_\_\_\_  
 Date \_\_\_\_\_

## ELEVATION INFO

- ① FLOOR @ (NW) CORN OF BACK SHOP 7'4" BELOW PLATFORM ELEVATION ② EL 92.45
- ② MAIN FLOOR OF BLOC NEAR BATHROOM 2 BRICK ABOVE GRAN FND OUTSIDE OF BATHROOM ③ EL 97.29 + .5 = 97.79 ±
- ③ PROPOSED INVERT FOR SEWER SERVICE AT BATHROOM (NOT SURE OF DEPTH OR DIRECTION OF EFFLUENT SEWER 91.5 ±
- ④ DEPTH OF PIT 5'-4" FROM FLOOR, TWO PIPE @ (W) WALL OF PIT FROM TOILET & FLOOR DRAIN 1 @ 13.5" INVERT TO FLOOR & 2 @ 20" ± INVERT TO FLOOR (NOT POSITIVE WHICH IS TOILET & FLOOR DRAIN)  
 BOTTOM OF PIT ELEV 92.46
- ⑤ TUNNEL FLOOR 82" BELOW MAIN FLOOR EL 90.96' ±

ELEV.

LEVEL SURVEY 3/30/02 BM @ TOP OF BOTTOM STEP (S) SIDE

+ 3.29	TOP OF BOTTOM FRONT STEP SOUTH SIDE	HI = 103.29	
- 4.67	TOP OF WOOD PLATFORM		98.62
- 6.00	TOP OF GRANITE FND @ CORN OF BLOC (BATHROOM) ③	ROD = 6.75 (- .75)	97.29
- 3.46	TOP OF CI PIPE THROUGH WALL (ROOF DRAIN)	(- 3.29)	99.83
- 5.09	TOP OF THRESHOLD @ DOOR ENTRY NEAR BATHROOM	ROD = 5.06 (- .77)	98.20
+ 3.24	BM HI = 103.24		
- 4.38	TOP OF GRANITE BND SW CORN FIBERLEATHER (BM)		98.86
- 4.48	Rim @ SMH-1		98.76
+ 3.68	BM HI = 103.68		
- 4.26	Rim @ SMH-2		99.42
- 1.83	NW CORN FLAG POLE FND (BM)		101.85
- 4.61	BACK OF WALK @ PROPOSED SEWER SERVICE		99.07

MTG W/ DAVE DE SOUSA 3/9/02  
 MEASUREMENTS MADE 3/16/02 & 3/30/02

J.S. Luiz 12-Ventura Dr. N. Dartmouth, Ma.





**CITY OF NEW BEDFORD  
MASSACHUSETTS**

DEPARTMENT OF PUBLIC WORKS  
ENGINEERING DIVISION  
133 WILLIAM STREET, ROOM 303  
NEW BEDFORD, MA 02740  
Tel: (508) 979-1527  
Fax: (508) 961-3043

To Whom It May Concern:

I, ANTHONY R. SAPIENZA, being  
(Name) (Mailing Address)

VICE PRESIDENT NASHAWENA HILLS  
Owner of property located at 620 BELLEVILLE AVE, NEW BEDFORD

Plot 111, Lot 98, hereby agree to allow \_\_\_\_\_  
(Name)

\_\_\_\_\_ to act on my behalf including affixing my  
(Mailing Address)

signature in securing permit for:

X Sewer/Drain Service Permits  
\_\_\_\_\_ Water Service Permits  
\_\_\_\_\_ Driveway Installation Permits  
\_\_\_\_\_ Sidewalk Installation Permits

I further agree to conform to, and abide by, all City rules and ask regulations applicable to the permit (s) being applied for:

Name *Anthony R. Sapienza*  
(Signature)

620 BELLEVILLE AVE, N.B.  
(Address)

7/22/02 508 999-1301  
(Date) (Telephone number)

PERMIT # 23254