

PERMIT NO.

23257



CITY OF NEW BEDFORD

DATE..... 7-23-02

SEWER AND/OR STORM DRAIN PERMIT

This certifies that permission is granted to

PATRICIA EZYK 74 SEABURY ST. NEW BEDFORD MA. 02745 (508) 995 5970  
 Property Owner Address Tel.

to connect a sewer and/or storm drain located at SEABURY ST (113) 70' ± S/ CARLISLE ST.

Assessor's Plot 113, Lot 230, to the sewer and/or storm drain in SEABURY Street

to be laid in accordance with the conditions in this application and the City of New Bedford ordinances.

TYPE OF USE: ☒ RESIDENTIAL ☐ COMMERICAL ☐ INDUSTRIAL ☐ OTHER

If applicant other than actual property owner, attach Letter of Authorization from Property Owner.

Name RICHARD BAILEY / R. Bailey Construction Co. Tel. (508) 990-8726

Mailing Address 568 LANTERN LN.

The Bonded Contractor/Drain Layer authorized to perform this work is:

REIS ASPHALT 476 HIXVILLE RD U. DARTMOUTH MA. 02747 (508) 996-0735  
 Name Address Tel.

Type of Pipe Required: PVC SDR 35

PERMIT EXPIRES ONE YEAR AFTER DATE OF ISSUE

\* Requires separate connections for sewage and storm drain where applicable. Storm water cannot be discharged to a sanitary sewer.

\* All work must be inspected and approved by a D.P.W. inspector before backfilling.

\* If this connection is to be part of a private service shared jointly with other building owners, attach copy of Recorded Joint Maintenance Agreement.

\* Permits can be issued to Industrial and/or Commercial Applicants only upon receipt and approval by the Commissioner of Public Works of required plans and supplemental information.

\* In addition, a City-issued Industrial User Discharge Permit and/or a Sewer Extension/Connection Permit issued by the Commonwealth of Massachusetts D.E.P. shall be required by the City for Industrial Discharge into the sewer system.

Industrial User Discharge Permit No. N/A Date.

Comm. Mass. Sewer Conn./Ext. Permit No. N/A Date.

A Filing and Inspection Fee of \$150.00, plus an Entrance Fee of \$..... where applicable, must accompany this application.

Bank # FIRST FED Check # 1101 Date: 7-23-02 Receipt # 4372

Other requirements: INSPECTION ONLY - Connecting to 8" sewer and 8" storm drain in Seabury St.

☒ Sewer

Connection made to Part of jointly-shared private line ☐ Yes ☒ No

☒ Storm Drain

Applicant agrees to abide by the above terms, as well as all pertinent ordinances of the City of New Bedford, and such other special rules as the Commissioner of Public Works may deem necessary

Commissioner of Public Works

Signature of Property Owner or Representative

INSPECTOR'S REPORT

INSPECTED BY: Pete Sieczka

DATE: 9/25/02


COMMENTS:

Also Void Permit # 23688 EXPIRED

☐ APPROVED

☐ DISAPPROVED

SIGNATURE

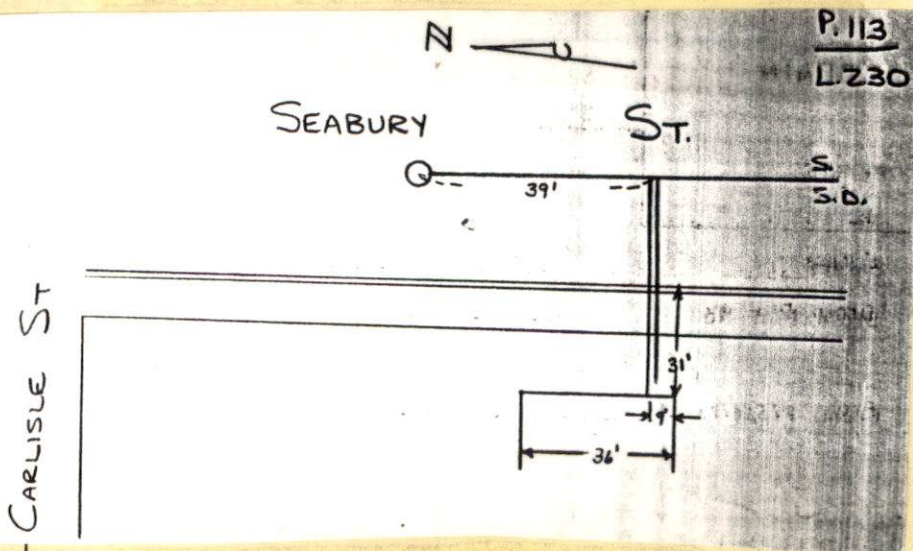

SKETCH PLAN

PERMIT NO.

23257



CITY OF NEW BEDFORD

DATE 7-23-02

SEWER AND/OR STORM DRAIN PERMIT

This certifies that permission is granted to

PATRICIA EZYK 74 SEABURY ST. NEW BEDFORD MA. 02745 (508) 995 5970  
Property Owner Address Tel.

to connect a sewer and/or storm drain located at SEABURY ST (WS) 170' ± S / CARLISLE ST.  
Assessor's Plot 113, Lot 230, to the sewer and/or storm drain in SEABURY Street  
to be laid in accordance with the conditions in this application and the City of New Bedford ordinances.

TYPE OF USE: ☒ RESIDENTIAL ☐ COMMERICAL ☐ INDUSTRIAL ☐ OTHER

If applicant other than actual property owner, attach Letter of Authorization from Property Owner.

Name RICHARD BAILEY / Westford Construction Co. Tel. (508) 990-8726  
Mailing Address 568 LANTERN LN.

The Bonded Contractor/Drain Layer authorized to perform this work is:

REIS ASPHALT 476 HIXVILLE RD U. DARTMOUTH MA. 02747 (508) 996-0735  
Name Address Tel.

Type of Pipe Required: PVC SDR 35

PERMIT EXPIRES ONE YEAR AFTER DATE OF ISSUE

- \* Requires separate connections for sewage and storm drain where applicable. Storm water cannot be discharged to a sanitary sewer.
- \* All work must be inspected and approved by a D.P.W. inspector before backfilling.
- \* If this connection is to be part of a private service shared jointly with other building owners, attach copy of Recorded Joint Maintenance Agreement.
- \* Permits can be issued to Industrial and/or Commercial Applicants only upon receipt and approval by the Commissioner of Public Works of required plans and supplemental information.
- \* In addition, a City-issued Industrial User Discharge Permit and/or a Sewer Extension/Connection Permit issued by the Commonwealth of Massachusetts D.E.P. shall be required by the City for Industrial Discharge into the sewer system.

Industrial User Discharge Permit No. N/A Date.  
Comm. Mass. Sewer Conn./Ext. Permit No. N/A Date.

A Filing and Inspection Fee of \$150.00, plus an Entrance Fee of \$..... where applicable, must accompany this application.

Bank # FIRST FED Check # 1101 Date: 7-23-02 Receipt # 4372

Other requirements: INSPECTION ONLY - Connecting to 8" sewer and 8" storm drain in SEABURY ST.

☒ Sewer

Connection made to Part of jointly-shared private line ☐ Yes ☒ No

☒ Storm Drain

Applicant agrees to abide by the above terms, as well as all pertinent ordinances of the City of New Bedford, and such other special rules as the Commissioner of Public Works may deem necessary

Lawrence D. Woudenberg  
Commissioner of Public Works

Richard F. Bailey  
Signature of Property Owner or Representative

INSPECTOR'S REPORT

INSPECTED BY: \_\_\_\_\_

DATE: \_\_\_\_\_

COMMENTS: \_\_\_\_\_  
\_\_\_\_\_  
\_\_\_\_\_  
\_\_\_\_\_

☐ APPROVED

☐ DISAPPROVED

SIGNATURE

SKETCH PLAN



CITY OF NEW BEDFORD  
MASSACHUSETTS

DEPT. OF PUBLIC WORKS

133 WILLIAM STREET

LAWRENCE D. WORDEN  
COMMISSIONER

To Whom It May Concern:

I, PATRICIA EZYK, being  
Name (Print) Mailing Address

owner of property located at LOT 11 SEABURY ST.

Plot \_\_\_\_\_, Lot 11, hereby agree to allow RICHARD BAILEY  
Name

368 LANTERN LANE, NEW BEDFORD, MA. 02745 to act on my behalf,  
Mailing Address

including affixing my signature, in securing permits for:

<u>X</u>	Sewer/Drain Service Permits
<u>X</u>	Water Service Permits
<u>X</u>	Driveway Installation Permits
<u>X</u>	Sidewalk Installation Permits

I further agree to conform to, and abide by, all City rules and regulations applicable to the permits(s) being applied for.

Name

X Patricia B. Ezyk  
(signature)

74 SEABURY ST.  
NEW BEDFORD, MA. 02745

Address

5/8/02

Date

9/25/02 — REIS ASPHALT — SEABURY ST. — 173' ± S OF S PROP OF CARLISLE ST. — WEST SIDE  
STORM + SANITARY

DRAIN NO. 23257 OWNER \_\_\_\_\_

- ① MEASURE FRONT OF HOUSE, DISTANCE TO LOT LINE.
- ② MEASURE FROM COR. OF HOUSE TO DRAIN, DISTANCE WHERE DRAIN CROSSES PROPERTY LINE, ENTERS SEWER.
- ③ LENGTH OF DRAIN FROM FRONT PROP. LINE TO HOUSE
- ④ SHOW NORTH ARROW.
- ⑤ MEASURE FROM DRAIN TO NEAREST INTERSECTION

P. 113  
L-230

