

PERMIT # 23270 MISSING

1043 RHONDA DR


ISSUED TO: CRANLOR CO.

BERNARD BOLANGER


ISSUED DATE 8-16-2002

COMPLETED DATE 8-30-2002


LOCATION: RHONDA DR. 200'± N x TERRY LANE
PLOT 130D / LOT 373

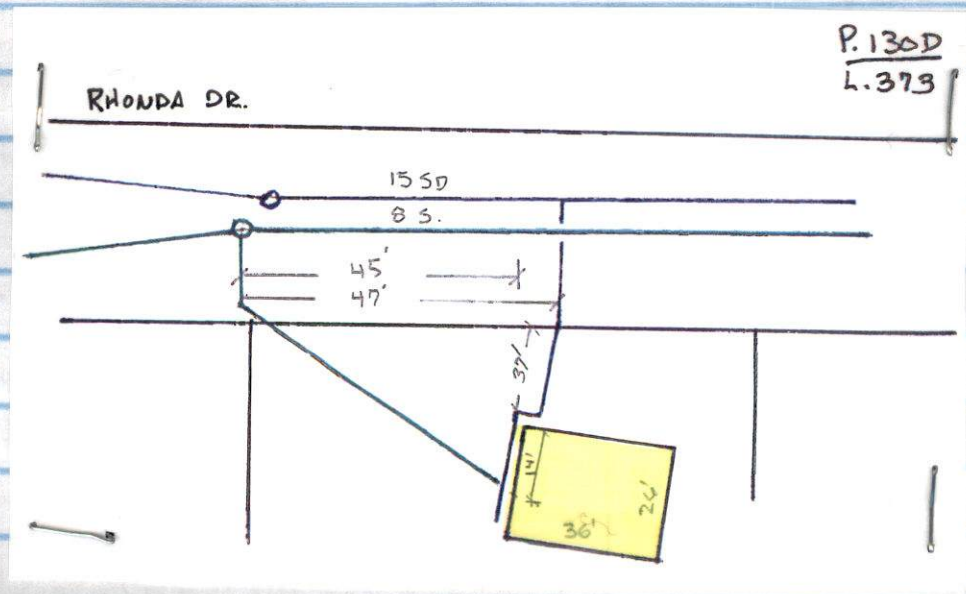


3 GERALDINE ST.
8/29/02
23272

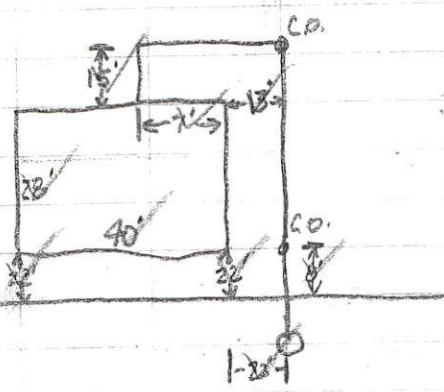

NAFFER ST
10/8/02

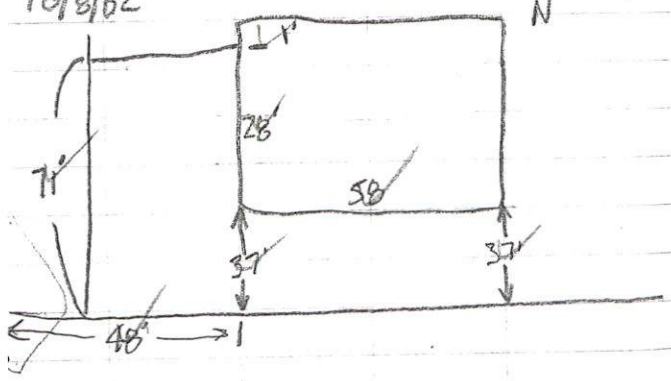

RHONDA DR.
8/30/02
23270

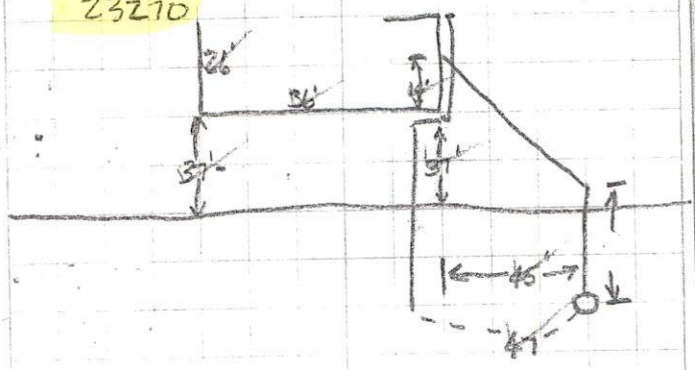

EASTLAND FARMS
LOT 13

