

PERMIT NO.

23275



CITY OF NEW BEDFORD

SEWER AND/OR STORM DRAIN PERMIT

DATE 8-30-02
RECEIVED

SEP 17 2002

DEPT. OF PUBLIC WORKS
NEW BEDFORD, MASS.

This certifies that permission is granted to

OLIVERIO FERREIRA 1578 ACUSHNET AVE N.B. MA
Property Owner Address #203 Phillips Ave. (N.S.) 35' (+/-) (508) Tel. 997-3319
E. Acushnet Ave.

to connect a sewer and/or storm drain located at ACUSHNET AVE + PHILLIPS AVE (NEC)
Assessor's Plot 104, Lot 62, to the sewer and/or storm drain in PHILLIPS AVE Street

to be laid in accordance with the conditions in this application and the City of New Bedford ordinances.

TYPE OF USE: ☐ RESIDENTIAL ☒ COMMERCIAL ☐ INDUSTRIAL ☐ OTHER

330 6PD

If applicant other than actual property owner, attach Letter of Authorization from Property Owner.

Name..... Tel.....

Mailing Address.....

The Bonded Contractor/Drain Layer authorized to perform this work is:

R.F. CANNESSA
Name Address Tel.

Type of Pipe Required: PK SDR 35

PERMIT EXPIRES ONE YEAR AFTER DATE OF ISSUE

- * Requires separate connections for sewage and storm drain where applicable. Storm water cannot be discharged to a sanitary sewer.
- * All work must be inspected and approved by a D.P.W. inspector before backfilling.
- * If this connection is to be part of a private service shared jointly with other building owners, attach copy of Recorded Joint Maintenance Agreement.
- * Permits can be issued to Industrial and/or Commercial Applicants only upon receipt and approval by the Commissioner of Public Works of required plans and supplemental information.
- * In addition, a City-issued Industrial User Discharge Permit and/or a Sewer Extension/Connection Permit issued by the Commonwealth of Massachusetts D.E.P. shall be required by the City for Industrial Discharge into the sewer system.

Industrial User Discharge Permit No. N/A Date.....

Comm. Mass. Sewer Conn./Ext. Permit No. N/A Date.....

A Filing and Inspection Fee of \$150.00, plus an Entrance Fee of \$..... where applicable, must accompany this application.

Bank # CASH Check # N/A Date: 8-30-02 Receipt # 357

Other requirements: INSPECTION ONLY

MUST MEET SITE PLAN REVIEW REQUIREMENTS

☒ Sewer
Connection made to Part of jointly-shared private line ☐ Yes ☒ No
☒ Storm Drain

Applicant agrees to abide by the above terms, as well as all pertinent ordinances of the City of New Bedford, and such other special rules as the Commissioner of Public Works may deem necessary

Commissioner of Public Works

Signature of Property Owner or Representative

INSPECTOR'S REPORT


INSPECTED BY: KEVIN CORNELL

DATE: 9/6/02

COMMENTS: Connected to old
sewer service connection.

☒ APPROVED ☐ DISAPPROVED

Signature

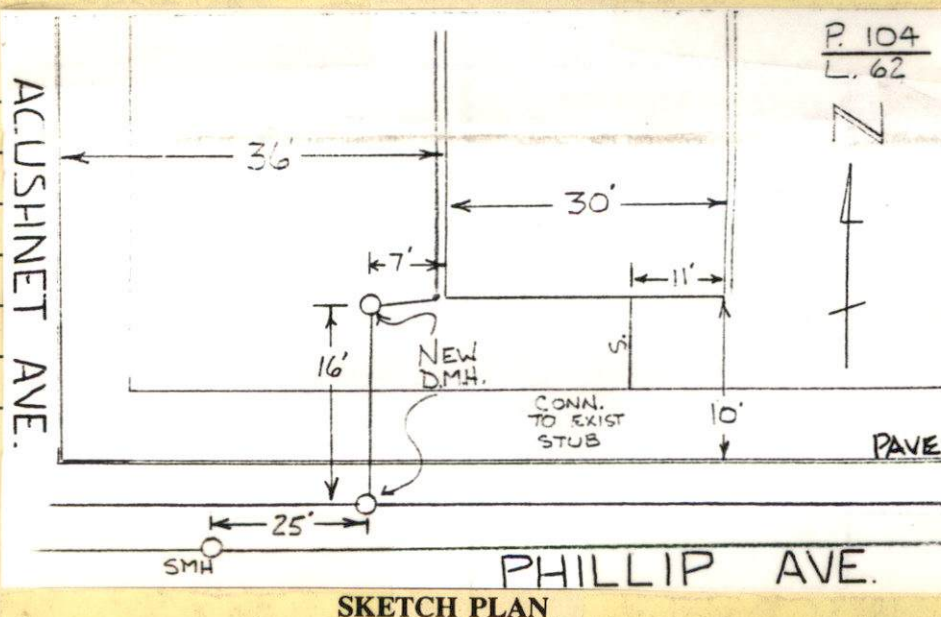

PERMIT NO.

23275



CITY OF NEW BEDFORD

DATE 8-30-02

SEWER AND/OR STORM DRAIN PERMIT

This certifies that permission is granted to

OLIVERIO FERREIRA 1528 ACUSHNET AVE N.B. MA. 02746
Property Owner Address (508) Tel. 997-3319

to connect a sewer and/or storm drain located at ACUSHNET AVE + PHILLIPS AVE (NEC)
Assessor's Plot 104, Lot 62, to the sewer and/or storm drain in PHILLIPS AVE Street

to be laid in accordance with the conditions in this application and the City of New Bedford ordinances.

TYPE OF USE: ☐ RESIDENTIAL ☒ COMMERCIAL ☐ INDUSTRIAL ☐ OTHER

330 GPD

If applicant other than actual property owner, attach Letter of Authorization from Property Owner.

Name Tel.

Mailing Address

The Bonded Contractor/Drain Layer authorized to perform this work is:

R E CANNESSA

Name

Address

Tel.

Type of Pipe Required: PVC SDR 35

PERMIT EXPIRES ONE YEAR AFTER DATE OF ISSUE

* Requires separate connections for sewage and storm drain where applicable. Storm water cannot be discharged to a sanitary sewer.

* All work must be inspected and approved by a D.P.W. inspector before backfilling.

* If this connection is to be part of a private service shared jointly with other building owners, attach copy of Recorded Joint Maintenance Agreement.

* Permits can be issued to Industrial and/or Commercial Applicants only upon receipt and approval by the Commissioner of Public Works of required plans and supplemental information.

* In addition, a City-issued Industrial User Discharge Permit and/or a Sewer Extension/Connection Permit issued by the Commonwealth of Massachusetts D.E.P. shall be required by the City for Industrial Discharge into the sewer system.

Industrial User Discharge Permit No. N/A Date

Comm. Mass. Sewer Conn./Ext. Permit No. N/A Date

A Filing and Inspection Fee of \$150.00, plus an Entrance Fee of \$ where applicable, must accompany this application.

Bank # CASH Check # N/A Date: 8-30-02 Receipt # 357

Other requirements: INSPECTION ONLY

MUST MEE SITE PLAN REVIEW REQUIREMENTS

☒ Sewer

Connection made to

Part of jointly-shared private line ☐ Yes ☒ No

☒ Storm Drain

Applicant agrees to abide by the above terms, as well as all pertinent ordinances of the City of New Bedford, and such other special rules as the Commissioner of Public Works may deem necessary

Commissioner of Public Works

Signature of Property Owner or Representative

INSPECTOR'S REPORT

INSPECTED BY:

DATE:

COMMENTS:

☐ APPROVED

☐ DISAPPROVED

SIGNATURE

SKETCH PLAN

M E M O R A N D U M

TO: Lawrence C. Worden, Commissioner
Department of Public Works

FROM: Kenneth R. Ferreira, R.L.S., P.E. *KRF*

DATE: June 11, 2002

RE: Site Plan Review
Oliverio Ferreira - 1536 Acushnet Avenue, New Bedford, MA

As per the comments to the Planning Board for Site Plan Review for the above referenced project, the following revisions have been made.

- ▶ grading has been adjusted and a catch basin installed onsite to capture runoff prior to discharge to the city drainage system on Phillips Avenue.
- ▶ roof leaders have been added, and a collection pipe to also capture this runoff into the drain line.
- ▶ this will significantly reduce the predevelopment runoff which would have occurred at the original site prior to the fire.
- ▶ We have also added the City of New Bedford driveway brow as requested.

The Planning Board has asked that should these revisions meet the intent of the comment letter, that you send David Kennedy a memo to that effect.

Thank you for your cooperation in this matter.

encs. 2

cc: David Kennedy (2)
Oliverio Ferreira (6)

*CHANGED THE PLAN
LIKE WE ASKED,
- RW -*