

PERMIT NO.

23281



CITY OF NEW BEDFORD

DATE 9/19/02

9/9/03

SEWER AND/OR STORM DRAIN PERMIT

This certifies that permission is granted to

Gankin Co. Inc. (Bernard Lorange) P.O. Box 1035 Lakeville MA 02347

Property Owner

Address

#1063

Tel. (508) 320-9455

to connect a sewer and/or storm drain located at Rhonda Dr. (111.5.) 380 (41) N. / Terry Ln.

Assessor's Plot 130D, Lot 370, to the sewer and/or storm drain in Rhonda Dr. Street

to be laid in accordance with the conditions in this application and the City of New Bedford ordinances.

TYPE OF USE: ☒ RESIDENTIAL ☐ COMMERICAL ☐ INDUSTRIAL ☐ OTHER

If applicant other than actual property owner, attach Letter of Authorization from Property Owner.

Name N/A

Tel. 330 GPD

RECEIVED

OCT 21 2002

Mailing Address

DEPT. OF PUBLIC WORKS
NEW BEDFORD, MASS

The Bonded Contractor/Drain Layer authorized to perform this work is:

Pais Asphalt, Inc. 476 Hixville Rd. N. Dartmouth MA 02747 (508) 976-07

Name

Address

Tel.

Type of Pipe Required: PVC 5DR 35

PERMIT EXPIRES ONE YEAR AFTER DATE OF ISSUE

* Requires separate connections for sewage and storm drain where applicable. Storm water cannot be discharged to a sanitary sewer.

* All work must be inspected and approved by a D.P.W. inspector before backfilling.

* If this connection is to be part of a private service shared jointly with other building owners, attach copy of Recorded Joint Maintenance Agreement.

* Permits can be issued to Industrial and/or Commercial Applicants only upon receipt and approval by the Commissioner of Public Works of required plans and supplemental information.

* In addition, a City-issued Industrial User Discharge Permit and/or a Sewer Extension/Connection Permit issued by the Commonwealth of Massachusetts D.E.P. shall be required by the City for Industrial Discharge into the sewer system.

Industrial User Discharge Permit No. Date

Comm. Mass. Sewer Conn./Ext. Permit No. Date

A Filing and Inspection Fee of \$150.00, plus an Entrance Fee of \$ where applicable, must accompany this application.

Bank # Compass Bank Check # 301 Date: 9/9/02 Receipt # 4414

Other requirements: Inspection Only - Tying into sewer & storm drains in Rhonda Dr. All utilities are to be placed in one trench; only one patch on street - must coordinate accordingly, per Duarte Andrade.

☒ Sewer

Connection made to

Part of jointly-shared private line ☐ Yes ☒ No

☒ Storm Drain

Applicant agrees to abide by the above terms, as well as all pertinent ordinances of the City of New Bedford, and such other special rules as the Commissioner of Public Works may deem necessary

Commissioner of Public Works

Signature of Property Owner or Representative

INSPECTED BY: KEN REBELLO

DATE: 9/24/02


COMMENTS:

☒ APPROVED

☐ DISAPPROVED

SIGNATURE

Ken Rebello

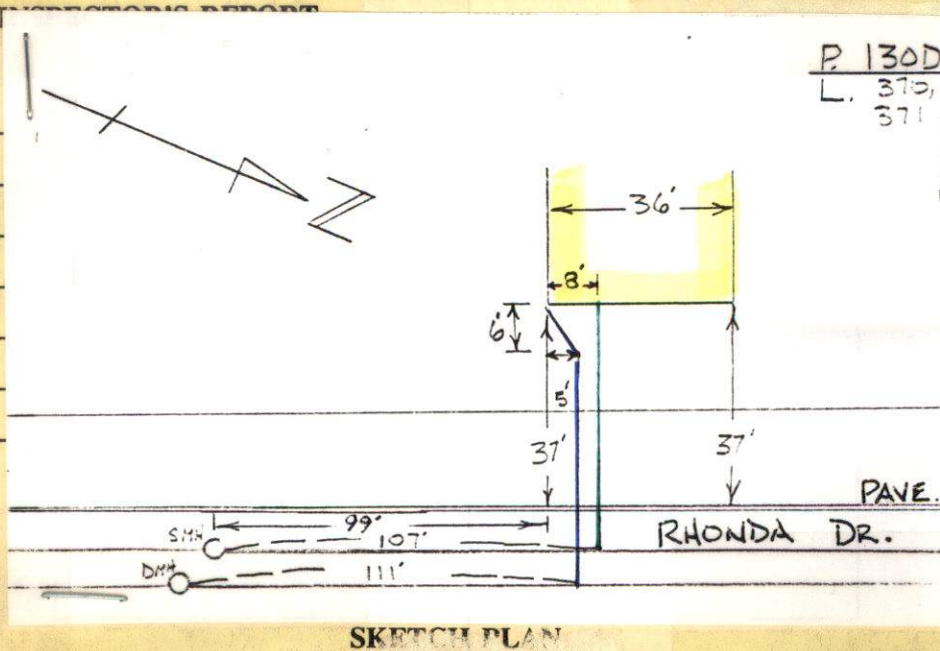

SKETCH PLAN