

ERMIT NO.

23285



CITY OF NEW BEDFORD

DATE... 9-12-02

SEWER AND/OR STORM DRAIN PERMIT

This certifies that permission is granted to CAL CAP REALTY LLC  
ANTONIO CALDERA 500 KINGS HIGHWAY N.B. MA. 02745 (508) 995-0711  
Property Owner Address Tel.

to connect a sewer and/or storm drain located at ASHLEY BLVD. SWC OF MARYLAND ST.  
Assessor's Plot 127C, Lot 127, to the sewer and/or storm drain in ASHLEY BLVD. Street  
to be laid in accordance with the conditions in this application and the City of New Bedford ordinances.

TYPE OF USE: ☐ RESIDENTIAL ☒ COMMERICAL ☐ INDUSTRIAL ☐ OTHER 200 GPD

If applicant other than actual property owner, attach Letter of Authorization from Property Owner.  
Name BUFFTREE BUILDING CO. (STANLEY P. CIEPLIK) Tel. (508) 997-5357  
Mailing Address 193 R - POPES ISLAND N.B. MA. 02740

The Bonded Contractor/Drain Layer authorized to perform this work is:

FRANKLIN BROS  
Name Address Tel.

Type of Pipe Required: PVC SDR 35

PERMIT EXPIRES ONE YEAR AFTER DATE OF ISSUE

- \* Requires separate connections for sewage and storm drain where applicable. Storm water cannot be discharged to a sanitary sewer.
- \* All work must be inspected and approved by a D.P.W. inspector before backfilling.
- \* If this connection is to be part of a private service shared jointly with other building owners, attach copy of Recorded Joint Maintenance Agreement.
- \* Permits can be issued to Industrial and/or Commercial Applicants only upon receipt and approval by the Commissioner of Public Works of required plans and supplemental information.
- \* In addition, a City-issued Industrial User Discharge Permit and/or a Sewer Extension/Connection Permit issued by the Commonwealth of Massachusetts D.E.P. shall be required by the City for Industrial Discharge into the sewer system.

Industrial User Discharge Permit No. N/A Date

Comm. Mass. Sewer Conn./Ext. Permit No. N/A Date

A Filing and Inspection Fee of \$ 150.00, plus an Entrance Fee of \$..... where applicable, must accompany this application.

Bank # COMPASS BANK Check # 17846 Date: 9-12-02 Receipt # 4419

Other requirements: SEWER + WATER MUST BE 10' APART

INSPECTION ONLY / CONNECTING TO EXISTING SEWER LINE AT PROP LINE

SD AS PER SITE PLAN REVIEW PLANS.

Connection made to ☒ Sewer Part of jointly-shared private line ☐ Yes ☒ No  
☒ Storm Drain

Applicant agrees to abide by the above terms, as well as all pertinent ordinances of the City of New Bedford, and such other special rules as the Commissioner of Public Works may deem necessary

Lawrence D. Worden (781)  
Commissioner of Public Works

X St. P. Cieplik  
Signature of Property Owner or Representative

INSPECTOR'S REPORT

INSPECTED BY: Pete Szczeska ?

DATE: 9/13 + 9/20-2002

COMMENTS:

☐ APPROVED ☐ DISAPPROVED

SIGNATURE

SKETCH PLAN



PERMIT NO.

23285



CITY OF NEW BEDFORD

DATE 9-12-02

SEWER AND/OR STORM DRAIN PERMIT

This certifies that permission is granted to CAL CAP REALTY LLC  
ANTONIO CALDERA 500 KINGS HIGHWAY N.B. MA. 02745 (508) 995-0711  
Property Owner Address Tel.

to connect a sewer and/or storm drain located at ASHLEY BLVD. SWC OF MARYLAND ST.  
Assessor's Plot 127C, Lot 127, to the sewer and/or storm drain in ASHLEY BLVD. Street  
to be laid in accordance with the conditions in this application and the City of New Bedford ordinances.

TYPE OF USE: ☐ RESIDENTIAL ☒ COMMERICAL ☐ INDUSTRIAL ☐ OTHER 200 GPD

If applicant other than actual property owner, attach Letter of Authorization from Property Owner.  
Name BUFFTREE BUILDING CO. (STANLEY P. CIEPLICK) Tel. (508) 997-5357  
Mailing Address 193 R - POPES ISLAND N.B. MA. 02740

The Bonded Contractor/Drain Layer authorized to perform this work is:  
FRANKLIN BROS  
Name Address Tel.

Type of Pipe Required: PVC SDR 35  
PERMIT EXPIRES ONE YEAR AFTER DATE OF ISSUE

- \* Requires separate connections for sewage and storm drain where applicable. Storm water cannot be discharged to a sanitary sewer.
- \* All work must be inspected and approved by a D.P.W. inspector before backfilling.
- \* If this connection is to be part of a private service shared jointly with other building owners, attach copy of Recorded Joint Maintenance Agreement.
- \* Permits can be issued to Industrial and/or Commercial Applicants only upon receipt and approval by the Commissioner of Public Works of required plans and supplemental information.
- \* In addition, a City-issued Industrial User Discharge Permit and/or a Sewer Extension/Connection Permit issued by the Commonwealth of Massachusetts D.E.P. shall be required by the City for Industrial Discharge into the sewer system.

Industrial User Discharge Permit No. N/A Date  
Comm. Mass. Sewer Conn./Ext. Permit No. N/A Date

A Filing and Inspection Fee of \$150.00, plus an Entrance Fee of \$..... where applicable, must accompany this application.

Bank # COMPASS BANK Check # 17846 Date: 9-12-02 Receipt # 4419

Other requirements: SEWER + WATER MUST BE 10' APART  
INSPECTION ONLY / CONNECTING TO EXISTING SEWER LINE AT PROP. LINE  
SD AS PER SITE PLAN REVIEW PLANS.

Connection made to ☒ Sewer Part of jointly-shared private line ☐ Yes ☒ No  
☒ Storm Drain

Applicant agrees to abide by the above terms, as well as all pertinent ordinances of the City of New Bedford, and such other special rules as the Commissioner of Public Works may deem necessary

Lawrence D. Worden (Signature) Commissioner of Public Works  
X St.P. Gith (Signature) Signature of Property Owner or Representative

INSPECTOR'S REPORT

INSPECTED BY: \_\_\_\_\_

DATE: \_\_\_\_\_

COMMENTS: \_\_\_\_\_

\_\_\_\_\_

\_\_\_\_\_


\_\_\_\_\_

\_\_\_\_\_

☐ APPROVED ☐ DISAPPROVED

\_\_\_\_\_

SIGNATURE

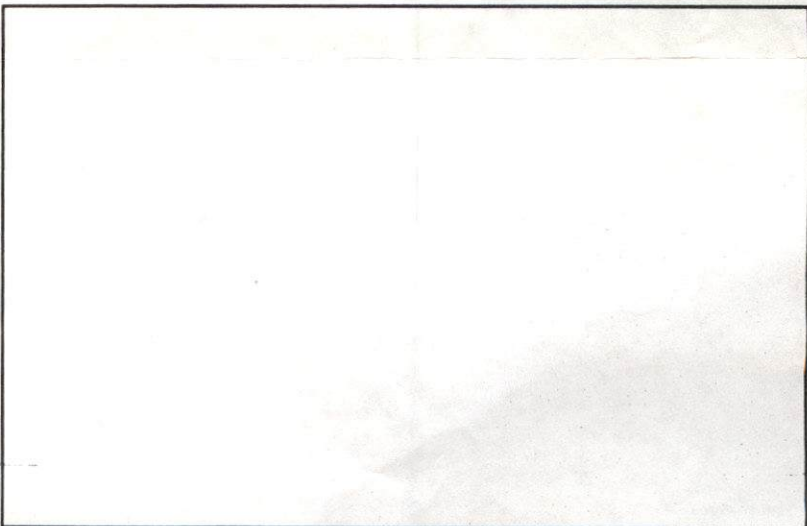

SKETCH PLAN

P 127 C.  
L 127

Finest Liquors  
500 King's Highway  
New Bedford, MA 02745

September 11, 2002

Department of Public Works  
City of New Bedford  
133 William Street  
New Bedford, MA 02740

Re: Finest Liquors  
889 Ashley Blvd.  
New Bedford, MA 02745  
BT0205277

To Whom It May Concern:


Please be advised that Bufftree Building Company, Inc. has the authority to obtain a sewer permit for the referenced project on our behalf.

Very truly yours,


Finest Liquors

By Antonio R. Caldera  
Antonio Caldera

OF CAL CAP REALTY LLC

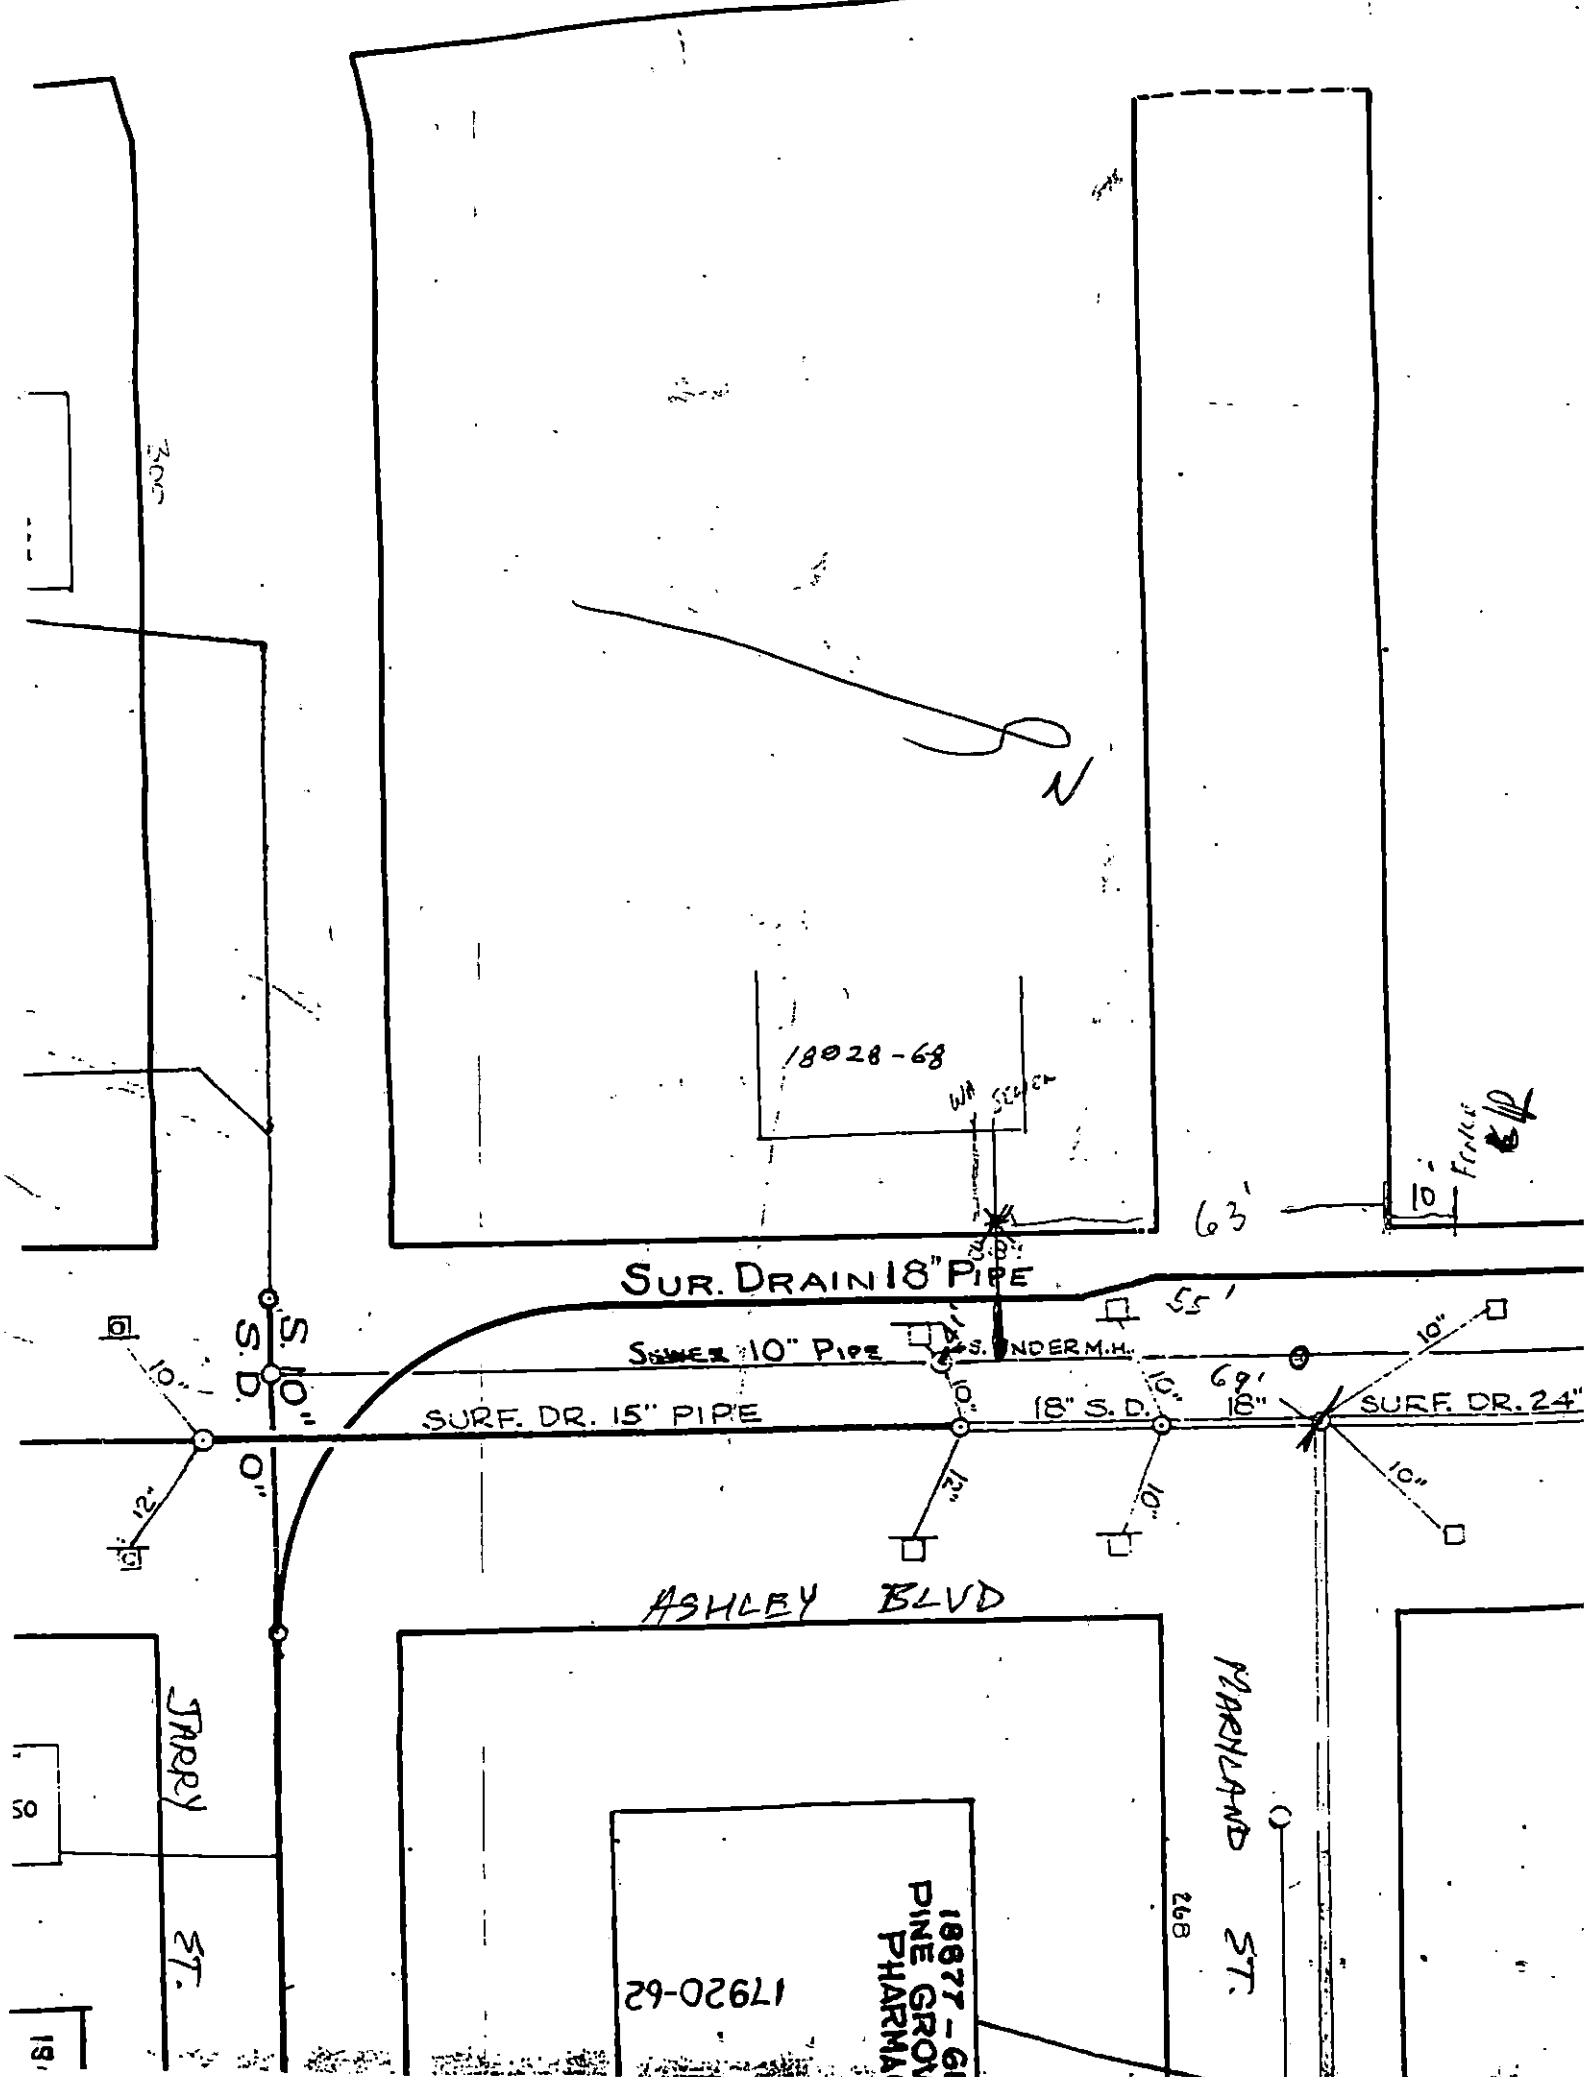



9/13/02 - FRANKLIN BROS. - SANITARY DRAIN

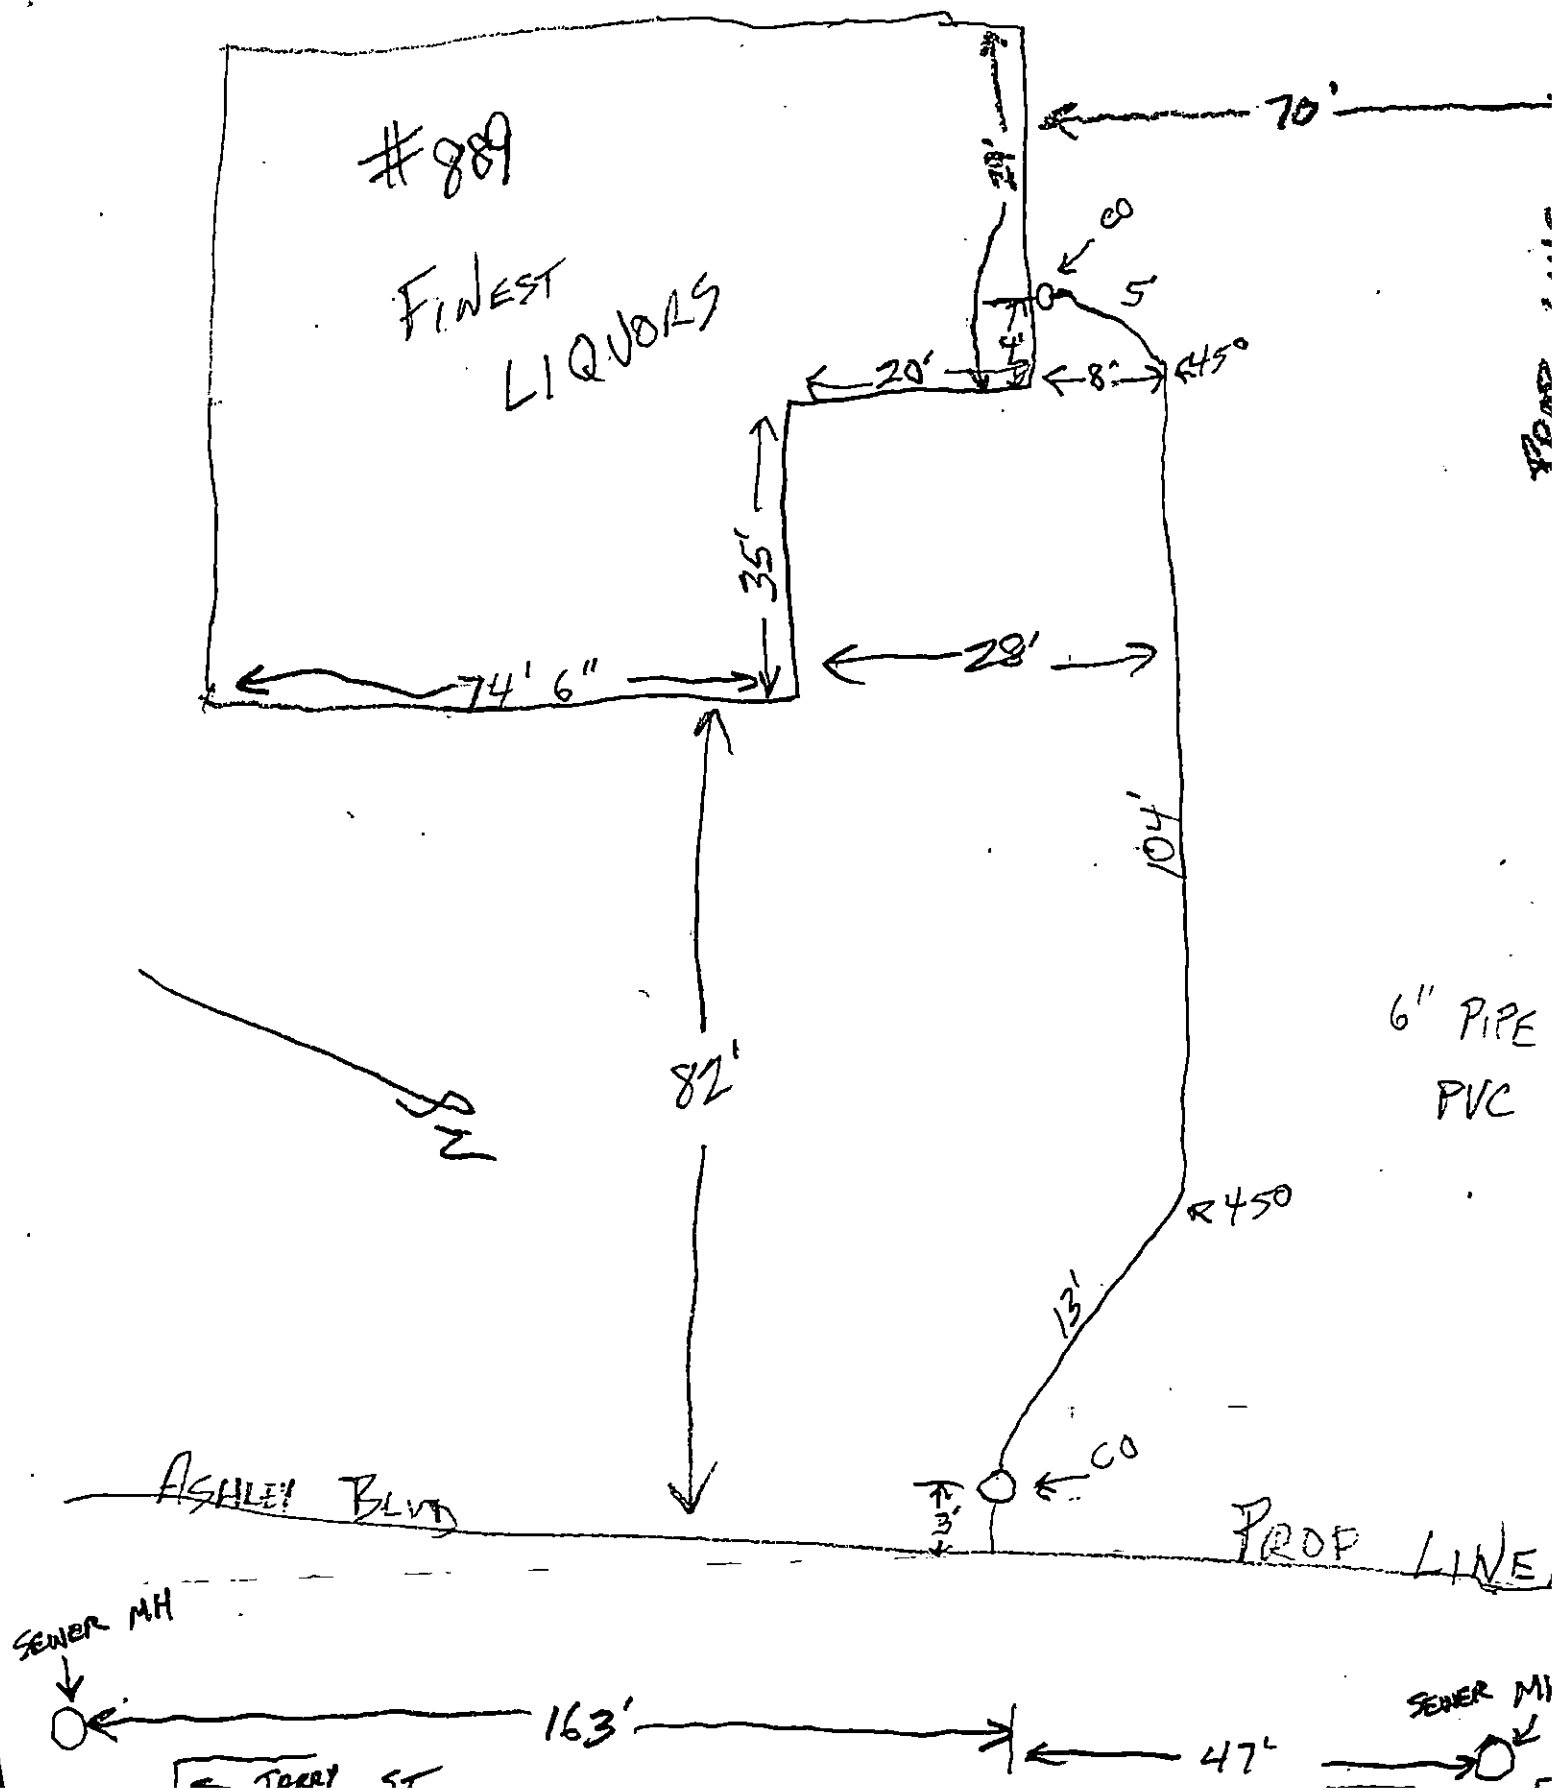



9/20/02 - MARTIN CONIR - STORM DRAIN  
FOR FRANKLIN BROS.

23285  
P. 127C  
L. 127

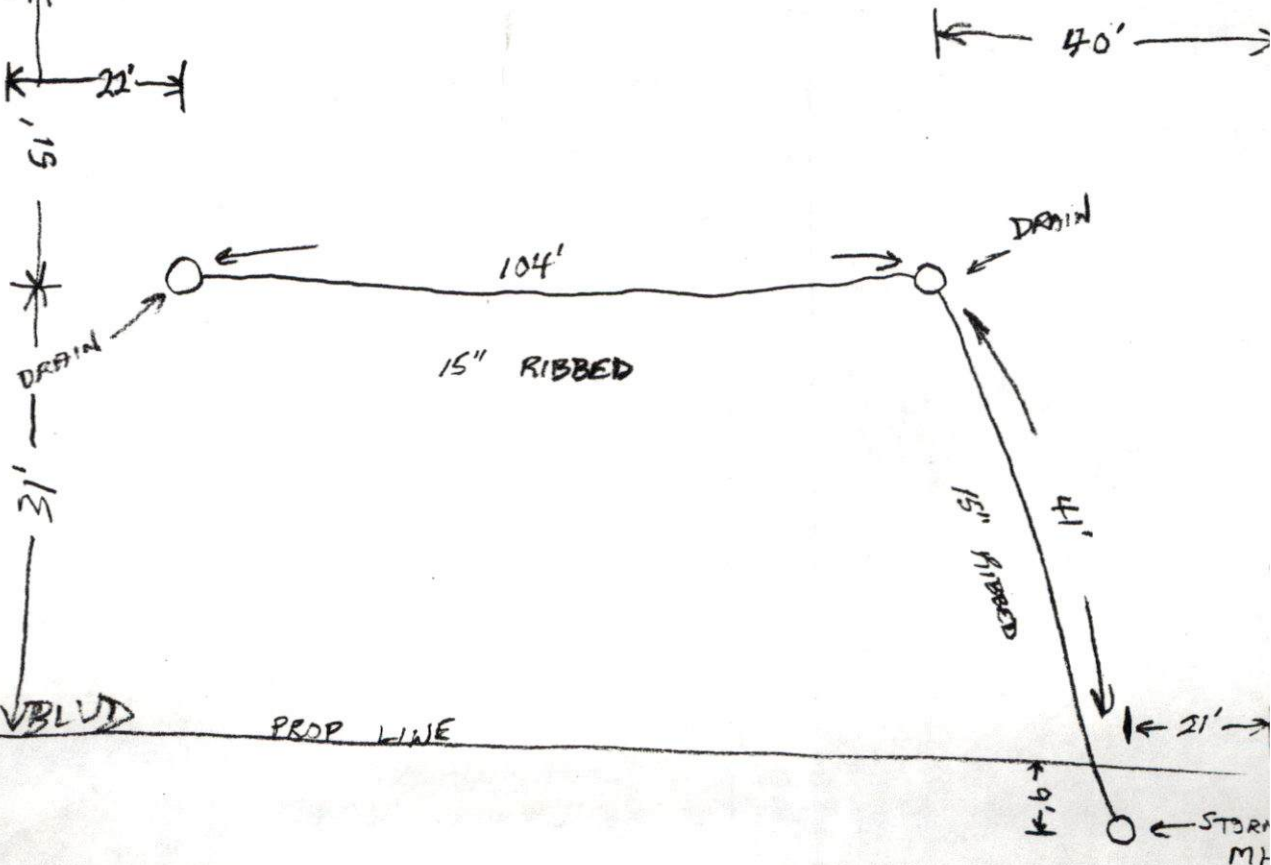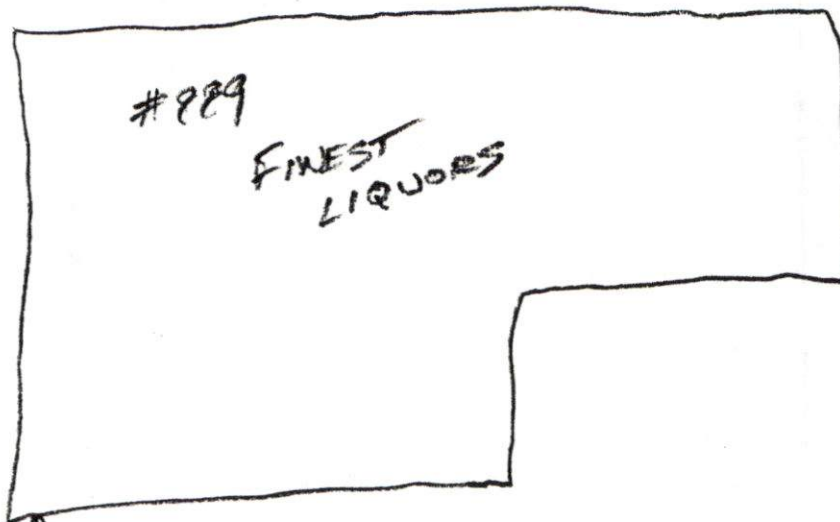

LTG  
47/5

JARRY  
ST.

18028-68 Demolished

MARYLAND  
ST.