

PERMIT NO.

23294



CITY OF NEW BEDFORD

DATE 10-8-02
EXP 10-8-03

SEWER AND/OR STORM DRAIN PERMIT

RECEIVED

This certifies that permission is granted to

LONG REALTY INC. 158 CHARLES McCOMB BLVD (508) 995-8240

Property Owner

Address

#1424

Tel.

DEPT. OF PUBLIC WORKS
NEW BEDFORD, MASS

to connect a sewer and/or storm drain located at PHILLIPS RD. (ES) 375' N/POUSH CE

Assessor's Plot 132.7 IF AVAILABLE, Lot 19, to the sewer and/or storm drain in PHILLIPS RD.

to be laid in accordance with the conditions in this application and the City of New Bedford ordinances.

TYPE OF USE: ☒ RESIDENTIAL ☐ COMMERICAL ☐ INDUSTRIAL ☐ OTHER

If applicant other than actual property owner, attach Letter of Authorization from Property Owner.

Name CHIP MOLFORD Tel (508) 965-8355

Mailing Address P.O. BOX 817 FAIRHAVEN MA 02719

The Bonded Contractor/Drain Layer authorized to perform this work is:

D.W. WHITE

Name

Address

Tel.

Type of Pipe Required: PVC SDR 35

PERMIT EXPIRES ONE YEAR AFTER DATE OF ISSUE

- * Requires separate connections for sewage and storm drain where applicable. Storm water cannot be discharged to a sanitary sewer.
- * All work must be inspected and approved by a D.P.W. inspector before backfilling.
- * If this connection is to be part of a private service shared jointly with other building owners, attach copy of Recorded Joint Maintenance Agreement.
- * Permits can be issued to Industrial and/or Commercial Applicants only upon receipt and approval by the Commissioner of Public Works of required plans and supplemental information.
- * In addition, a City-issued Industrial User Discharge Permit and/or a Sewer Extension/Connection Permit issued by the Commonwealth of Massachusetts D.E.P. shall be required by the City for Industrial Discharge into the sewer system.

Industrial User Discharge Permit No. N/A Date

Comm. Mass. Sewer Conn./Ext. Permit No. N/A Date

A Filing and Inspection Fee of \$150.00, plus an Entrance Fee of \$ where applicable, must accompany this application.

Bank # COMPASS BANK Check # 26921 Date: 10-3-02 Receipt # 4441

Other requirements: ~~SEE DETAIL AS REQUIRED MUST BE INTO S.D. IF AVAILABLE TRIPIC BY UNIT~~

Connection made to ☒ Sewer ☒ Storm Drain
Part of jointly-shared private line ☐ Yes ☒ No
Showing sewer going through easement can issue permits for L17 & L19
add'l permits will only be issued once from Labelle. Having profile of
sewer line in adjacent building
hooking up to Dave Kennedy (plumbing) has copy of easement for sewer
and all set on his end (checked easement).

Applicant agrees to abide by the above terms, as well as all pertinent ordinances of the City of New Bedford, and such other special rules as the Commissioner of Public Works may deem necessary

Lawrence P. W...
Commissioner of Public Works

Signature of Property Owner or Representative

INSPECTOR'S REPORT

INSPECTED BY: JOSEPH MARTIN

DATE: 12/13/02


COMMENTS:

S.D. CONNECTION WAIVED
BY DUARTE ANDRADE. TOO
far away for connection to be
made.

☒ APPROVED

☐ DISAPPROVED

Signature

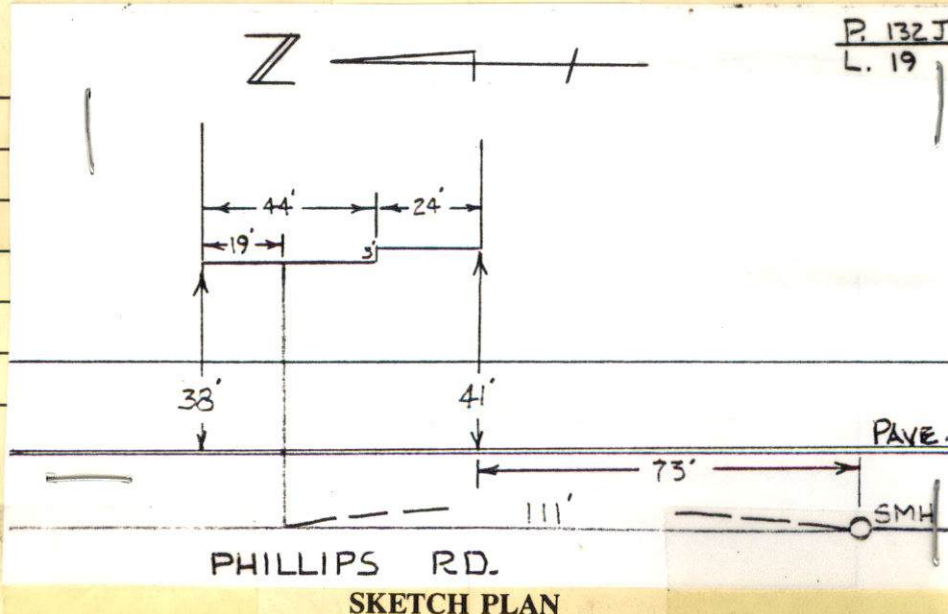

PERMIT NO.
23294



CITY OF NEW BEDFORD

DATE 10-8-02
EXP 10-8-03

SEWER AND/OR STORM DRAIN PERMIT

This certifies that permission is granted to

LONG REALTY INC 158 CHARLES McCOMB BLVD (508) 995-8240
Property Owner Address Tel.

to connect sewer and/or storm drain located at PHILLIPS RD. (ES) 375' N/ POLISH CEMETERY
Assessor's Plot 132-A, Lot 19 (Lot 6), to the sewer and/or storm drain in PHILLIPS RD. Street
to be laid in accordance with the conditions in this application and the City of New Bedford ordinances.

TYPE OF USE: ☒ RESIDENTIAL ☐ COMMERICAL ☐ INDUSTRIAL ☐ OTHER 330 GPD

If applicant other than actual property owner, attach Letter of Authorization from Property Owner.

Name CHIP MULFORD Tel (508) 965-8355

Mailing Address P.O. BOX 817 FAIRHAVEN MA 02719

The Bonded Contractor/Drain Layer authorized to perform this work is: D.W. WHITE
Name Address Tel

Type of Pipe Required: PVC SDR 35
1) Sewer to go into easement sewer line in rear of lot to subdiv. ~ Warrford Estates.
2) Storm drain/rain leaders to be directed into ditch at back of property.

PERMIT EXPIRES ONE YEAR AFTER DATE OF ISSUE

- * Requires separate connections for sewage and storm drain where applicable. Storm water cannot be discharged to a sanitary sewer.
- * All work must be inspected and approved by a D.P.W. inspector before backfilling.
- * If this connection is to be part of a private service shared jointly with other building owners, attach copy of Recorded Joint Maintenance Agreement.
- * Permits can be issued to Industrial and/or Commercial Applicants only upon receipt and approval by the Commissioner of Public Works of required plans and supplemental information.
- * In addition, a City-issued Industrial User Discharge Permit and/or a Sewer Extension/Connection Permit issued by the Commonwealth of Massachusetts D.E.P. shall be required by the City for Industrial Discharge into the sewer system.

Industrial User Discharge Permit No. N/A Date

Comm. Mass. Sewer Conn./Ext. Permit No. N/A Date

A Filing and Inspection Fee of \$ 150.00, plus an Entrance Fee of \$ where applicable, must accompany this application.

Bank # COMPASS BANK Check # 26921 Date: 10-3-02 Receipt # 4441

Other requirements: PERMIT DETAIL AS REQUIRED MUST BE IN TO S.D. IF AVAILABLE Inspected by W.W.D.

SITE EX. MAINT. SIGN. AND EASEMENT 10/8/02 Per Duarte Bridge - once we get plan showing sewer going through easement, can issue permits for L 17 & L 19
add'l permits will only be issued once Ron Labelle has profile of sewer line in adjacent subdiv. through these A.N.R. lots will be hooked up to. Dave Kennedy (Planning) has copy of easement for sewer and all set on his end (Recorded easement).
☒ Sewer ☐ Storm Drain
Part of jointly-shared private line ☐ Yes ☒ No

Applicant agrees to abide by the above terms, as well as all pertinent ordinances of the City of New Bedford, and such other special rules as the Commissioner of Public Works may deem necessary

Lawrence D. Warden / ssc
Commissioner of Public Works

Chip Mulford
Signature of Property Owner or Representative

INSPECTOR'S REPORT

INSPECTED BY: _____

DATE: _____

COMMENTS: _____

☐ APPROVED ☐ DISAPPROVED

SIGNATURE

SKETCH PLAN



CITY OF NEW BEDFORD
MASSACHUSETTS

DEPT. OF PUBLIC WORKS

133 WILLIAM STREET

LAWRENCE D. WORDEN
COMMISSIONER

To Whom It May Concern:

I, Long Robert, Inc. 158 Charles McComb Blvd, being
Name Mailing Address

owner of property located at Woodford Estates (wire looking)

Plot 132-I, Lot 19, hereby agree to allow Ralph K. Chip Fluker
(31 or lot 6) Name

My Attorney, P.O. Box 517, Fairhaven 02749 to act on my behalf,
Mailing Address

including affixing my signature, in securing permits for:

☒ Sewer/Drain Service Permits
☒ Water Service Permits
☒ Driveway Installation Permits
None yet Sidewalk Installation Permits

I further agree to confirm to, and abide by, all City rules and regulations applicable to the permits(s) being applied for.

Name Robert Long
Print
Long Robert, Inc
158 Charles McComb Blvd
Address
New Bedford, MA 02745
March 2, 2002
Date

