

PERMIT NO.

23295



CITY OF NEW BEDFORD

DATE 10-3-02

SEWER AND/OR STORM DRAIN PERMIT

This certifies that permission is granted to

JOHN MAFFEI RD. BOX 79416 NO. DART. MA. 02747 (508) 992-7800

Property Owner

Address

Tel.

to connect a sewer and/or storm drain located at EASTLAND TER. (SS) 360' ± W/ ROCKDALE AVE.

Assessor's Plot 74, Lot 169, to the sewer and/or storm drain in EASTLAND TER. Street

to be laid in accordance with the conditions in this application and the City of New Bedford ordinances.

TYPE OF USE: [X] RESIDENTIAL [] COMMERCIAL [] INDUSTRIAL [] OTHER

3306PD

If applicant other than actual property owner, attach Letter of Authorization from Property Owner.

Name..... Tel.....

Mailing Address.....

RECEIVED

The Bonded Contractor/Drain Layer authorized to perform this work is:

NOV 27 2002

ACE ASPHALT

DEPT. OF PUBLIC WORKS NEW BEDFORD MASS

Name

Address

Type of Pipe Required: PVC SDR 35

PERMIT EXPIRES ONE YEAR AFTER DATE OF ISSUE

- * Requires separate connections for sewage and storm drain where applicable. Storm water cannot be discharged to a sanitary sewer.
* All work must be inspected and approved by a D.P.W. inspector before backfilling.
* If this connection is to be part of a private service shared jointly with other building owners, attach copy of Recorded Joint Maintenance Agreement.
* Permits can be issued to Industrial and/or Commercial Applicants only upon receipt and approval by the Commissioner of Public Works of required plans and supplemental information.
* In addition, a City-issued Industrial User Discharge Permit and/or a Sewer Extension/Connection Permit issued by the Commonwealth of Massachusetts D.E.P. shall be required by the City for Industrial Discharge into the sewer system.

Industrial User Discharge Permit No. N/A Date.....
Comm. Mass. Sewer Conn./Ext. Permit No. N/A Date.....

A Filing and Inspection Fee of \$150.00, plus an Entrance Fee of \$..... where applicable, must accompany this application.

Bank # FIRST CITIZENS Check # 1438 Date: 10-3-02 Receipt #

Other requirements: INSPECTED ONLY TO STUB AT PROPERTY LINE BY W.W.D.

Connection made to [X] Sewer Part of jointly-shared private line [] Yes [X] No
[X] Storm Drain

Applicant agrees to abide by the above terms, as well as all pertinent ordinances of the City of New Bedford, and such other special rules as the Commissioner of Public Works may deem necessary


Lawrence D. Worden (MHS) Commissioner of Public Works

Signature of Property Owner or Representative

INSPECTED BY: KEN REBELLO
DATE: 10/8/02
COMMENTS: Inspected by Rebello on 10/8/02 from R. Stub installed as per Eastland Farms Subdi plan to be submitted.

[] APPROVED [] DISAPPROVED

Ken Rebello SIGNATURE

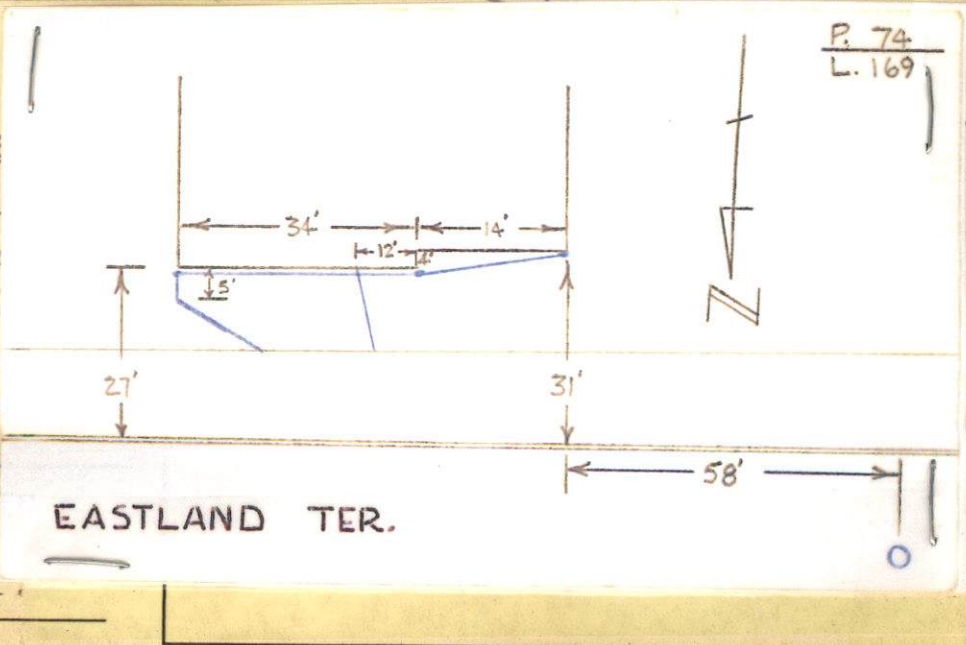

EASTLAND TER.

SKETCH PLAN

PERMIT NO.:

23295



CITY OF NEW BEDFORD

DATE 10-3-02

SEWER AND/OR STORM DRAIN PERMIT

This certifies that permission is granted to

JOHN MAFFEI PO. BOX 79416 NO. DART. MA. 02747 (508) 992-7800

Property Owner

Address

Tel.

to connect a sewer and/or storm drain located at EASTLAND TER. (SS) 360' ± W/ ROCKDALE AVE.

Assessor's Plot 74, Lot 169, to the sewer and/or storm drain in EASTLAND TER. Street

to be laid in accordance with the conditions in this application and the City of New Bedford ordinances.

TYPE OF USE: [X] RESIDENTIAL [] COMMERCIAL [] INDUSTRIAL [] OTHER

3306PD.

If applicant other than actual property owner, attach Letter of Authorization from Property Owner.

Name.....Tel.....

Mailing Address.....

The Bonded Contractor/Drain Layer authorized to perform this work is:

ACE ASPHALT

Name

Address

Tel.

Type of Pipe Required: PVC SDR 35

PERMIT EXPIRES ONE YEAR AFTER DATE OF ISSUE

- * Requires separate connections for sewage and storm drain where applicable. Storm water cannot be discharged to a sanitary sewer.
* All work must be inspected and approved by a D.P.W. inspector before backfilling.
* If this connection is to be part of a private service shared jointly with other building owners, attach copy of Recorded Joint Maintenance Agreement.
* Permits can be issued to Industrial and/or Commercial Applicants only upon receipt and approval by the Commissioner of Public Works of required plans and supplemental information.
* In addition, a City-issued Industrial User Discharge Permit and/or a Sewer Extension/Connection Permit issued by the Commonwealth of Massachusetts D.E.P. shall be required by the City for Industrial Discharge into the sewer system.

Industrial User Discharge Permit No. N/A Date.....

Comm. Mass. Sewer Conn./Ext. Permit No. N/A Date.....

A Filing and Inspection Fee of \$150.00, plus an Entrance Fee of \$..... where applicable, must accompany this application.

Bank # FIRST CITIZENS Check # 1438 Date: 10-3-02 Receipt #

Other requirements: INSPECTED ONLY TO STUB AT PROPERTY LINE BY W.W.D.

Connection made to [X] Sewer [X] Storm Drain Part of jointly-shared private line [] Yes [X] No


Applicant agrees to abide by the above terms, as well as all pertinent ordinances of the City of New Bedford, and such other special rules as the Commissioner of Public Works may deem necessary

Lawrence D. Worden Commissioner of Public Works

Signature of Property Owner or Representative

INSPECTOR'S REPORT

INSPECTED BY:
DATE:
COMMENTS:
[] APPROVED [] DISAPPROVED

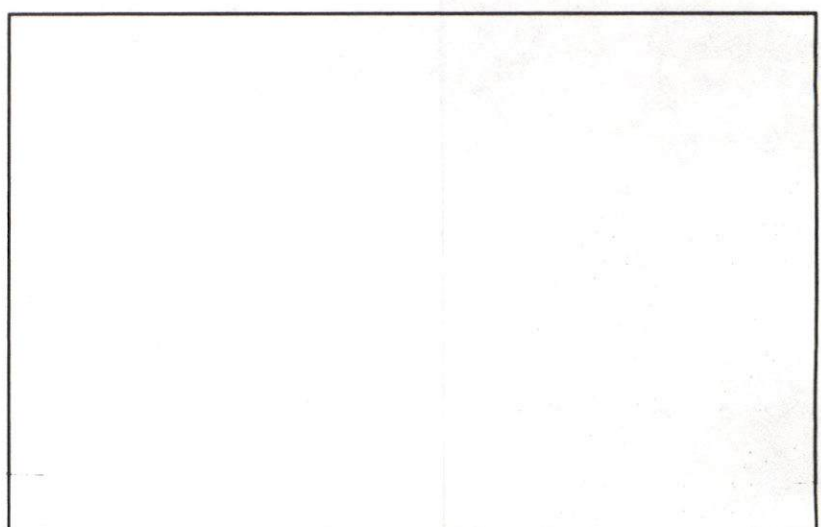

SIGNATURE

SKETCH PLAN