

PERMIT NO.

23304



CITY OF NEW BEDFORD

DATE 11-8-02

SEWER AND/OR STORM DRAIN PERMIT

This certifies that permission is granted to

ROBERT BOUGE OIS

37 MEMORIAL AVE SO. DARTMOUTH MA. 02748

Property Owner

Address

Tel.

to connect a sewer and/or storm drain located at APPLETON ST. (SS) 80' ± E / PINE GROVE ST.

Assessor's Plot 127C, Lot 265, to the sewer and/or storm drain in APPLETON ST. Street

to be laid in accordance with the conditions in this application and the City of New Bedford ordinances.

TYPE OF USE: ☒ RESIDENTIAL ☐ COMMERICAL ☐ INDUSTRIAL ☐ OTHER

2206PD

If applicant other than actual property owner, attach Letter of Authorization from Property Owner.

Name MAURICE BRUNEAU

Tel. (508) 763-5965

Mailing Address PO BOX 333 EAST. FREETOWN MA. 02717

The Bonded Contractor/Drain Layer authorized to perform this work is:

CANESSA EK

Name

Address

RECEIVED

DEC 17 2002

DEPT. OF PUBLIC WORKS
NEW BEDFORD, MASS.

Type of Pipe Required: PVC SDR 35

PERMIT EXPIRES ONE YEAR AFTER DATE OF ISSUE

- * Requires separate connections for sewage and storm drain where applicable. Storm water cannot be discharged to a sanitary sewer.
- * All work must be inspected and approved by a D.P.W. inspector before backfilling.
- * If this connection is to be part of a private service shared jointly with other building owners, attach copy of Recorded Joint Maintenance Agreement.
- * Permits can be issued to Industrial and/or Commercial Applicants only upon receipt and approval by the Commissioner of Public Works of required plans and supplemental information.
- * In addition, a City-issued Industrial User Discharge Permit and/or a Sewer Extension/Connection Permit issued by the Commonwealth of Massachusetts D.E.P. shall be required by the City for Industrial Discharge into the sewer system.

Industrial User Discharge Permit No. N/A Date

Comm. Mass. Sewer Conn./Ext. Permit No. N/A Date

A Filing and Inspection Fee of \$150.00, plus an Entrance Fee of \$..... where applicable, must accompany this application.

Bank # FLEET Check # 529 Date: 11-8-02 Receipt # 4473

Other requirements: TO BE CONSTRUCTED IN ACCORDANCE WITH PLAN SUBMITTED AND APPROVED BY ROW LABELLE (WASTEWATER) per Duane Andrade. SEE ATTACHED (DISCLOSED w/ ROW LABELLE)

Connection made to ☒ Sewer ☐ Storm Drain Part of jointly-shared private line ☐ Yes ☒ No

Applicant agrees to abide by the above terms, as well as all pertinent ordinances of the City of New Bedford, and such other special rules as the Commissioner of Public Works may deem necessary

Commissioner of Public Works

Signature of Property Owner or Representative

INSPECTOR'S REPORT

INSPECTED BY: JOSEPH MARTIN


DATE: 11/19/02

COMMENTS:

☒ APPROVED ☐ DISAPPROVED

SIGNATURE

31-746

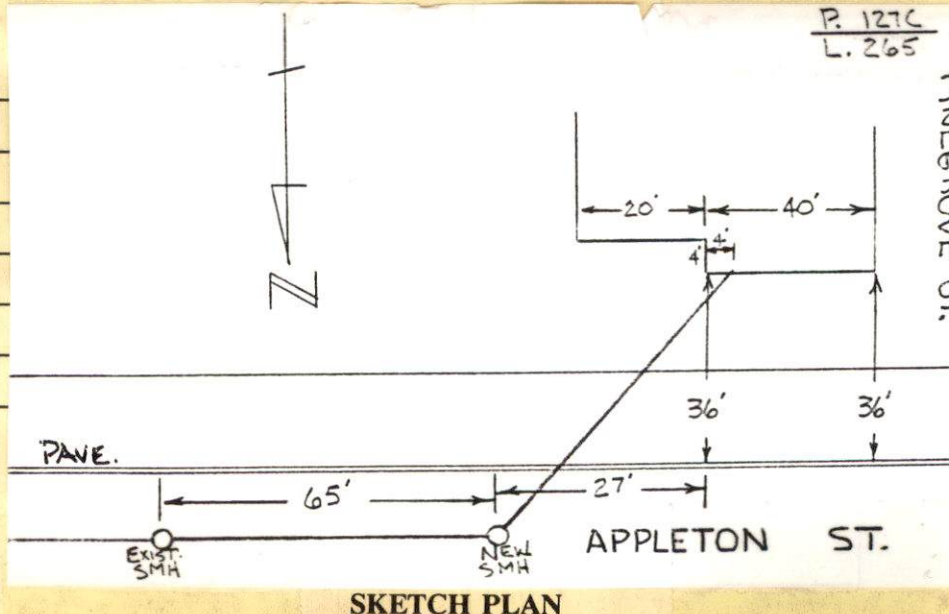

SKETCH PLAN

PERMIT NO.

23304



CITY OF NEW BEDFORD

DATE...11-8-02

SEWER AND/OR STORM DRAIN PERMIT

This certifies that permission is granted to

ROBERT BOUGEIS

37 MEMORIAL AVE SO. DARTMOUTH MA. 02748

Property Owner

Address

Tel.

to connect a sewer and/or storm drain located at...APPLETON ST. (SS) 80'± E/PINE GROVE ST.

Assessor's Plot. 127C, Lot. 265, to the sewer and/or storm drain in...APPLETON ST. Street

to be laid in accordance with the conditions in this application and the City of New Bedford ordinances.

TYPE OF USE: ☒ RESIDENTIAL ☐ COMMERICAL ☐ INDUSTRIAL ☐ OTHER

2206PD

If applicant other than actual property owner, attach Letter of Authorization from Property Owner.

Name MAURICE BRUNEAU

Tel. (508) 763-5966

Mailing Address PO BOX 333 EAST FREETOWN MA. 02717

The Bonded Contractor/Drain Layer authorized to perform this work is:

CANESSA EX

Name

Address

Tel.

Type of Pipe Required: PVC SDR 35

PERMIT EXPIRES ONE YEAR AFTER DATE OF ISSUE

* Requires separate connections for sewage and storm drain where applicable. Storm water cannot be discharged to a sanitary sewer.

* All work must be inspected and approved by a D.P.W. inspector before backfilling.

* If this connection is to be part of a private service shared jointly with other building owners, attach copy of Recorded Joint Maintenance Agreement.

* Permits can be issued to Industrial and/or Commercial Applicants only upon receipt and approval by the Commissioner of Public Works of required plans and supplemental information.

* In addition, a City-issued Industrial User Discharge Permit and/or a Sewer Extension/Connection Permit issued by the Commonwealth of Massachusetts D.E.P. shall be required by the City for Industrial Discharge into the sewer system.

Industrial User Discharge Permit No. N/A Date

Comm. Mass. Sewer Conn./Ext. Permit No. N/A Date

A Filing and Inspection Fee of \$150.00, plus an Entrance Fee of \$..... where applicable, must accompany this application.

Bank # FLEET Check # 529 Date: 11-8-02 Receipt # 4473

Other requirements: TO BE CONSTRUCTED IN ACCORDANCE WITH PLAN SUBMITTED AND APPROVED BY ROW LABELLE (WATERWORKS) per Duarte Andrade.

☒ Sewer

Part of jointly-shared private line ☐ Yes ☒ No

Connection made to

☐ Storm Drain

Applicant agrees to abide by the above terms, as well as all pertinent ordinances of the City of New Bedford, and such other special rules as the Commissioner of Public Works may deem necessary

Lawrence D. Warden
Commissioner of Public Works

Maurice Brunneau
Signature of Property Owner or Representative

INSPECTOR'S REPORT

INSPECTED BY: _____

DATE: _____

COMMENTS: _____

☐ APPROVED

☐ DISAPPROVED

SIGNATURE

SKETCH PLAN

**CITY OF NEW BEDFORD
MASSACHUSETTS****DEPARTMENT OF PUBLIC WORKS
ENGINEERING DIVISION****133 WILLIAM STREET, ROOM 303****NEW BEDFORD, MA 02740****Tel: (508) 979-1527****Fax: (508) 961-3043****To Whom It May Concern:**

I, Robert Bourgeois, being
(Name) (Mailing Address)

Owner of property located at _____

Plot 127C, Lot 265, hereby agree to allow MAURICE BRUNEAU
(Name)

P.O. BOX 333 E. FREETOWN MA 02741 to act on my behalf including affixing my
(Mailing Address)

signature in securing permit for:

☒ Sewer/Drain Service Permits
☐ Water Service Permits
☐ Driveway Installation Permits
☐ Sidewalk Installation Permits

I further agree to conform to, and abide by, all City rules and ask regulations applicable to the permit (s) being applied for:

Name Robert R Bourgeois
(Signature)

220 APPLETON ST.
(Address)

11-9-02 239 530 4483
(Date) (Telephone number)