

PERMIT NO.

23305



CITY OF NEW BEDFORD

DATE 11-8-02

SEWER AND/OR STORM DRAIN PERMIT

5 STAR SURGICAL

This certifies that permission is granted to
ZENITH VENTURES, LLC 138 HATCH ST. N.B. MA 02745
Property Owner Address # 163 Tel (508) 998-1404
to connect a sewer and/or storm drain located at SAMUEL BARNET BLVD.
Assessor's Plot 135, Lot 37, to the sewer and/or storm drain in SAMUEL BARNET BLVD. Street
to be laid in accordance with the conditions in this application and the City of New Bedford ordinances.

TYPE OF USE: ☐ RESIDENTIAL ☐ COMMERICAL ☒ INDUSTRIAL ☐ OTHER

If applicant other than actual property owner, attach Letter of Authorization from Property Owner.

500 6PD
PER V.F.

Name BUFFTREE BUILDING CO. (STAN CIEPLIK) Tel (508) 997-5357

Mailing Address 193 R POPES ISLAND N.B. MA 02740

The Bonded Contractor/Drain Layer authorized to perform this work is:

BUFFTREE BUILDING CO.
Name Address Tel.

Type of Pipe Required: PVC SDR 35

PERMIT EXPIRES ONE YEAR AFTER DATE OF ISSUE

- * Requires separate connections for sewage and storm drain where applicable. Storm water cannot be discharged to a sanitary sewer.
- * All work must be inspected and approved by a D.P.W. inspector before backfilling.
- * If this connection is to be part of a private service shared jointly with other building owners, attach copy of Recorded Joint Maintenance Agreement.
- * Permits can be issued to Industrial and/or Commercial Applicants only upon receipt and approval by the Commissioner of Public Works of required plans and supplemental information.
- * In addition, a City-issued Industrial User Discharge Permit and/or a Sewer Extension/Connection Permit issued by the Commonwealth of Massachusetts D.E.P. shall be required by the City for Industrial Discharge into the sewer system.

Industrial User Discharge Permit No. 6028 Date 11-12-02 PER V.F.

Comm. Mass. Sewer Conn./Ext. Permit No. N/A Date

A Filing and Inspection Fee of \$150.00, plus an Entrance Fee of \$ where applicable, must accompany this application.

Bank # COMPASS BANK Check # 18251 Date 11-12-02 Receipt # 4474

Other requirements: INSPECTION ONLY

Connection made to ☒ Sewer Part of jointly-shared private line ☐ Yes ☒ No
☐ Storm Drain

Applicant agrees to abide by the above terms, as well as all pertinent ordinances of the City of New Bedford, and such other special rules as the Commissioner of Public Works may deem necessary

Laurence D. Warden
Commissioner of Public Works


Signature of Property Owner or Representative

INSPECTOR'S REPORT

INSPECTED BY:

DATE:

COMMENTS:

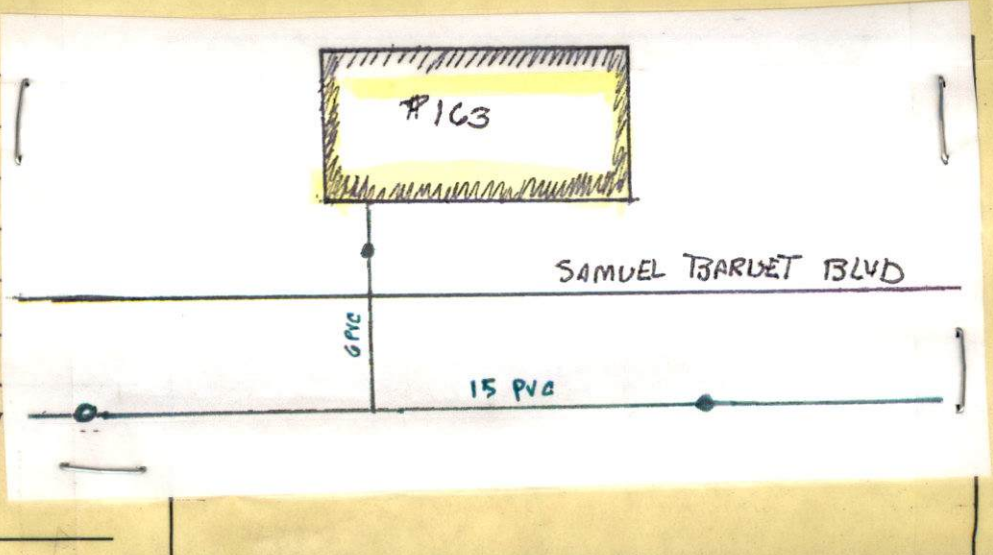

☐ APPROVED ☐ DISAPPROVED

SIGNATURE

SKETCH PLAN

PERMIT NO.

23305



CITY OF NEW BEDFORD

DATE 11-8-02

SEWER AND/OR STORM DRAIN PERMIT

5 STAR

This certifies that permission is granted to

ZENITH VENTURES, LLC 138 HATCH ST. N.B. MA. 02745
Property Owner Address Tel. (508) 998-1404

to connect a sewer and/or storm drain located at SAMUEL BARNET BLVD.
Assessor's Plot. 135, Lot. 37, to the sewer and/or storm drain in SAMUEL BARNET BLVD. Street
to be laid in accordance with the conditions in this application and the City of New Bedford ordinances.

TYPE OF USE: ☐ RESIDENTIAL ☐ COMMERICAL ☒ INDUSTRIAL ☐ OTHER

If applicant other than actual property owner, attach Letter of Authorization from Property Owner.

Name BUFFTREE BUILDING CO. (STAN CIEPLIK) Tel. (508) 997-5357

Mailing Address 193 R. PUPES ISLAND N.B. MA. 02740

The Bonded Contractor/Drain Layer authorized to perform this work is:

BUFFTREE BUILDING CO.
Name Address Tel.

Type of Pipe Required: PVC SDR 35

PERMIT EXPIRES ONE YEAR AFTER DATE OF ISSUE

- * Requires separate connections for sewage and storm drain where applicable. Storm water cannot be discharged to a sanitary sewer.
- * All work must be inspected and approved by a D.P.W. inspector before backfilling.
- * If this connection is to be part of a private service shared jointly with other building owners, attach copy of Recorded Joint Maintenance Agreement.
- * Permits can be issued to Industrial and/or Commercial Applicants only upon receipt and approval by the Commissioner of Public Works of required plans and supplemental information.
- * In addition, a City-issued Industrial User Discharge Permit and/or a Sewer Extension/Connection Permit issued by the Commonwealth of Massachusetts D.E.P. shall be required by the City for Industrial Discharge into the sewer system.

Industrial User Discharge Permit No. 6028 Date 11-12-02 PER V.F.

Comm. Mass. Sewer Conn./Ext. Permit No. N/A Date

A Filing and Inspection Fee of \$150.00, plus an Entrance Fee of \$ where applicable, must accompany this application.

Bank # COMPASS BANK Check # 18251 Date 11-12-02 Receipt # 4474

Other requirements: INSPECTION ONLY

Connection made to ☒ Sewer ☐ Storm Drain Part of jointly-shared private line ☐ Yes ☒ No

Applicant agrees to abide by the above terms, as well as all pertinent ordinances of the City of New Bedford, and such other special rules as the Commissioner of Public Works may deem necessary

Laurence D. Warden
Commissioner of Public Works

Signature of Property Owner or Representative

INSPECTOR'S REPORT

INSPECTED BY:

DATE:

COMMENTS:

☐ APPROVED ☐ DISAPPROVED

SIGNATURE

SKETCH PLAN



CITY OF NEW BEDFORD
MASSACHUSETTS

DEPARTMENT OF PUBLIC WORKS
ENGINEERING DIVISION
133 WILLIAM STREET, ROOM 303
NEW BEDFORD, MA 02740
Tel: (508) 979-1527
Fax: (508) 961-3043

SEWER #

23305

RECEIVED

NOV 12 2002

DEPT. OF PUBLIC WORKS
NEW BEDFORD, MASS.

To Whom It May Concern:

I, DAVID A. CABRAL, of 138 HATCH ST. N.B., being
(Name) (Mailing Address)

Owner of property located at SAMUEL BARNET BLVD.

Plot 135, Lot 37, hereby agree to allow MR. STAN CIEPLIK OF BUFFTREE
(Name)

BLOG. Co. OF NEW BEDFORD, MA to act on my behalf including affixing my
(Mailing Address)

signature in securing permit for:

☒ Sewer/Drain Service Permits
☒ Water Service Permits
☒ Driveway Installation Permits
☒ Sidewalk Installation Permits

I further agree to conform to, and abide by, all City rules and ask regulations applicable to the permit (s) being applied for:

Name David A. All
(Signature)

138 HATCH ST. NEW BEDFORD, MA.
(Address)

11/8/02 508-998-1404
(Date) (Telephone number)



#23305

RECEIVEDNovember 5, 2002 **NOV 12 2002****DEPT. OF PUBLIC WORKS
NEW BEDFORD, MASS.**

To Whom this may Concern,

Please accept this letter as authorization from Five Star Surgical, Inc and Zenith Ventures, LLC to allow Mr. Stanley Cieplik, a Project Manager for Bufftree Building Company, Inc., to make the necessary decisions for the installation of utilities, and related equipment, at the Five Star Surgical construction site located on Samuel Barnett Blvd. in the New Bedford Business Park.

SEWER + S.D. (A)

PLOT # 135 LOT # 37 (A)

Mr. Cieplik is responsible for the consistent adherence to the required State and Local codes and is given the authorization to make the necessary decisions to ensure compliance.

If there are any questions regarding this letter, or its intent, please contact me for clarification.

Sincerely,

David A. Cabral

Five Star Surgical, Inc. / Zenith Ventures, LLC