

PERMIT NO.

23306



CITY OF NEW BEDFORD

SEWER AND/OR STORM DRAIN PERMIT

DATE... 11/19/02
EXP 11/19/03

This certifies that permission is granted to

JMP Development / John Pereira, 24 Jocelyn St. N.B. MA 02745
Property Owner Address Tel. (508) 998-2969

to connect a sewer and/or storm drain located at... Harwich St. (S.S.) 360' (+/-) E. / Belleville Ave.
Assessor's Plot... 119, Lot... 29/30, to the sewer and/or storm drain in... Harwich Street

to be laid in accordance with the conditions in this application and the City of New Bedford ordinances.

TYPE OF USE: ☒ RESIDENTIAL ☐ COMMERICAL ☐ INDUSTRIAL ☐ OTHER

If applicant other than actual property owner, attach Letter of Authorization from Property Owner

Name... N/A Tel... FEB 13 2003

Mailing Address... DEPT. OF PUBLIC WORKS NEW BEDFORD, MASS

The Bonded Contractor/Drain Layer authorized to perform this work is:

Carissa, RT 95 Haddam, Ct. NB MA 02740 (508) 993-9508
Name Address Tel.

Type of Pipe Required: PVC 52K 35

PERMIT EXPIRES ONE YEAR AFTER DATE OF ISSUE

- * Requires separate connections for sewage and storm drain where applicable. Storm water cannot be discharged to a sanitary sewer.
- * All work must be inspected and approved by a D.P.W. inspector before backfilling.
- * If this connection is to be part of a private service shared jointly with other building owners, attach copy of Recorded Joint Maintenance Agreement.
- * Permits can be issued to Industrial and/or Commercial Applicants only upon receipt and approval by the Commissioner of Public Works of required plans and supplemental information.
- * In addition, a City-issued Industrial User Discharge Permit and/or a Sewer Extension/Connection Permit issued by the Commonwealth of Massachusetts D.E.P. shall be required by the City for Industrial Discharge into the sewer system.

Industrial User Discharge Permit No. Date

Comm. Mass. Sewer Conn./Ext. Permit No. Date

A Filing and Inspection Fee of \$150.00 plus an Entrance Fee of \$... where applicable, must accompany this application.

Bank # Citizens Bank Check # 1432 Date: 11/20/02 Receipt # 4479

Other requirements: Inspection Only - Connect to 10" S.D. and 8" S.D. in center of street. Refer to previous site plan.

☒ Sewer

Connection made to

Part of jointly-shared private line ☐ Yes ☒ No

☒ Storm Drain

Applicant agrees to abide by the above terms, as well as all pertinent ordinances of the City of New Bedford, and such other special rules as the Commissioner of Public Works may deem necessary

Lawrence D. Williams
Commissioner of Public Works

Signature of Property Owner or Representative


INSPECTOR'S REPORT

INSPECTED BY: JOSEPH MARTIN
DATE: 1/10/03
COMMENTS: Inspected by Joseph Martin - Sewer & storm connected.

☒ APPROVED ☐ DISAPPROVED

Signature of Joseph Martin

SIGNATURE

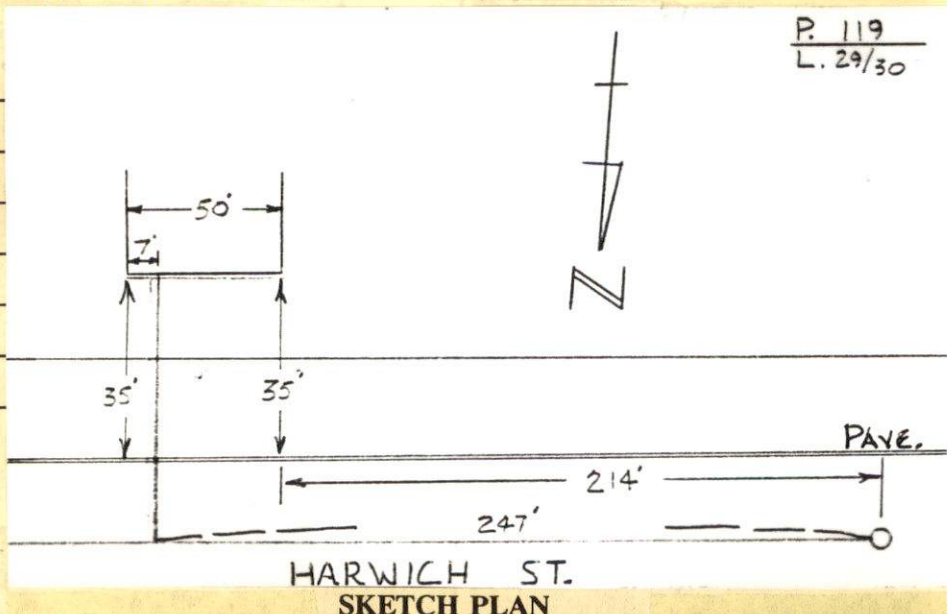

P. 119
L. 29/30

PERMIT NO.

23306



CITY OF NEW BEDFORD

SEWER AND/OR STORM DRAIN PERMIT

DATE 11/19/02
EXP 11/19/03

This certifies that permission is granted to

JMP Development / John Pereira 24 Jocelyn St. N.B. MA 02745
Property Owner Address Tel. (508) 998-2969
to connect a sewer and/or storm drain located at Horwich St. (S.S.) 360' E. Belleville Ave.
Assessor's Plot 119, Lot 29/30, to the sewer and/or storm drain in Horwich Street

to be laid in accordance with the conditions in this application and the City of New Bedford ordinances.

TYPE OF USE: ☒ RESIDENTIAL ☐ COMMERCIAL ☐ INDUSTRIAL ☐ OTHER

3306PD

If applicant other than actual property owner, attach Letter of Authorization from Property Owner.

Name N/A Tel.

Mailing Address

The Bonded Contractor/Drain Layer authorized to perform this work is:

Carissa RT 915 Hathaway Rd. NB MA 02740 (508) 993-2508
Name Address Tel.

Type of Pipe Required: PVC SDR 35

PERMIT EXPIRES ONE YEAR AFTER DATE OF ISSUE

- * Requires separate connections for sewage and storm drain where applicable. Storm water cannot be discharged to a sanitary sewer.
- * All work must be inspected and approved by a D.P.W. inspector before backfilling.
- * If this connection is to be part of a private service shared jointly with other building owners, attach copy of Recorded Joint Maintenance Agreement.
- * Permits can be issued to Industrial and/or Commercial Applicants only upon receipt and approval by the Commissioner of Public Works of required plans and supplemental information.
- * In addition, a City-issued Industrial User Discharge Permit and/or a Sewer Extension/Connection Permit issued by the Commonwealth of Massachusetts D.E.P. shall be required by the City for Industrial Discharge into the sewer system.

Industrial User Discharge Permit No. Date

Comm. Mass. Sewer Conn./Ext. Permit No. Date

A Filing and Inspection Fee of \$150.00 plus an Entrance Fee of \$ where applicable, must accompany this application.

Bank # Citizens Bank Check # 1432 Date: 11/20/02 Receipt # 4479

Other requirements: Inspection Only - Connect to 10" S.D. and 8" S. in center of street. Owner to provide site plan.

Connection made to ☒ Sewer ☒ Storm Drain Part of jointly-shared private line ☐ Yes ☒ No

FOR INSPECTION ONLY, A 24 HOUR NOTICE IS REQUIRED AND THE CONTRACTOR/APPLICANT IS REQUIRED TO NOTIFY THE ENGINEERING DIVISION AT 979-1527

Applicant agrees to abide by the above terms, as well as all pertinent ordinances of the City of New Bedford, and such other special rules as the Commissioner of Public Works may deem necessary

Lawrence D. Worden
Commissioner of Public Works

Signature of Property Owner or Representative

INSPECTOR'S REPORT

INSPECTED BY:

DATE:

COMMENTS:

☐ APPROVED ☐ DISAPPROVED

SIGNATURE

SKETCH PLAN

