

PERMIT NO. 23313



CITY OF NEW BEDFORD

DATE 12/16/02
EXP 12/16/03

SEWER AND/OR STORM DRAIN PERMIT

This certifies that permission is granted to
Glen Basse 122 Truro St NB MA 02715 (508) 978-1044
Property Owner Address Tel.
to connect a sewer and/or storm drain located at Truro St #126 (S.S.) Burnsville Ave & River St.
Assessor's Plot 116, Lot 335, to the sewer and/or storm drain in Truro Street
to be laid in accordance with the conditions in this application and the City of New Bedford ordinances.

TYPE OF USE: ☒ RESIDENTIAL ☐ COMMERICAL ☐ INDUSTRIAL ☐ OTHER 220 GPD

If applicant other than actual property owner, attach Letter of Authorization from Property Owner.

Name East Coast Homes Tel. (508) 678-5910
Mailing Address 485 N. Plain St Fall River MA 02720

The Bonded Contractor/Drain Layer authorized to perform this work is:
Will call us. Tim Valtori Construction Fall River MA 508-328-4719
Name Address Tel.

Type of Pipe Required: PVC 54x35
PERMIT EXPIRES ONE YEAR AFTER DATE OF ISSUE
RECEIVED APR 04 2003
DEPT. OF PUBLIC WORKS
NEW BEDFORD, MASS

- * Requires separate connections for sewage and storm drain where applicable. Storm water cannot be discharged to a sanitary sewer.
- * All work must be inspected and approved by a D.P.W. inspector before backfilling.
- * If this connection is to be part of a private service shared jointly with other building owners, attach copy of Recorded Joint Maintenance Agreement.
- * Permits can be issued to Industrial and/or Commercial Applicants only upon receipt and approval by the Commissioner of Public Works of required plans and supplemental information.
- * In addition, a City-issued Industrial User Discharge Permit and/or a Sewer Extension/Connection Permit issued by the Commonwealth of Massachusetts D.E.P. shall be required by the City for Industrial Discharge into the sewer system.

Industrial User Discharge Permit No. Date
Comm. Mass. Sewer Conn./Ext. Permit No. Date

A Filing and Inspection Fee of \$150.00 plus an Entrance Fee of \$ where applicable, must accompany this application.

Bank # Bank of Fall River Check # 3630 Date: 12/16/02 Receipt # 4489

Other requirements: Inspection Only - Connecting to 48"x60" S.D. w/yl branch and to 8" S. w/yl branch available, per copy of attached sewer layout plan 2746.

☒ Sewer
Connection made to ☒ Storm Drain Part of jointly-shared private line ☐ Yes ☒ No

Applicant agrees to abide by the above terms, as well as all pertinent ordinances of the City of New Bedford, and such other special rules as the Commissioner of Public Works may deem necessary


Lawrence D. Wondolowski Commissioner of Public Works
Signature of Property Owner or Representative

INSPECTOR'S REPORT

INSPECTED BY: JOSEPH MARTIN
DATE: 3/17/03
COMMENTS: Large 48"x60" concrete surface drain (over 8" sewer w/stub). See sewer layout plan 2746.
(Plotted 4/9/03 ASR.)

☒ APPROVED ☐ DISAPPROVED

Signature of Joseph Martin
SIGNATURE

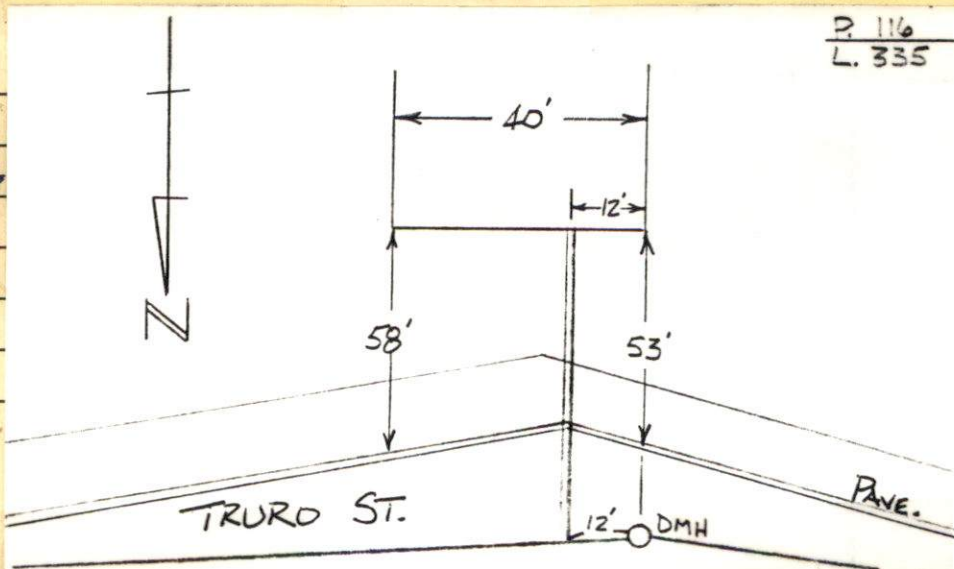

SKETCH PLAN

PERMIT NO.

23313



CITY OF NEW BEDFORD

DATE 12/16/02

EXP 12/16/03

SEWER AND/OR STORM DRAIN PERMIT

This certifies that permission is granted to

Glenn Bessie 172 Truro St. N.B. MA 02745 (308) 998-1044
Property Owner Address Tel.

to connect a sewer and/or storm drain located at Truro St. #126 (S.S.) Bldg. Kellenville Ave. & River Rd. Street
Assessor's Plot 116, Lot 335, to the sewer and/or storm drain in Truro

to be laid in accordance with the conditions in this application and the City of New Bedford ordinances.

TYPE OF USE: ☒ RESIDENTIAL ☐ COMMERCIAL ☐ INDUSTRIAL ☐ OTHER

220 GPD

If applicant other than actual property owner, attach Letter of Authorization from Property Owner.

Name East Coast Homes Tel. (508) 678-5910

Mailing Address 485 N. Main St. Fall River MA 02720

The Bonded Contractor/Drain Layer authorized to perform this work is:

Will call us. Tim Valton Construction Fall River MA 508 328-4719
Name Address Tel.

Type of Pipe Required: PVC SDC 35

PERMIT EXPIRES ONE YEAR AFTER DATE OF ISSUE

* Requires separate connections for sewage and storm drain where applicable. Storm water cannot be discharged to a sanitary sewer.

* All work must be inspected and approved by a D.P.W. inspector before backfilling.

* If this connection is to be part of a private service shared jointly with other building owners, attach copy of Recorded Joint Maintenance Agreement.

* Permits can be issued to Industrial and/or Commercial Applicants only upon receipt and approval by the Commissioner of Public Works of required plans and supplemental information.

* In addition, a City-issued Industrial User Discharge Permit and/or a Sewer Extension/Connection Permit issued by the Commonwealth of Massachusetts D.E.P. shall be required by the City for Industrial Discharge into the sewer system.

Industrial User Discharge Permit No. Date.

Comm. Mass. Sewer Conn./Ext. Permit No. Date.

A Filing and Inspection Fee of \$150.00, plus an Entrance Fee of \$ where applicable, must accompany this application.

Bank # Bank of Fall River Check # 3630 Date: 12/16/02 Receipt # 4489

Other requirements: Inspection Only - Connecting to 48"x60" S.D. wyl. brand and to 8" S. wyl. brand available, per copy of attached sewer layout plan 2746.

☒ Sewer

Connection made to Part of jointly-shared private line ☐ Yes ☒ No

☒ Storm Drain

Applicant agrees to abide by the above terms, as well as all pertinent ordinances of the City of New Bedford, and such other special rules as the Commissioner of Public Works may deem necessary

Lawrence D. Warden / for
Commissioner of Public Works

Signature of Property Owner or Representative

INSPECTOR'S REPORT

INSPECTED BY:

DATE:

COMMENTS:

☐ APPROVED

☐ DISAPPROVED

SIGNATURE

SKETCH PLAN

3-00



Station	Dist	Dir	Lat	Long	Alt	Remarks
1	1.0	N	34° 30'	119° 30'	4000	Top of hill
2	1.5	N	34° 30'	119° 30'	4000	Top of hill
3	2.0	N	34° 30'	119° 30'	4000	Top of hill
54	27.5	N	34° 30'	119° 30'	4000	Top of hill



CITY OF NEW BEDFORD
MASSACHUSETTS

DEPARTMENT OF PUBLIC WORKS
ENGINEERING DIVISION

133 WILLIAM STREET, ROOM 303
NEW BEDFORD, MA 02740

Tel: (508) 979-1527

Fax: (508) 961-3043

To Whom It May Concern:

I, Glen Besse of 122 Truro St. New Bedford MA, being
(Name) (Mailing Address)

Owner of property located at 126 Truro St. New Bedford MA

Plot 118, Lot 335, hereby agree to allow Gen Dennis J
East Coast Home (Name)
485 W. Main St. Fall River MA to act on my behalf including affixing my
(Mailing Address)

signature in securing permit for:

☒ Sewer/Drain Service Permits
☒ Water Service Permits
☒ Driveway Installation Permits
☒ Sidewalk Installation Permits

I further agree to conform to, and abide by, all City rules and ask regulations applicable to the permit (s) being applied for:

Name Glen Besse
(Signature)

122 Truro Street
(Address) New Bedford MA

12/02/02 508 - 998 - 1044
(Date) (Telephone number)

Foundation Permit
1842-02
10/31/02
Dorothy Brown