

PERMIT NO.

23323



CITY OF NEW BEDFORD

SEWER AND/OR STORM DRAIN PERMIT

DATE 1/22/03
EXP. 1/22/04

This certifies that permission is granted to c/o Mark W. White, Pres.
Phillips Rd. Inc. 867 Middle Rd. Acushnet, Ma. 02743
Property Owner Address Tel. (508) 763-8868
to connect a sewer and/or storm drain located at Stephanie Place (E.S.) Across from Monica's Way
Assessor's Plot. 132J, Lot. 123+98, to the sewer and/or storm drain in Stephanie Place Street
to be laid in accordance with the conditions in this application and the City of New Bedford ordinances.

TYPE OF USE: ☒ RESIDENTIAL ☐ COMMERCIAL ☐ INDUSTRIAL ☐ OTHER

330 GPD

If applicant other than actual property owner, attach Letter of Authorization from Property Owner.

Name Long Realty, Inc. / c/o Ralph K. Mulford Atty Tel. (508) 965-8355 X-12
Mailing Address 158 Charles McCombs Blvd. NB Ma.

The Bonded Contractor/Drain Layer authorized to perform this work is:

D.W. White 867 Middle Rd. Acushnet, Ma. 02743 (508) 763-8868
Name Address Tel.

Type of Pipe Required: PVC SDR 35

PERMIT EXPIRES ONE YEAR AFTER DATE OF ISSUE

- * Requires separate connections for sewage and storm drain where applicable. Storm water cannot be discharged to a sanitary sewer.
- * All work must be inspected and approved by a D.P.W. inspector before backfilling.
- * If this connection is to be part of a private service shared jointly with other building owners, attach copy of Recorded Joint Maintenance Agreement.
- * Permits can be issued to Industrial and/or Commercial Applicants only upon receipt and approval by the Commissioner of Public Works of required plans and supplemental information.
- * In addition, a City-issued Industrial User Discharge Permit and/or a Sewer Extension/Connection Permit issued by the Commonwealth of Massachusetts D.E.P. shall be required by the City for Industrial Discharge into the sewer system.

Industrial User Discharge Permit No. N/A Date _____
Comm. Mass. Sewer Conn./Ext. Permit No. N/A Date _____

A Filing and Inspection Fee of \$ 150.00, plus an Entrance Fee of \$ _____ where applicable, must accompany this application.

Bank # Compass Bank Check # 28109 Date: 1/22/03 Receipt # 4504

Other requirements: Inspection Only - Dankers Valley Subdivision & Woodford Estates Subdivision to 8" Sewer & 12" RCP S.D. in Stephanie Place
☒ Sewer ☒ Storm Drain
* Larry approved issuance of this sewer & storm permit w/ lots being combined.
Connection made to Part of jointly-shared private line ☐ Yes ☒ No


Applicant agrees to abide by the above terms, as well as all pertinent ordinances of the City of New Bedford, and such other special rules as the Commissioner of Public Works may deem necessary

Lawrence D. Worden MHS
Commissioner of Public Works

Chip Mulford
Signature of Property Owner or Representative

INSPECTOR'S REPORT

INSPECTED BY: _____
DATE: _____
COMMENTS: _____

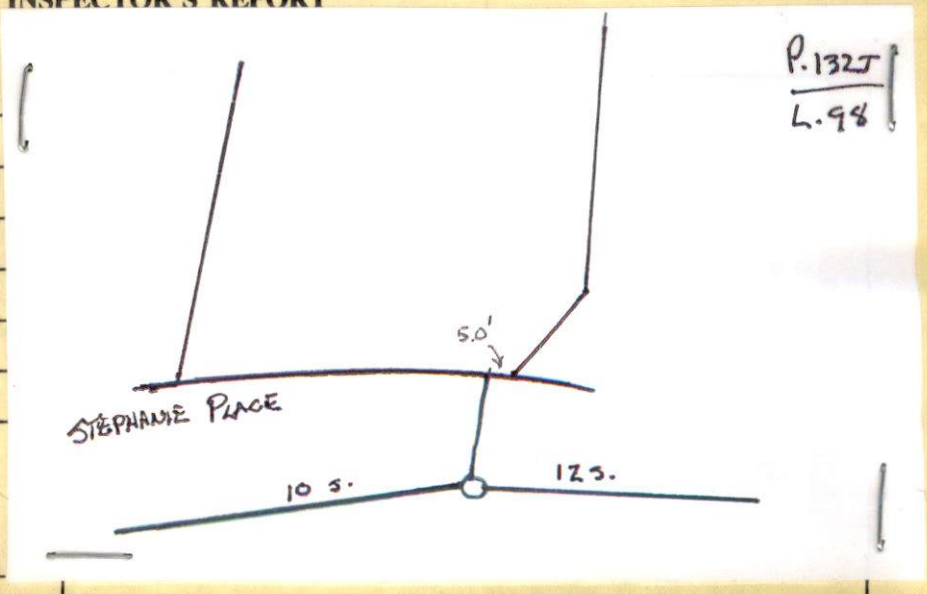

☐ APPROVED ☐ DISAPPROVED

SIGNATURE

SKETCH PLAN

PERMIT NO.

23323



CITY OF NEW BEDFORD

SEWER AND/OR STORM DRAIN PERMIT

DATE 1/22/03
EXP. 1/22/04

This certifies that permission is granted to c/o Mark W. White, Pres.
Phillips Rd. Inc. 867 Middle Rd. Acushnet Ma. 02743
Property Owner Address Tel. (508) 763-8868
to connect a sewer and/or storm drain located at Stephanie Place (E.S.) Across from Monica's Way
Assessor's Plot. 132T, Lot. 123+98, to the sewer and/or storm drain in Stephanie Place Street
to be laid in accordance with the conditions in this application and the City of New Bedford ordinances.

TYPE OF USE: ☒ RESIDENTIAL ☐ COMMERCIAL ☐ INDUSTRIAL ☐ OTHER

330 GPD

If applicant other than actual property owner, attach Letter of Authorization from Property Owner.

Name Long Realty, Inc. / c/o Ralph K. Mulford Atty Tel. (508) 965-8355 X-12
Mailing Address 158 Charles McCombs Blvd. NB MA

The Bonded Contractor/Drain Layer authorized to perform this work is:

D.W. White 867 Middle Rd. Acushnet, Ma. 02743 (508) 763-8868
Name Address Tel.

Type of Pipe Required: PVC SDR 35

PERMIT EXPIRES ONE YEAR AFTER DATE OF ISSUE

- * Requires separate connections for sewage and storm drain where applicable. Storm water cannot be discharged to a sanitary sewer.
- * All work must be inspected and approved by a D.P.W. inspector before backfilling.
- * If this connection is to be part of a private service shared jointly with other building owners, attach copy of Recorded Joint Maintenance Agreement.
- * Permits can be issued to Industrial and/or Commercial Applicants only upon receipt and approval by the Commissioner of Public Works of required plans and supplemental information.
- * In addition, a City-issued Industrial User Discharge Permit and/or a Sewer Extension/Connection Permit issued by the Commonwealth of Massachusetts D.E.P. shall be required by the City for Industrial Discharge into the sewer system.

Industrial User Discharge Permit No. N/A Date _____
Comm. Mass. Sewer Conn./Ext. Permit No. N/A Date _____

A Filing and Inspection Fee of \$150.00, plus an Entrance Fee of \$_____ where applicable, must accompany this application.

Bank # Compass Bank Check # 28109 Date: 1/22/03 Receipt # 4504

Other requirements: Inspection Only - Dankon Valley Subdivision & Woodford Estates Subdivision to 8" Sewer & 12" RCP S.D. in Stephanie Place
☒ Sewer ☒ Storm Drain
* Larry approved issuance of this sewer & storm permit w/ lots being combined.
Connection made to Part of jointly-shared private line ☐ Yes ☒ No

Applicant agrees to abide by the above terms, as well as all pertinent ordinances of the City of New Bedford, and such other special rules as the Commissioner of Public Works may deem necessary

Lawrence D. Worden MHS
Commissioner of Public Works

Chip Mulford
Signature of Property Owner or Representative

INSPECTOR'S REPORT

INSPECTED BY: _____

DATE: _____

COMMENTS: _____

☐ APPROVED

☐ DISAPPROVED

SIGNATURE

SKETCH PLAN



CITY OF NEW BEDFORD
MASSACHUSETTS

DEPT. OF PUBLIC WORKS

133 WILLIAM STREET

LAWRENCE D. WORDEN
COMMISSIONER

To Whom It May Concern:

I, Long Realty Inc. 158 Charles McCombs Blvd, being
Name Mailing Address
owner of property located at VARIOUS LOCATIONS IN NEW BEDFORD

Plot _____, Lot _____, hereby agree to allow Robert K "Chip" Mulford,
Name

My Attorney, PO Box 517, FAIRHAVEN 02719 to act on my behalf,
Mailing Address

including affixing my signature, in securing permits for:

☒ Sewer/Drain Service Permits
☒ Water Service Permits
☒ Driveway Installation Permits
☒ Sidewalk Installation Permits

I further agree to confirm to, and abide by, all City rules and regulations applicable to the permits(s) being applied for.

**LONG BUILT
HOMES**

"Long" on Quality

CHIP MULFORD
CORPORATE COUNSEL &
LAND ACQUISITION

Cell: 508-965-8355
Fax: 508-995-3275

Website: www.longbulthomes.com
158 Charles McCombs Blvd., New Bedford, MA 02745

Robert K. Mulford
Print
Long Realty Inc
158 Charles McCombs Blvd
Address
New Bedford, MA 02745
March 2, 2002
Date

To Whom It May Concern:

Chip Mulford is Long Realty Inc.'s Corporate Attorney, and is authorized to act on the Corporation's behalf in securing permits and any and all other matters involving the DPW.

Robert F. Long
President - Long Realty Inc.

Phillips Road Inc.

**867 Middle Road
Acushnet, MA 02743**


(508) 763-4464

City of New Bedford
Various Departments
William Street
New Bedford, MA 02740

To Whom It May Concern:

This letter will certify that Long Realty Inc. has permission from Phillips Road Inc. to draw down the necessary permits and construct new homes on the lots comprising our Dawson Valley subdivision, which is off Phillips Road in New Bedford.

Sincerely,

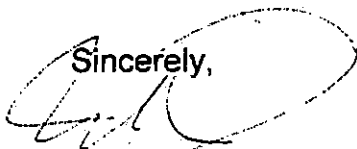

Mark W. White
President
Phillips Road Inc.